


DIMENSIONS FOR CRITICAL OFFSETS OR CLEARANCES SHOWN FOR CONVENIENCE, REFER TO STANDARD SHEETS FOR PLACEMENT GUIDELINES.

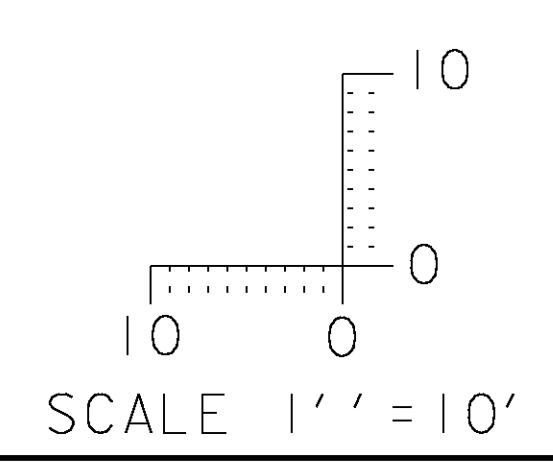

**CROSS SECTION SHEET 3**

PROJECT NAME: LYNDON - DERBY  
PROJECT NUMBER: IM IR 091-3(6)  
FILE NAME: z87a022xs.dgn  
PROJECT LEADER: CRB  
DESIGNED BY: DAM  
CLD REF. NO.: 08-0159  
PLOT DATE: 5/7/2009  
DRAWN BY: NLL  
CHECKED BY: BDB  
SHEET 157 OF 160