


DIMENSIONS FOR CRITICAL OFFSETS OR CLEARANCES SHOWN FOR CONVENIENCE, REFER TO STANDARD SHEETS FOR PLACEMENT GUIDELINES.

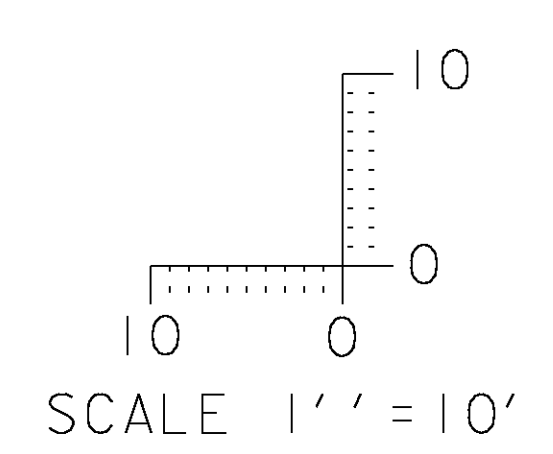

CROSS SECTION SHEET 5

PROJECT NAME: LYNDON - DERBY
PROJECT NUMBER: IM IR 091-3(6)
FILE NAME: z87a022xs.dgn
PROJECT LEADER: CRB
DESIGNED BY: DAM
CLD REF. NO.: 08-0159
PLOT DATE: 5/7/2009
DRAWN BY: NLL
CHECKED BY: BDB
SHEET 159 OF 160