


DIMENSIONS FOR CRITICAL OFFSETS OR CLEARANCES SHOWN FOR CONVENIENCE, REFER TO STANDARD SHEETS FOR PLACEMENT GUIDELINES.

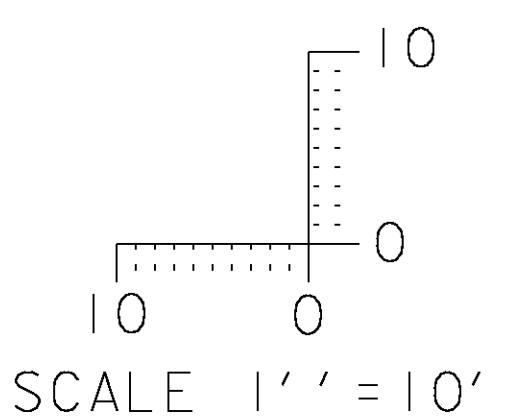

CROSS SECTION SHEET 6

PROJECT NAME:	LYNDON - DERBY
PROJECT NUMBER:	IM IR 091-3(6)
FILE NAME:	z87a022xs.dgn
PROJECT LEADER:	CRB
DESIGNED BY:	DAM
CLD REF. NO.:	08-0159
PLOT DATE:	5/7/2009
DRAWN BY:	NLL
CHECKED BY:	BDB
SHEET	160 OF 160

MODEL: 07