
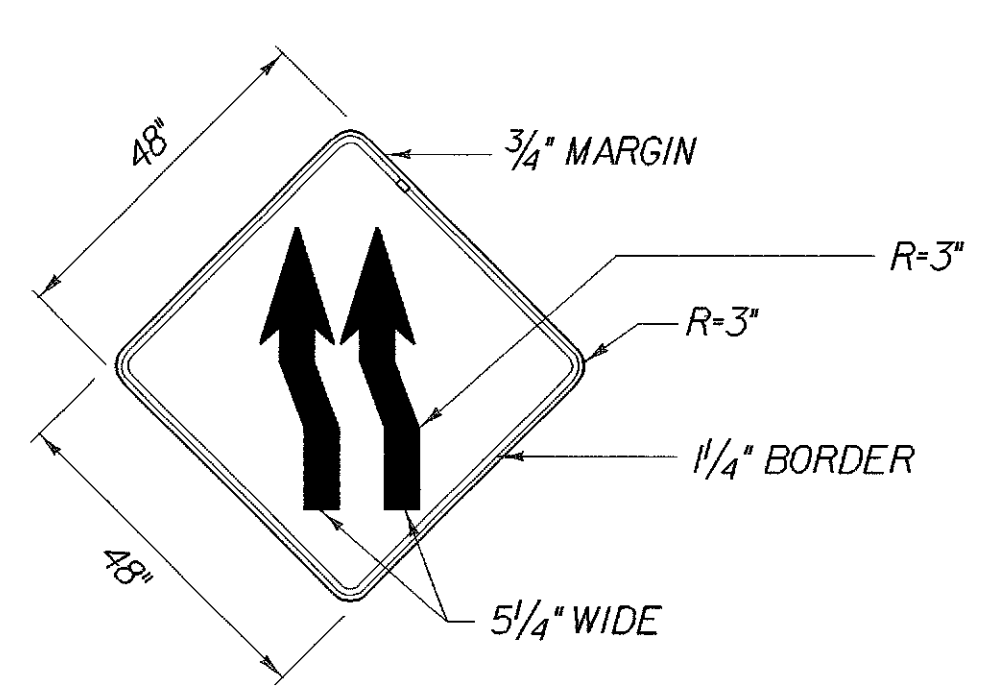



**BRIDGE 6 (MM 1J) - PHASE 2 NORTHBOUND**  
N.T.S.

**NOTES**

1. BRIDGE 6 SOUTHBOUND (PHASE 2) IS SIMILAR TO BRIDGE 6 NORTHBOUND (PHASE 2)
2. USE STD. E-103 IN CONJUNCTION WITH THESE DETAILS

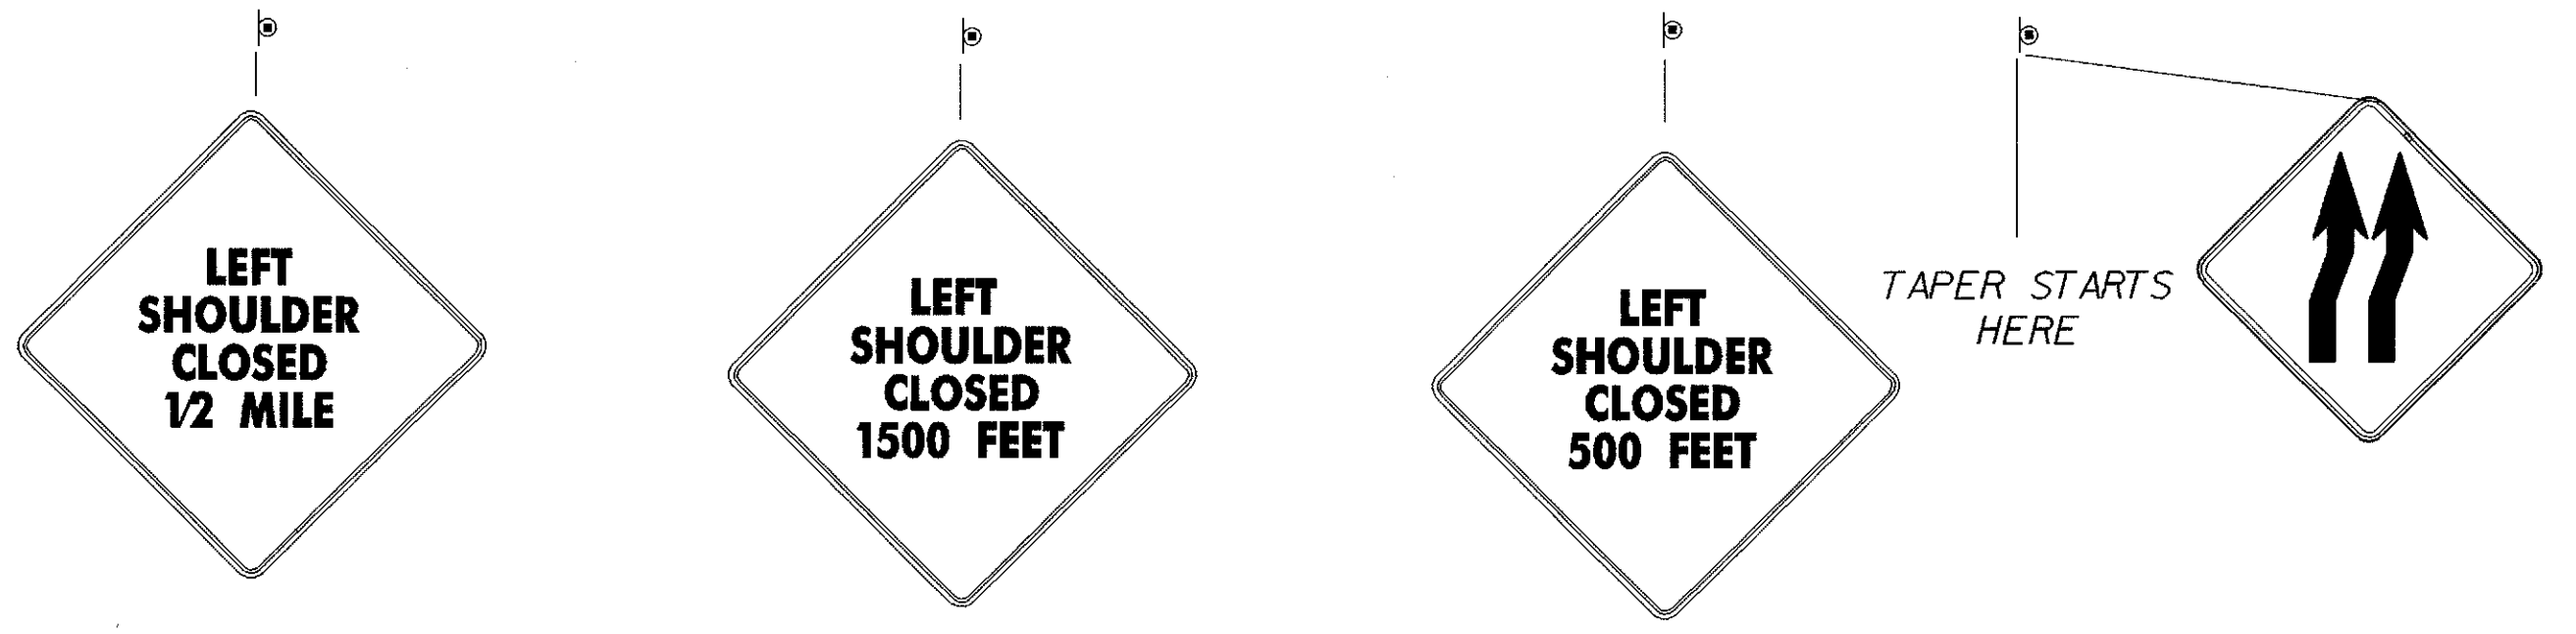

COLORS BLACK ON ORANGE  
(SEE STD. E-102 FOR ADDITIONAL INFORMATION)

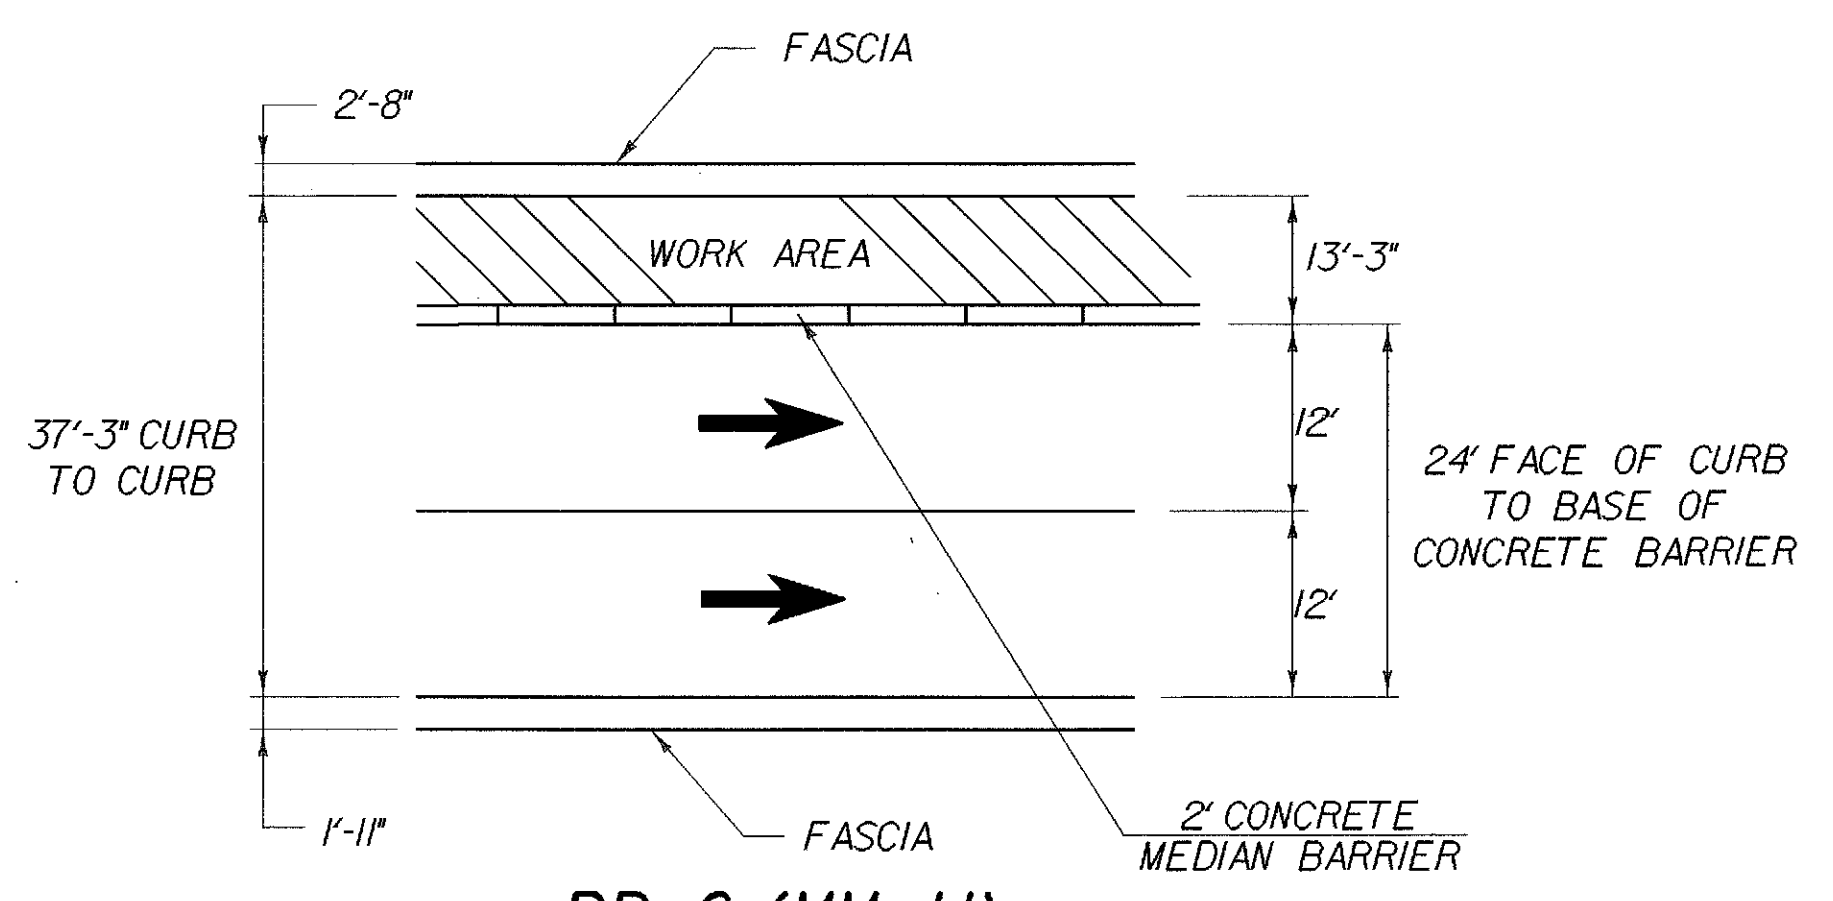

**BR 6 (MM 1J)  
LANE WIDTH AVAILABLE**  
N.T.S.

LEGEND	
	TEMPORARY DIRECTION OF FLOW
	ORIGINAL DIRECTION OF FLOW
	REFLECTORIZED PLASTIC DRUMS (STD. E-106)
	TYPE III BARRICADES (MOD.) SEE STD. E-107A
	PAVEMENT MARKING REMOVAL
	TEMPORARY TRAFFIC BARRIER
	EXISTING PAVEMENT MARKINGS
	EXISTING ROADWAY CENTERLINE
	TEMPORARY PAVEMENT MARKINGS

<b>STATE OF VERMONT AGENCY OF TRANSPORTATION</b>	
Town of <b>HARTFORD-SHARON-ROYALTON</b>	Bridge No. 6
Highway No. <b>189</b>	Log Sta.
	Surv. Sta.
<b>TRAFFIC CONTROL FOR BRIDGES 6 NORTHBOUND &amp; SOUTHBOUND (PHASE 2)</b>	
Designed By <b>C. MEUNIER</b>	Drawn By <b>M. PELOQUIN</b>
Checked By <b>C. MEUNIER</b> Date <b>11/98</b>	Bridge Design Supervisor <b>G.S. ROGERS</b> Date <b>11/98</b>
PROJECT <b>HARTFORD-SHARON-ROYALTON</b>	PROJECT NO. <b>1M IR 089-118</b>
I.G.C:\web62\cadd\11\ingcab\net\87a008\Structures\sa008trf.dgn sa008trf5J	
Bridge Sheet No. <b>BR 106</b>	Sheet <b>63</b> of <b>260</b>