


PLAN
Scale 1" = 20'

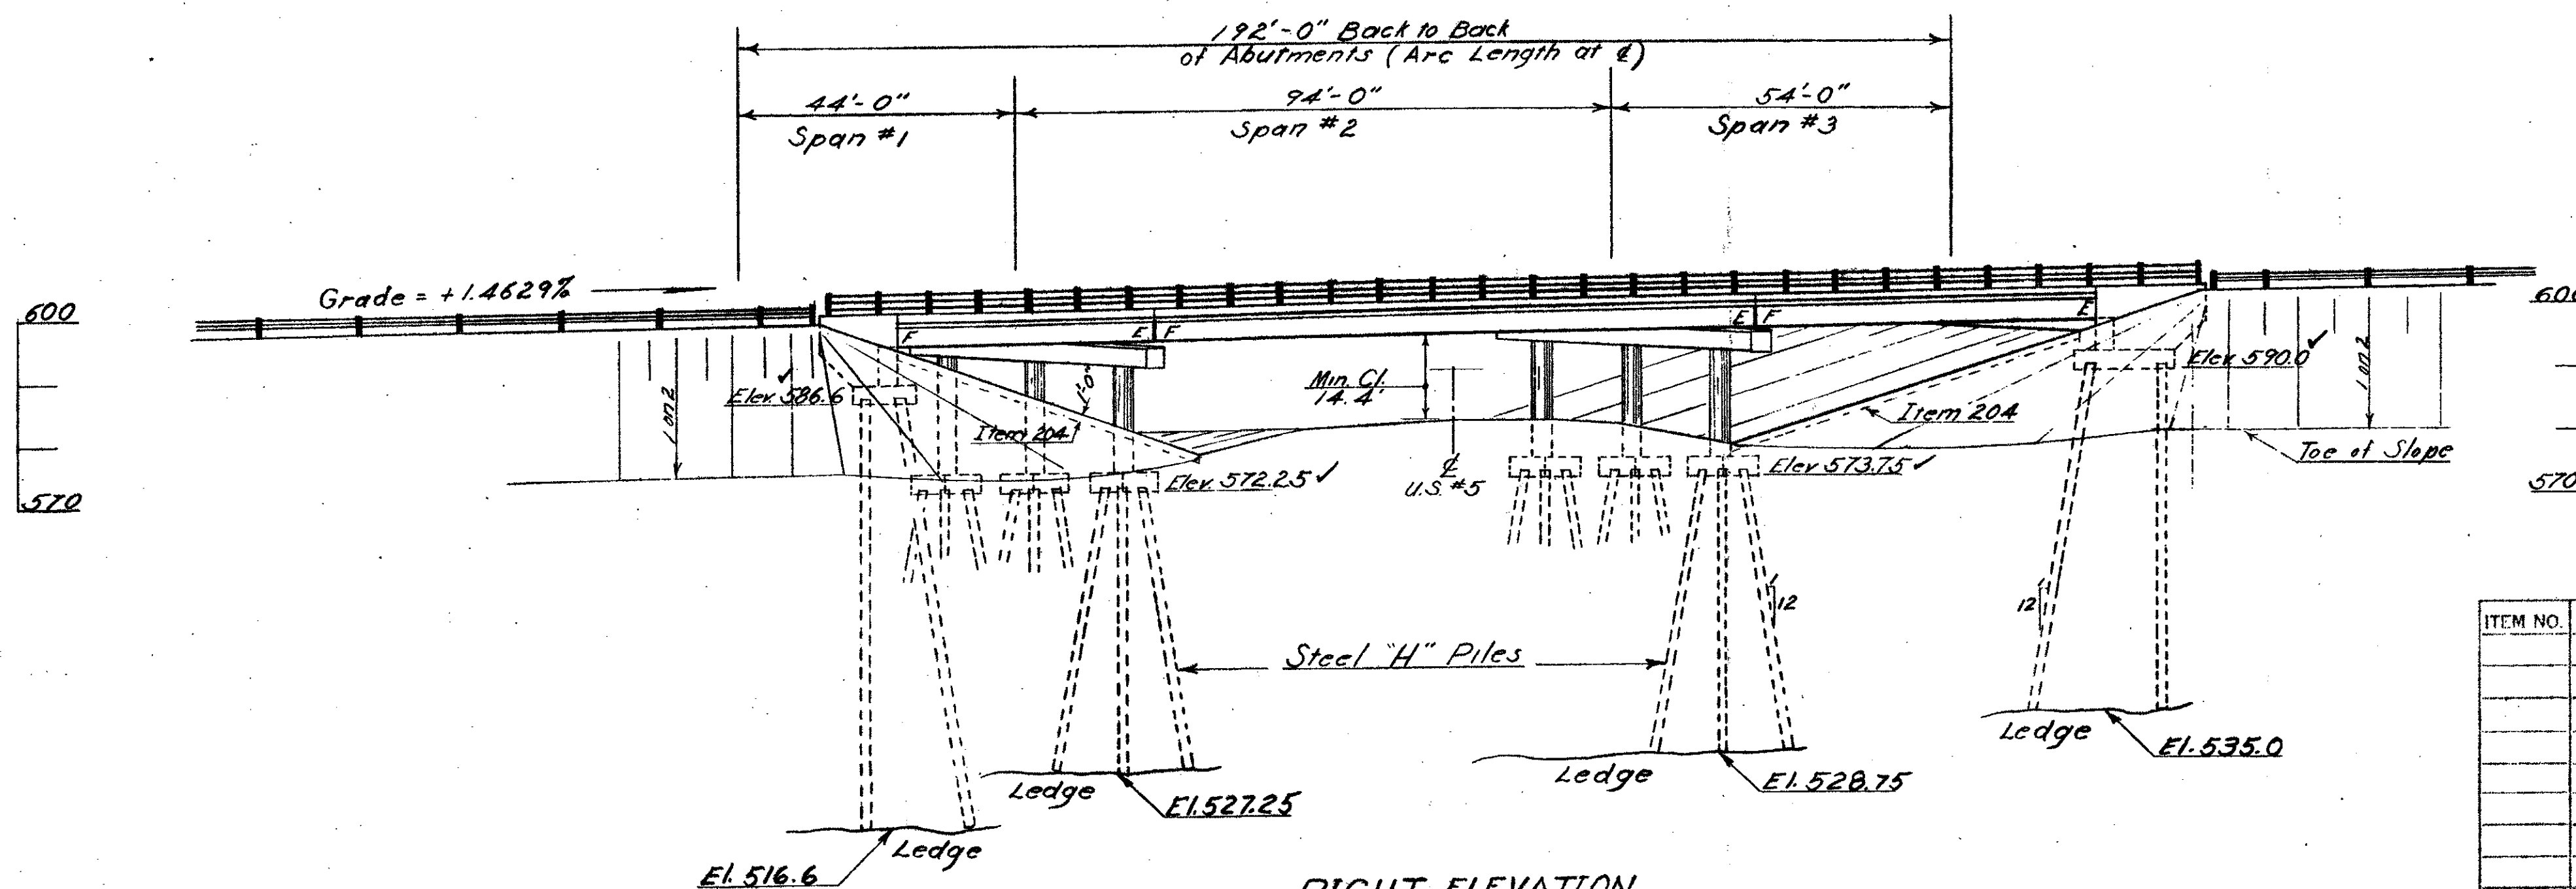

RIGHT ELEVATION
Scale 1" = 20'

WESTBOUND BRIDGE

BR #6

THIS SHEET IS FOR INFORMATION PURPOSES ONLY
HARTFORD-SHARON-ROYALTON IM IR 089-1(6)

BR 102 OF 124

ITEM NO.	ITEM	UNIT	NET	TOTAL	FINAL
	CHAN. EXCAV. OF EARTH	C. Y.			
	CHAN. EXCAV. OF ROCK	C. Y.			
	UNCLASS. CHAN. EXCAV.	C. Y.			
	STRUCT. EXCAV.	C. Y.			
	CONC. CLASS AA (MOD.)	C. Y.			
	CONC. CLASS B (MOD.)	C. Y.			
	REINF. STEEL	LBS.			
	ASPHALTIC-ASB. COATING	S. Y.			
	TREATED TIMBER PILING	L. F.			
	SPLICES FOR STEEL PILING	EA.			
	STEEL PILING	L. F.			
	UNTREATED TIMBER PILING	L. F.			

STATE OF VERMONT
DEPARTMENT OF HIGHWAYS

TOWN OF HARTFORD
ROUTE NO. 189 LOG STA. 65+50
INTERSTATE OVER U.S. #5
PLAN AND RIGHT ELEVATION (WB)
SCALE: 1" = 20'
SURVEYED BY Van Wogensen
D. R. Hallett CHECKED BY X

Bridge Sheet No. BR 139 Sheet 96 of 260