


EASTBOUND RAILING & CURB PLANS  
Scale: 1" = 10'-0"

- NOTES:**
1. For additional details of Bridge Railing see Std Sheets SB-R1-64 & SB-R2-65
  2. For additional details of Granite Curb see Std. Sheets SCB-D4-65 & SCB-D6-65.
  3. For additional Cover Pl. & Diaphragm Details, see Standard Sheet SCB-D7-65.

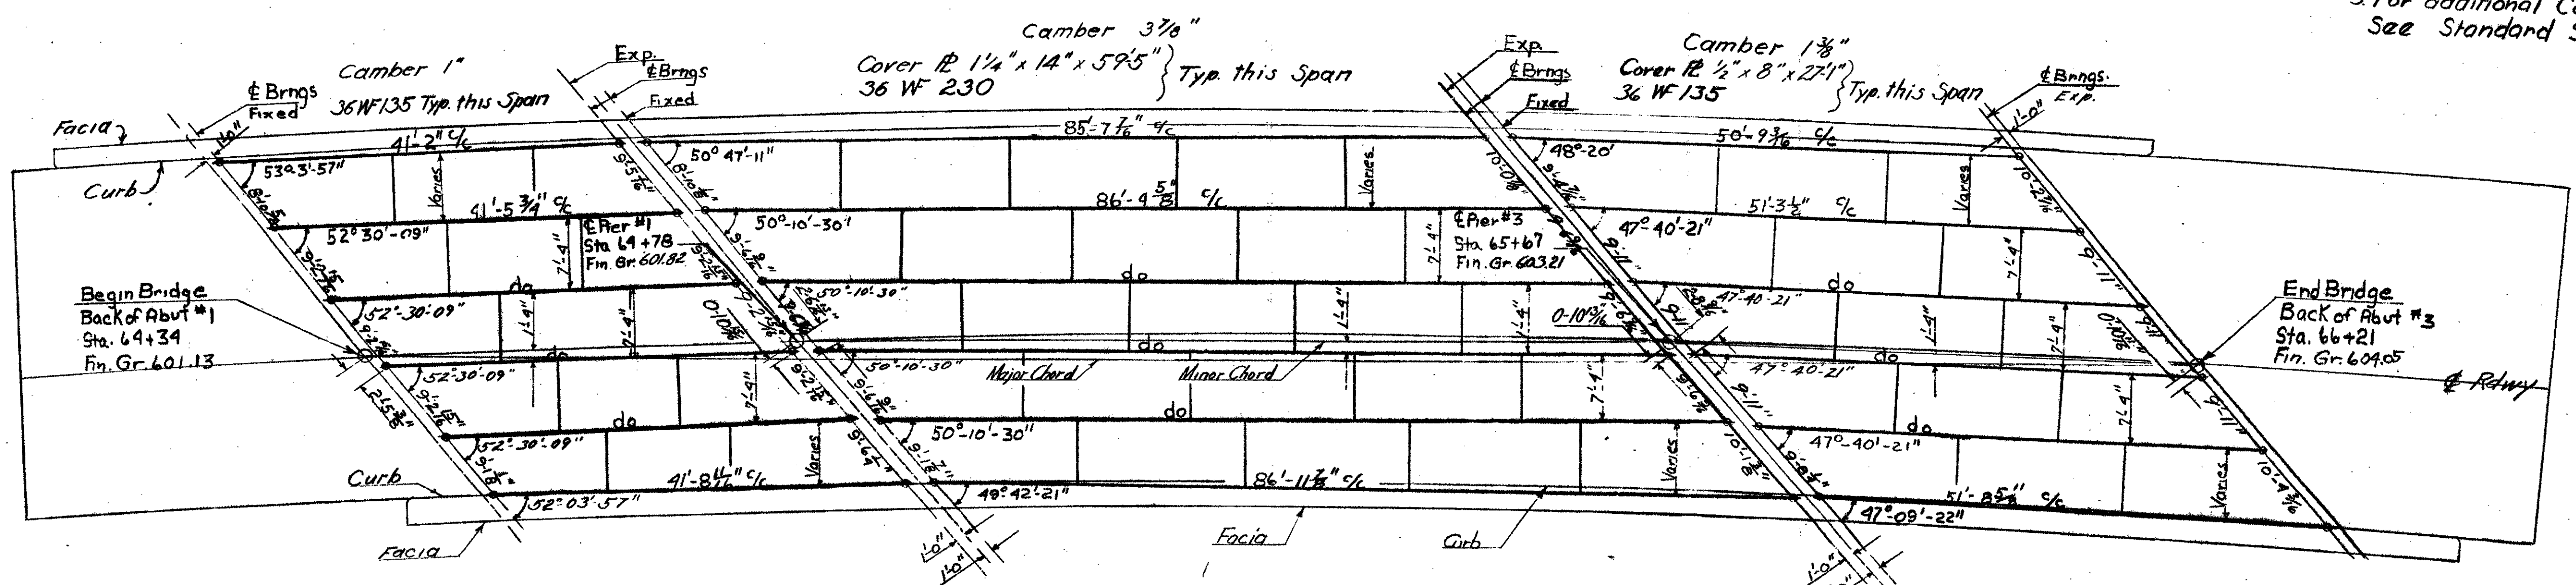

EASTBOUND BRIDGE FRAMING PLAN  
Scale 1" = 10'

THIS SHEET IS FOR INFORMATION PURPOSES ONLY  
HARTFORD-SHARON-ROYALTON IM 1R-089-1(0)

BR 107 OF 124

STATE OF VERMONT  
DEPARTMENT OF HIGHWAYS

TOWN OF Hartford

ROUTE NO. I-89 LOG STA.     

EAST BOUND I 89 over US 55

Framing Plan; Curve, Curb, & Railing Layouts

SCALE A as Noted

SURVEYED BY     

Bridge Sheet No. BR 140 Sheet 97 of 200

BR #6