


- NOTES**
1. For additional details of Bridge Railing see Std. Sheets SB-R1-64 & SB-R2-65
  2. For additional details of Granite Curb see Std. Sheets SCB-DA-65 & SCB-DG-65
  3. For Additional Cover Pl. & Diaphragm Details, See Standard Sheet SCB-D7-65.

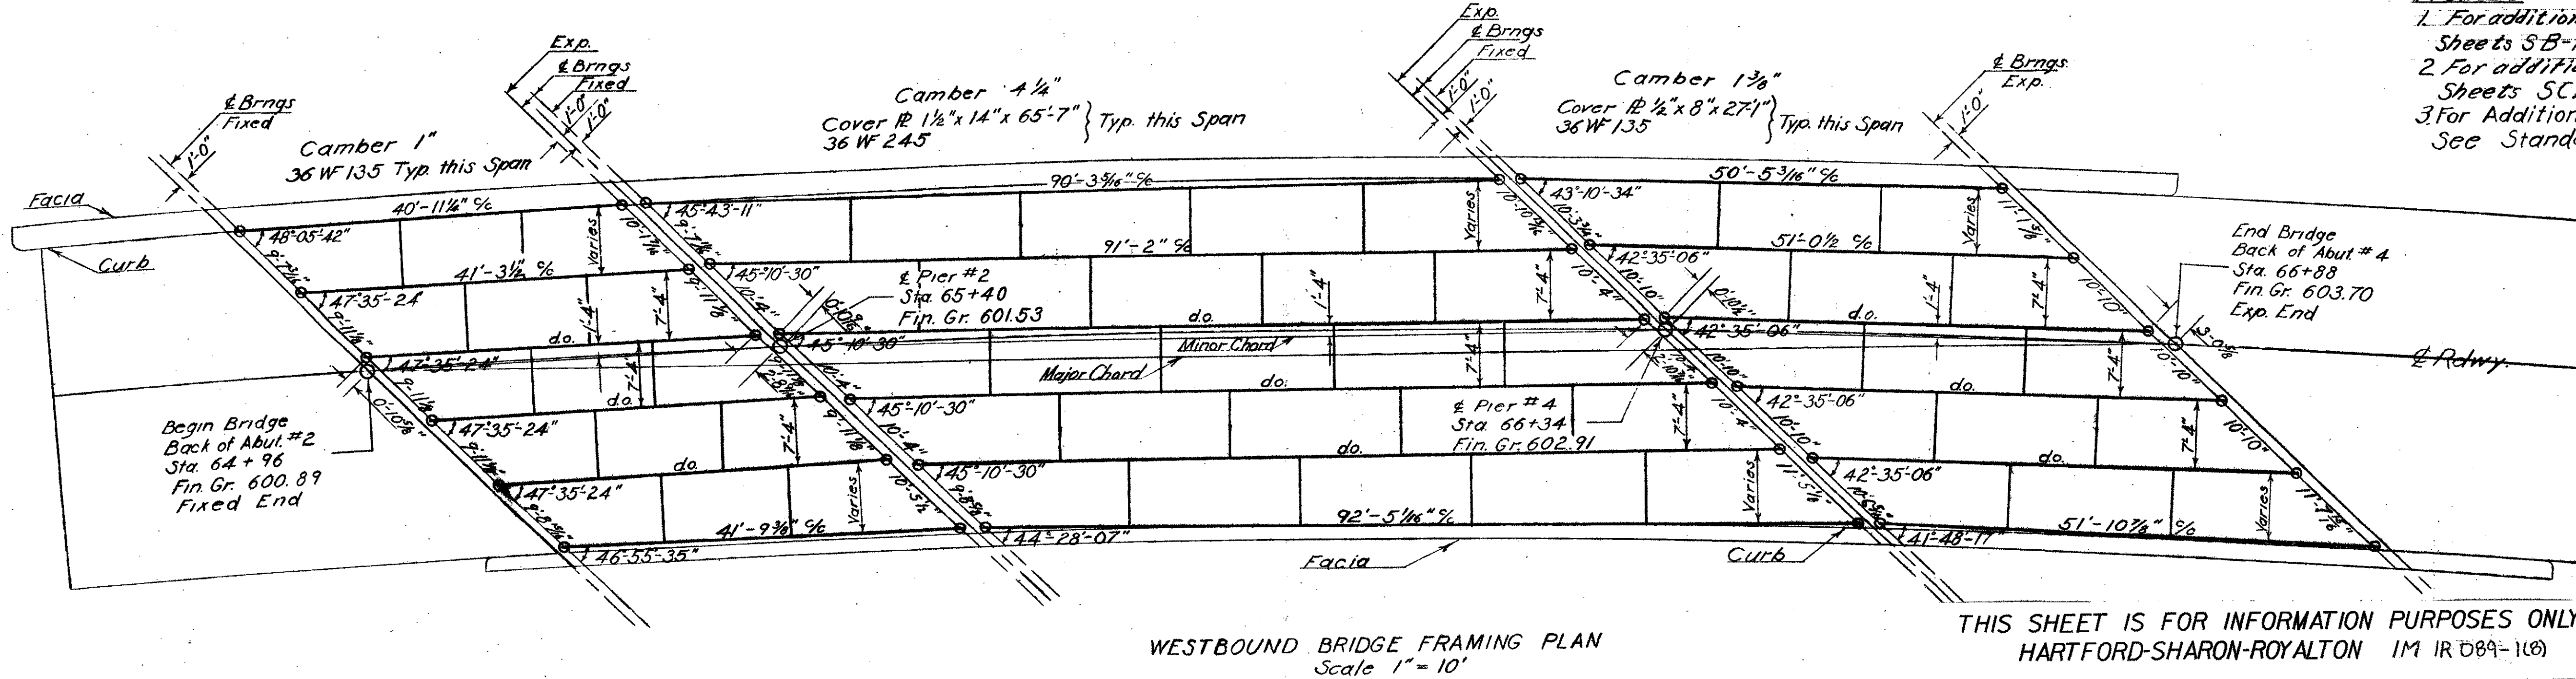

BR #6

BR 108 OF 124

STATE OF VERMONT  
DEPARTMENT OF HIGHWAYS

TOWN OF Hartford

ROUTE NO. 189 LOG STA. WESTBOUND 189 over US#5

Framing Plan, Curve, Curb, & Railing Layouts

SCALE As Noted

Bridge Sheet No. BR 141 Sheet 98 of 260

THIS SHEET IS FOR INFORMATION PURPOSES ONLY  
HARTFORD-SHARON-ROYALTON IM IR 089-1(0)