

PLAN

GENERAL NOTES:-

- 1- Elevation datum is sea level based on nearest U.S. Government vertical control.
- 2- For additional notes see SCB-D1-65



LIST OF SHEETS:-

- BR. 200 - Plan and Elevation
- 201 - Bridge Quantity Sheet
- 202 - Preliminary Information Sheet
- 203 - Borings
- 204 - Superstructure Spans 1 & 2
- 205 - Superstructure Spans 3 & 4
- 206 - Approach Slab No. 1
- 207 - Approach Slab No. 2
- 208 - Abutment No. 1
- 209 - Abutment No. 2
- 210 - Pier No. 1
- 211 - Pier No. 2
- 212 - Pier No. 3
- BR. 213-214 - Reinforcing Steel Schedules

STANDARD SHEETS

- G-30
- SCB-30-65
- SCB-D1 THRU D9-65
- SB-R1-64 Sheets 1 and 2
- SB-R3-64

Bridge # 8

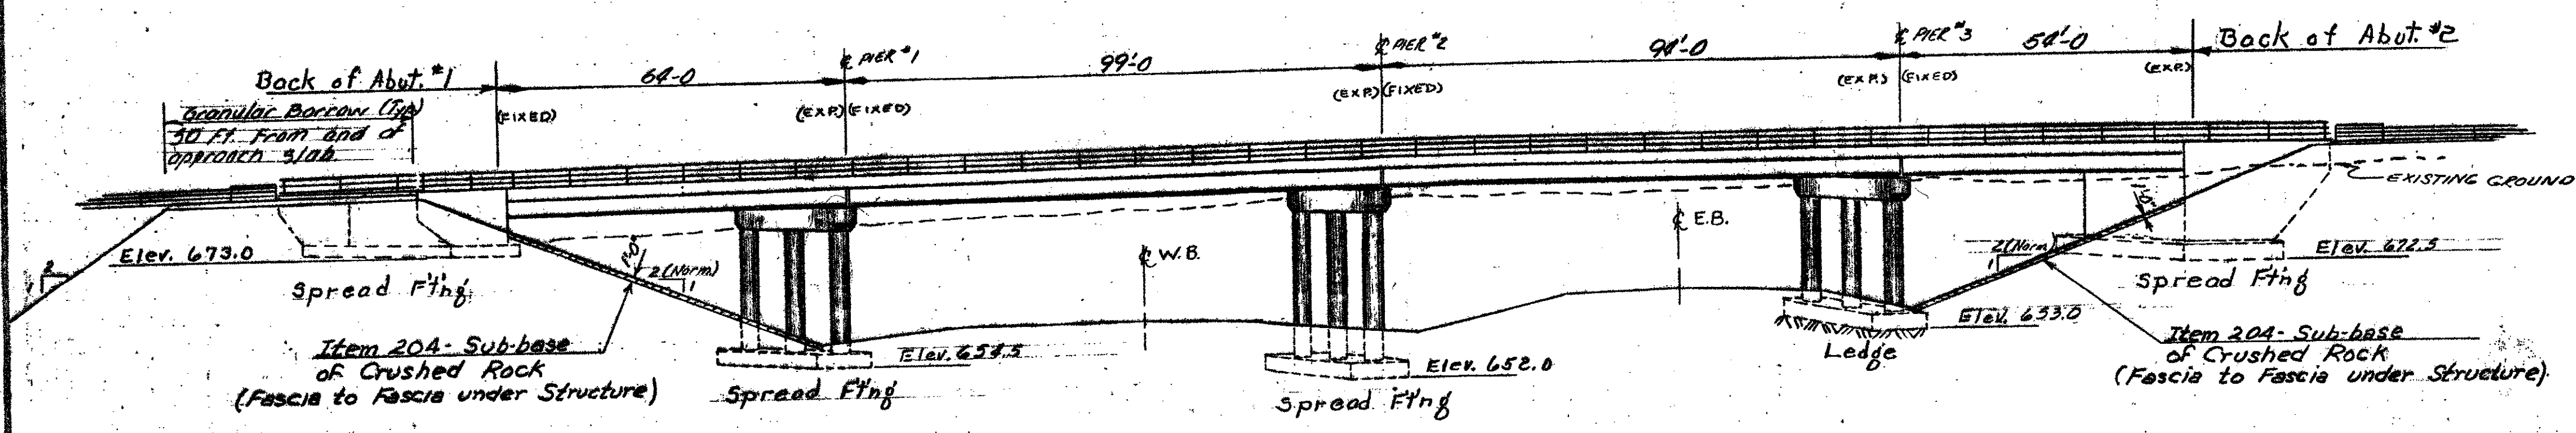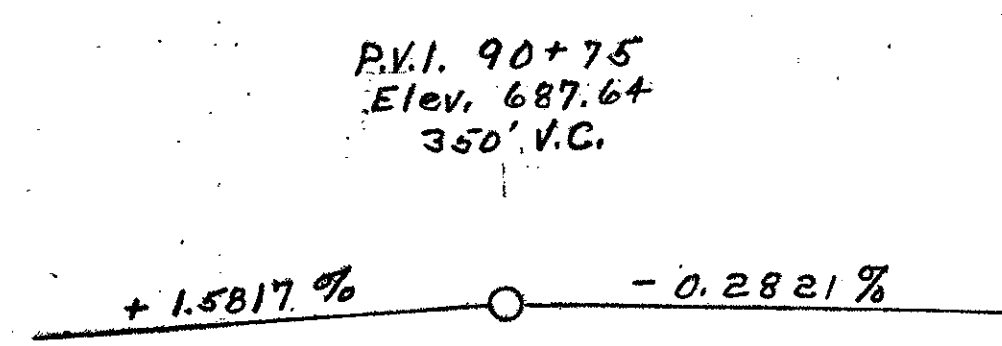

ELEVATION

BR. 200 OF 214

STATE OF VERMONT
DEPARTMENT OF HIGHWAYS

TOWN OF HARTFORD

ROAD NO. U.S. 4 BRIDGE NO. U.S. 4 OVER I-89

PLAN & ELEVATION

SCALE 1" = 20'-0"

SURVEYED BY _____

THIS SHEET IS FOR INFORMATION PURPOSES ONLY
HARTFORD-SHARON-ROYALTON IM 1R 089-1(6)