



Curve Layout  
Scale: 1" = 20'

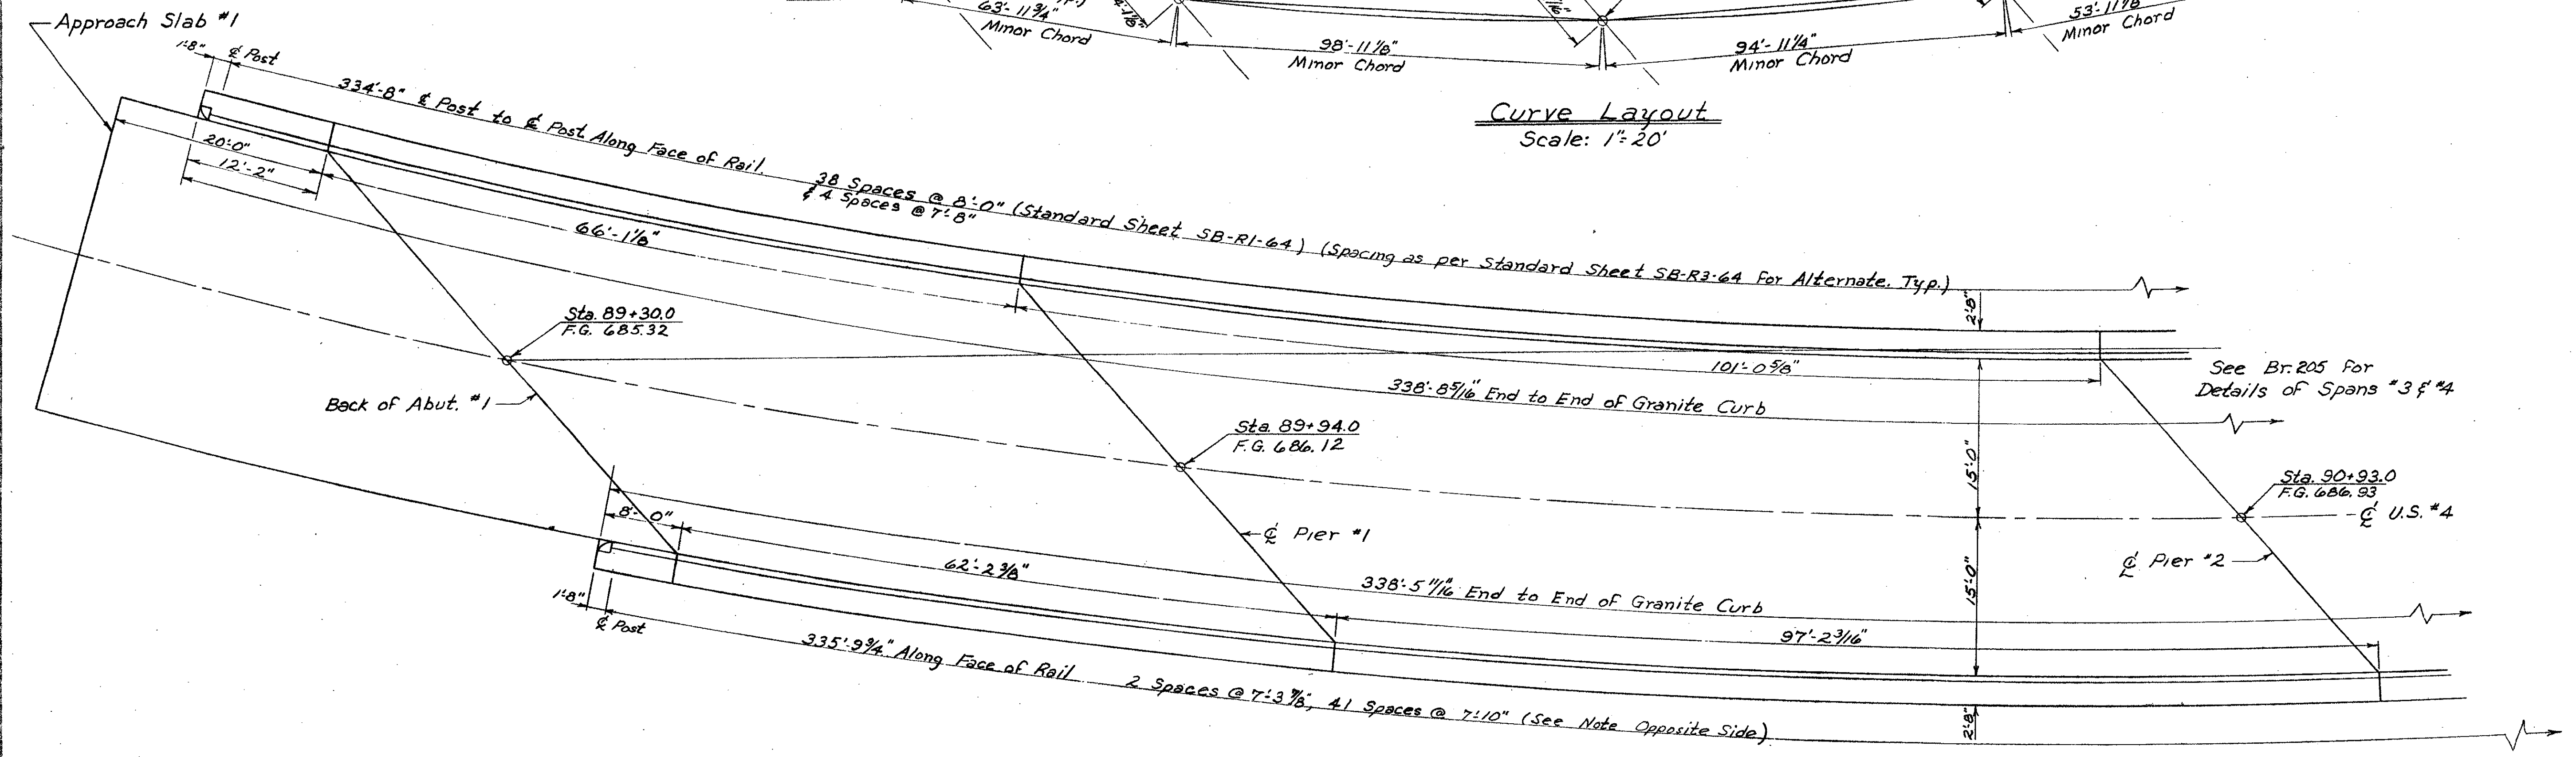

Superstructure Plan - Spans #1 & #2  
Scale: 1/8" = 1'-0"

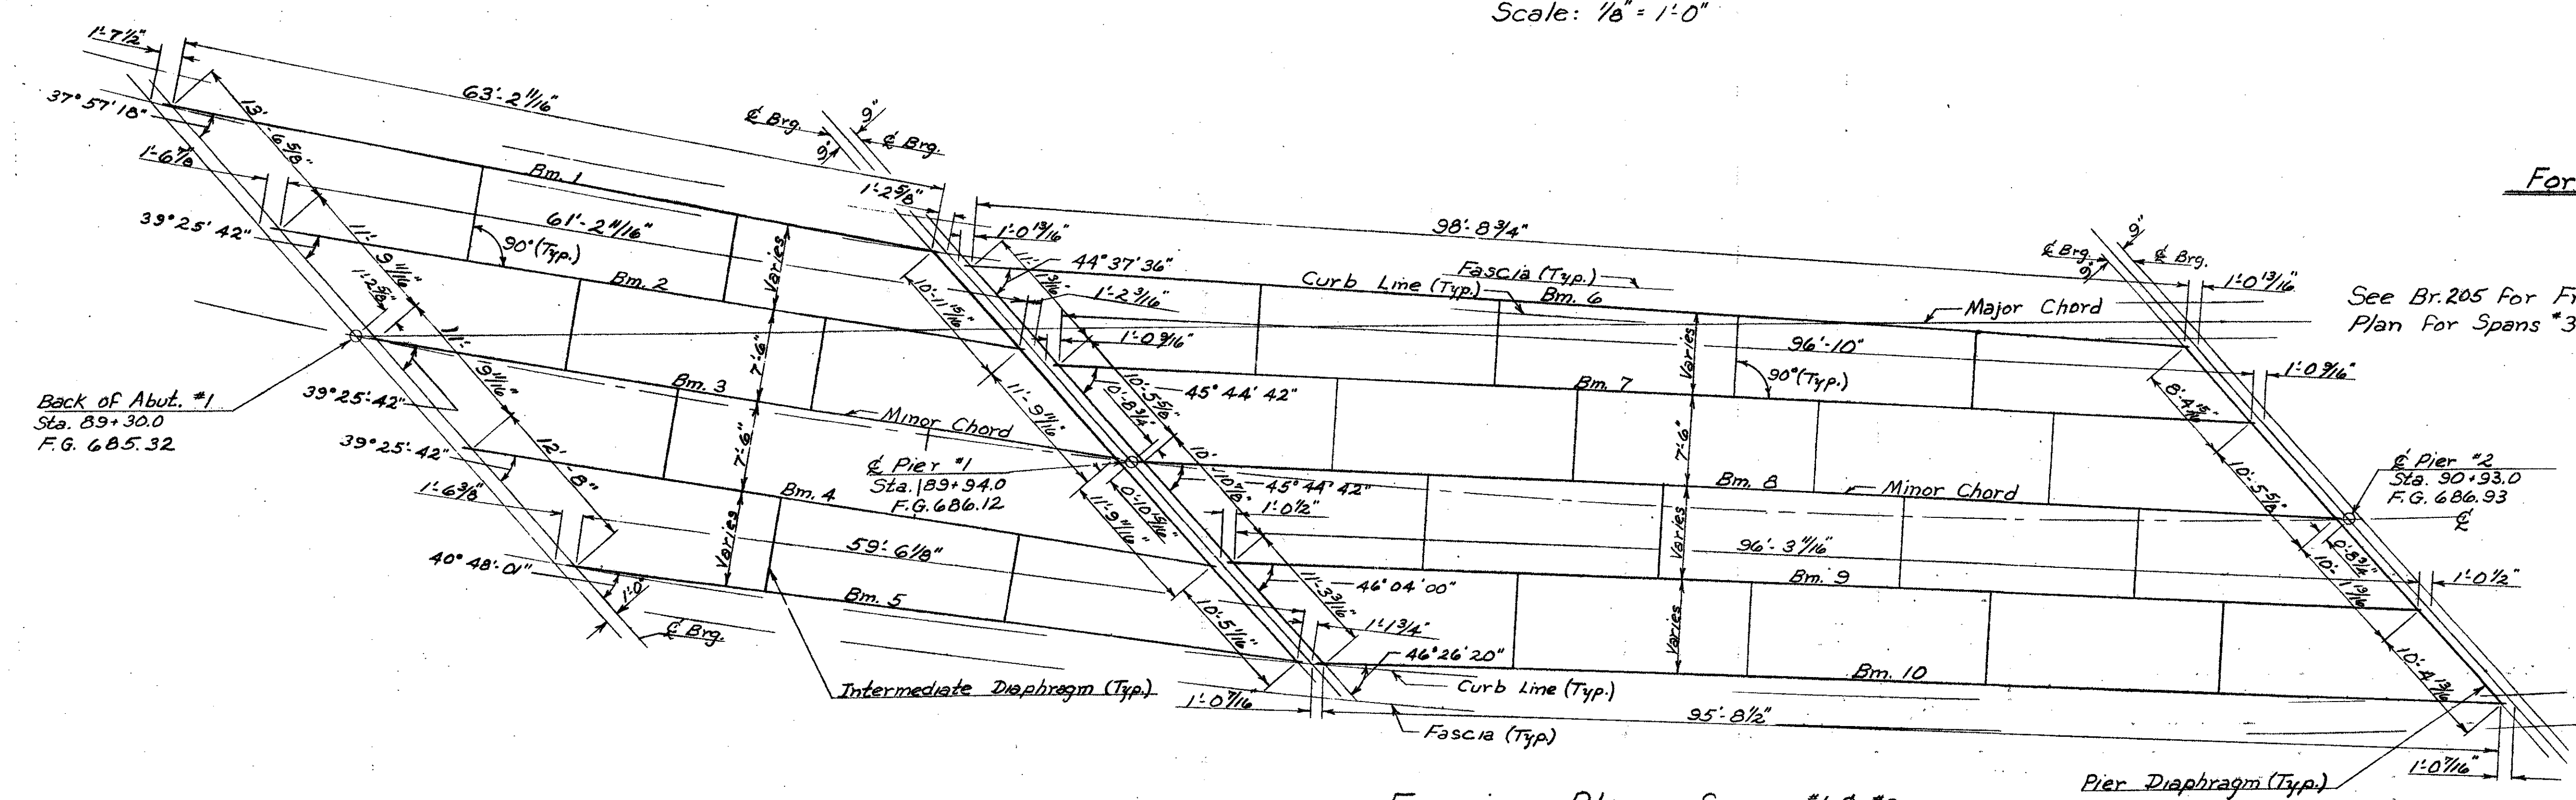

Framing Plan - Spans #1 & #2  
Scale: 1/8" = 1'-0"

For Superstructure Notes see Br. 205

See Br. 205 For Framing Plan For Spans #3 & #4.

BR #B

Br. 204 of 214

STATE OF VERMONT  
DEPARTMENT OF HIGHWAYS

TOWN OF Hartford  
ROUTE No. U.S. #4  
U.S. #4 over I 89  
Superstructure - Spans #1 & #2  
SCALE As noted

THIS SHEET IS FOR INFORMATION PURPOSES ONLY  
HARTFORD-SHARON-ROYALTON IM 18 089-1(8)