

STONE FILL, TYPE II
FOR SLOPE STABILIZATION
393+98 - 395+57 LT
396+50 - 398+75 LT

SPECIAL DITCH W/
STONE FILL, TYPE I
395+75 - 399+50 RT (MED)

EARTH BORROW
OR EXCAVATED MATERIAL
393+98 - 395+57 LT
396+50 - 398+75 LT


STONE FILL, TYPE I
FOR SLOPE STABILIZATION *

393+89 - 399+50 SB MEDIAN
393+89 - 399+50 NB MEDIAN

EARTH BORROW
OR EXCAVATED MATERIAL *

393+89 - 399+50 SB MEDIAN
393+89 - 399+50 NB MEDIAN

* SEE TYPICAL FOR DETAILS

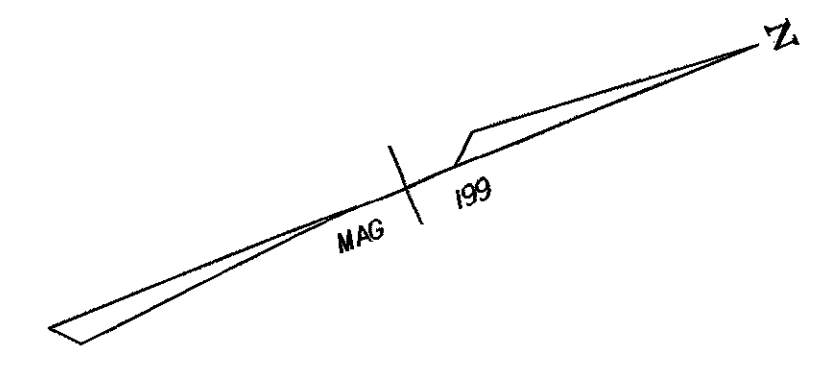

SEE TYPICAL FOR TREATMENTS FROM 393+75 TO 396+50 FOR MED & OUT

S.B. SLIDE AREA MM 7.35 (397+66)

DATUM	
VERTICAL	ASSUMED
HORIZONTAL	ASSUMED



PROJECT: HARTFORD-ROYALTON	PROJECT NO.: IM IR 089-1(8)
DESIGN FILE NAME: /sqda/87a008/da008wrk.dgn	PLOT DATE: 12-MAR-1999
IPARM FILE NAME: slide01.i	SURVEY DATE:
SURVEYED BY: GILMAN	DRAWN BY: Richardson
SQUAD LEADER: BOMBARDIER	SHEET: 137 OF 260