


EXIST. 18" ACCGMP - RETAIN FROM DI TO 1ST ELBOW
 REMOVE EXIST. DI @ INLET, 18" ACCGMP FROM 1ST
 ELBOW & HW @ OUTLET
 NEW DI @ INLET, 18" X 114" CSP W/ 2- 20" ELBOWS,
 & HW & STONE PAD @ OUTLET

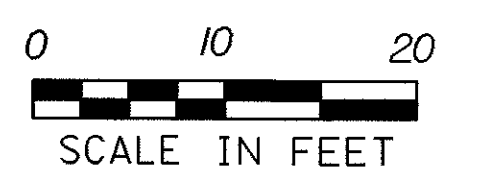

PROJECT: HARTFORD-ROYALTON	PROJECT NO.: IM IR 089-1(8)
DESIGN FILE NAME: /sqda/78a008/da008wrk.dgn	PLOT DATE: 12-MAR-1999
IPARM FILE NAME: slldex05.i	
DRAWN BY: Richardson	