


# CHANNEL REPAIR TYPICAL SECTION DETAIL

WASHOUT AREAS  
 MM 11.62 OUT  
 MM 21.12 OUT

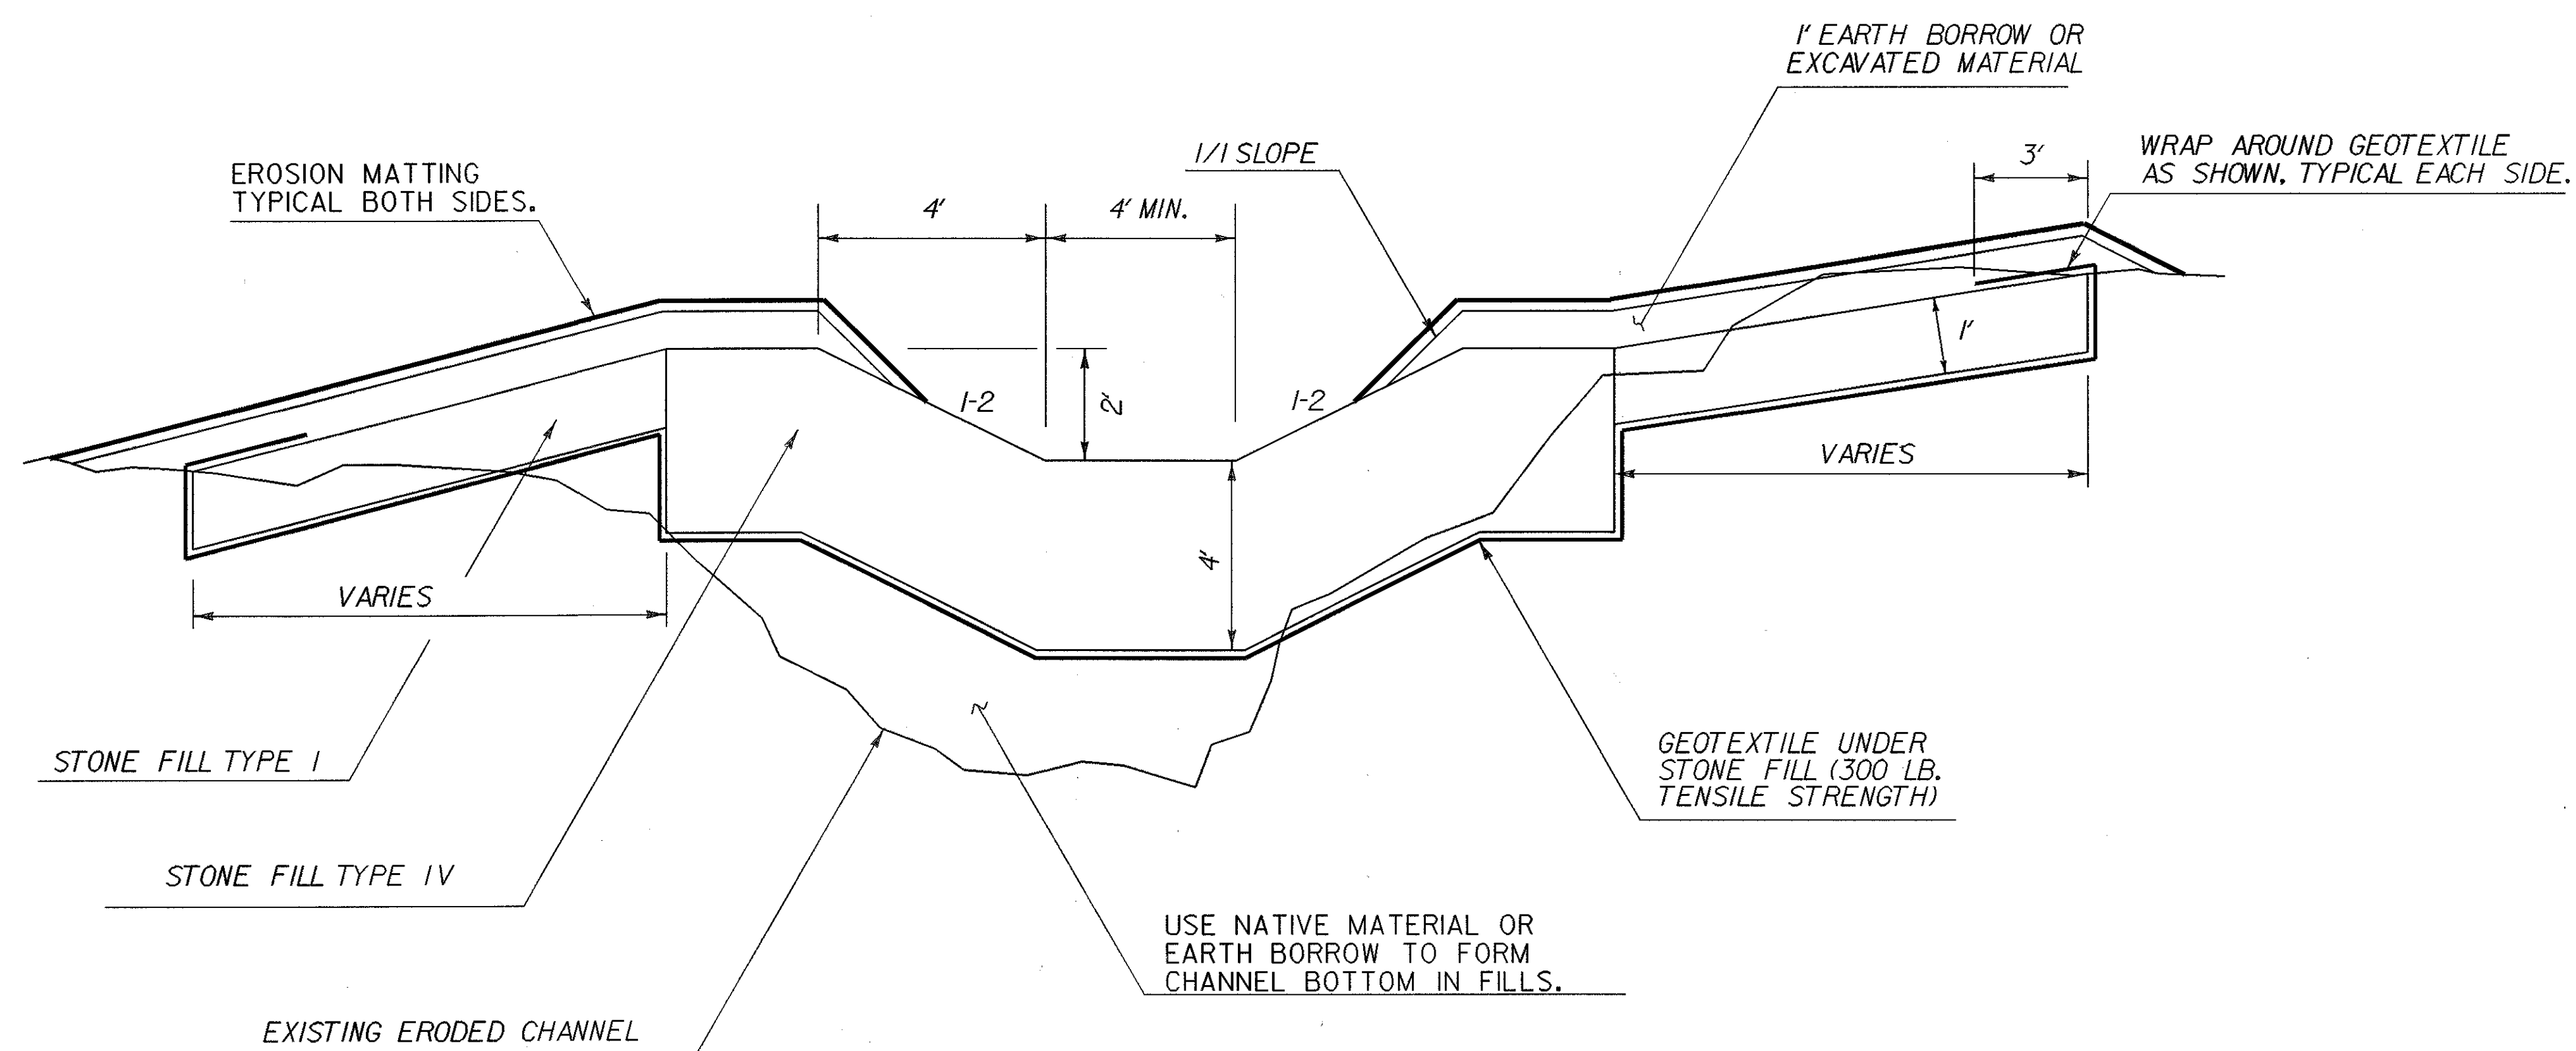

CHANNEL REPAIR TYPICAL SECTION DETAIL

DATUM	
VERTICAL	N/A
HORIZONTAL	N/A

SURVEYED BY	N/A	DATE	N/A
DRAWN BY	Ross	DATE	4/95
SQUAD LEADER	Nyquist		
DESIGN FILE NO.	/sada/87a008/da008det.dgn		
IPARM FILE	da008cr+	DATE PLOTTED	12-MAR-1999
PROJ. NAME	Hartford-Sharon-Royalton		
PROJ. NO.	IM IR 089-(18)		
SHEET	154	OF	260 SHEETS

NOT TO SCALE