

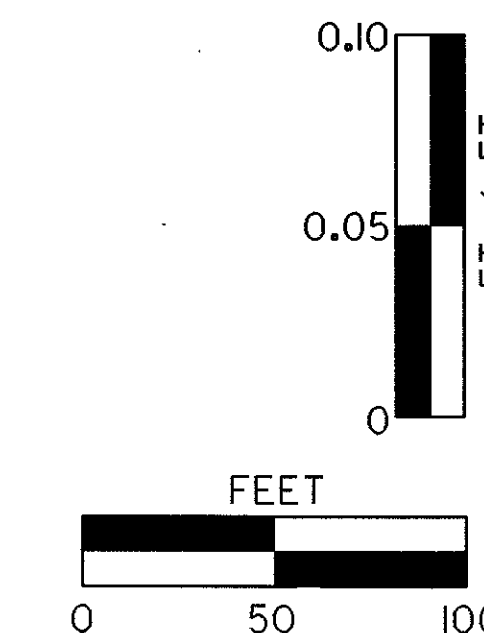


HARTFORD RAMP "C" BANKING DIAGRAM

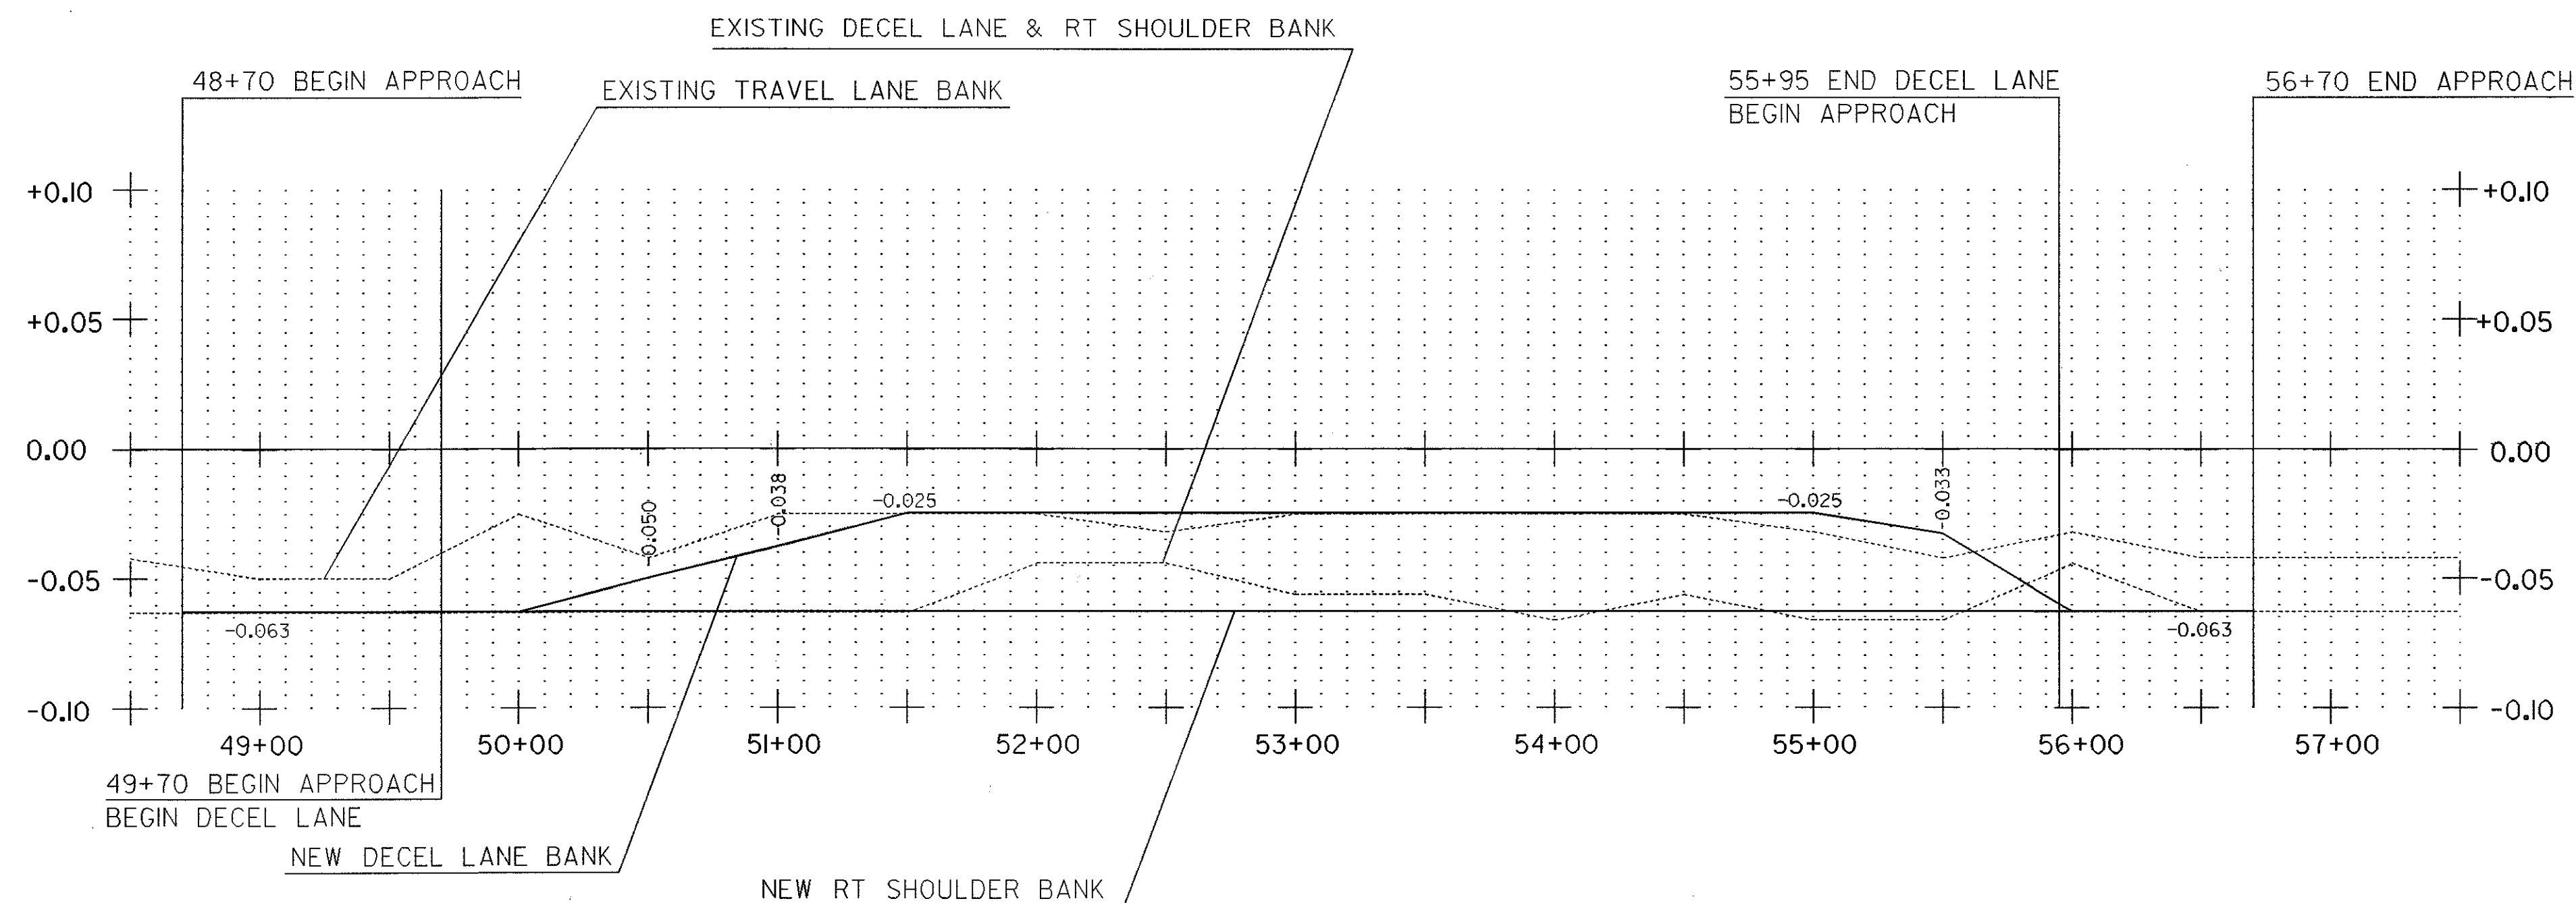

HARTFORD RAMP "C" MATERIAL TRANSITION DIAGRAM

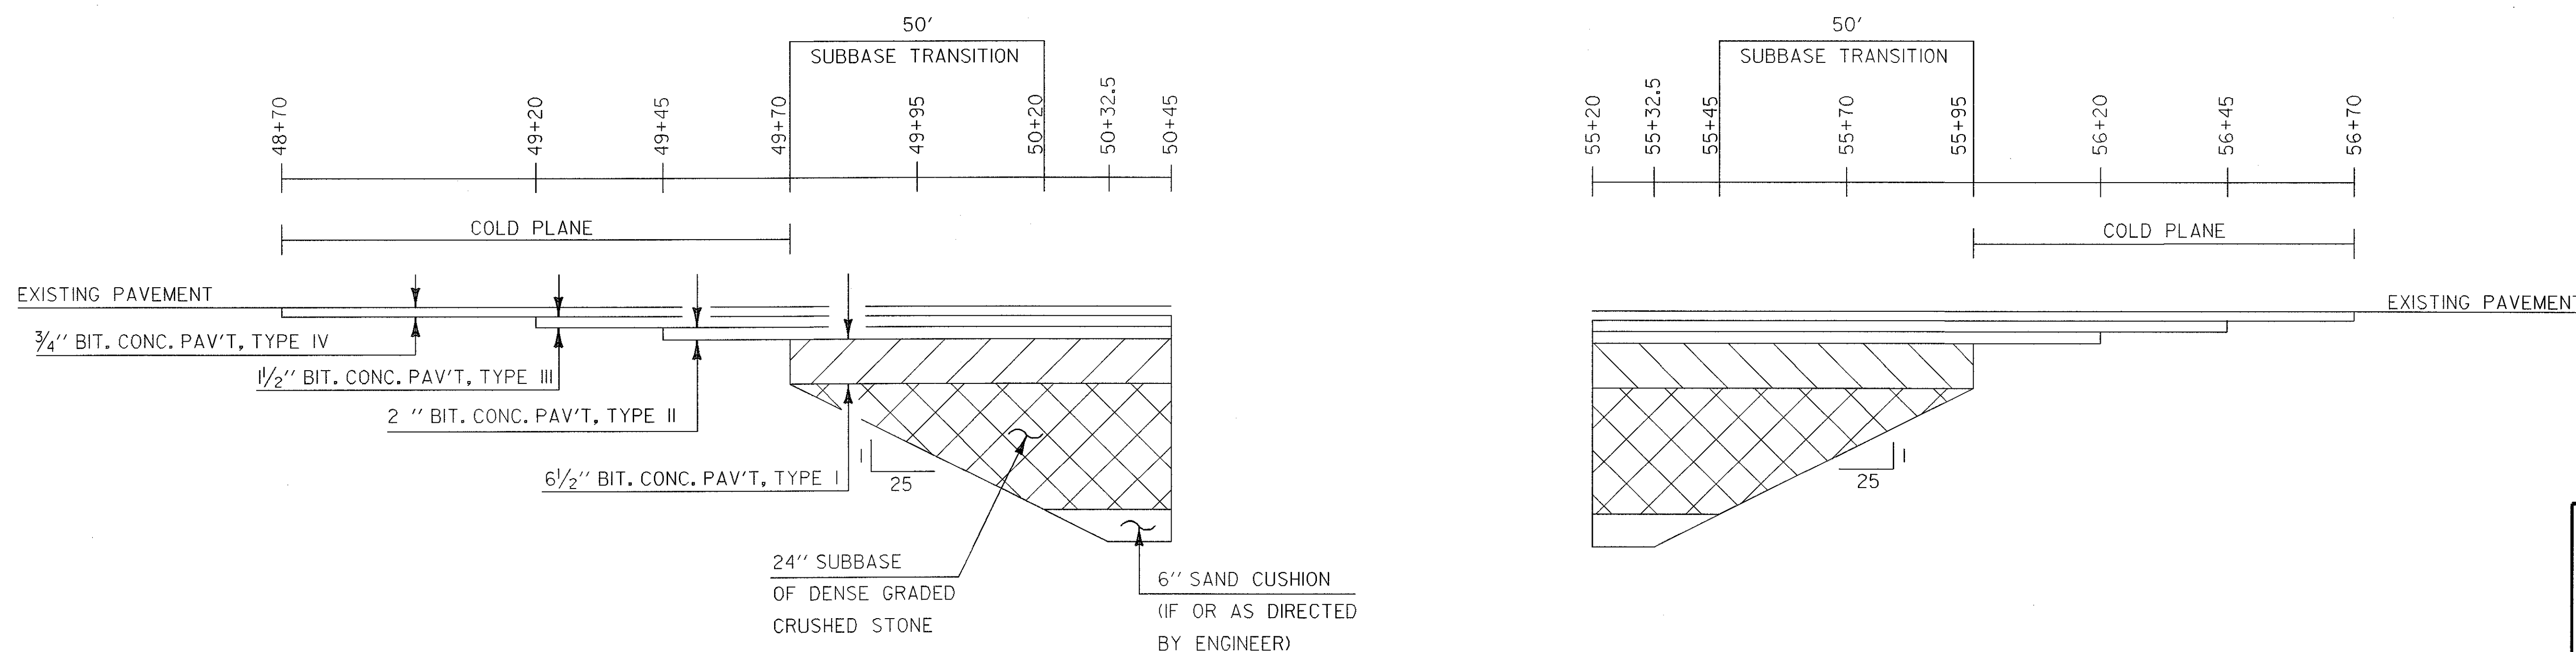

HARTFORD RAMP "C" BANKING AND MATERIAL TRANSITION DIAGRAMS

DRAWN BY	Richardson	DATE	2-94
SQUAD LEADER	BOMBARDIER		
DESIGN FILE NO.	/sqda/87a008/da008int.dgn		
IPARM FILE	da008bnk.i	DATE PLOTTED	12-MAR-1999
PROJ. NAME	Hartford-Sharon-Royalton		
PROJ. NO.	IM IR 089-1(8)		
SHEET	157	OF	260 SHEETS

NOT TO SCALE