




52+50

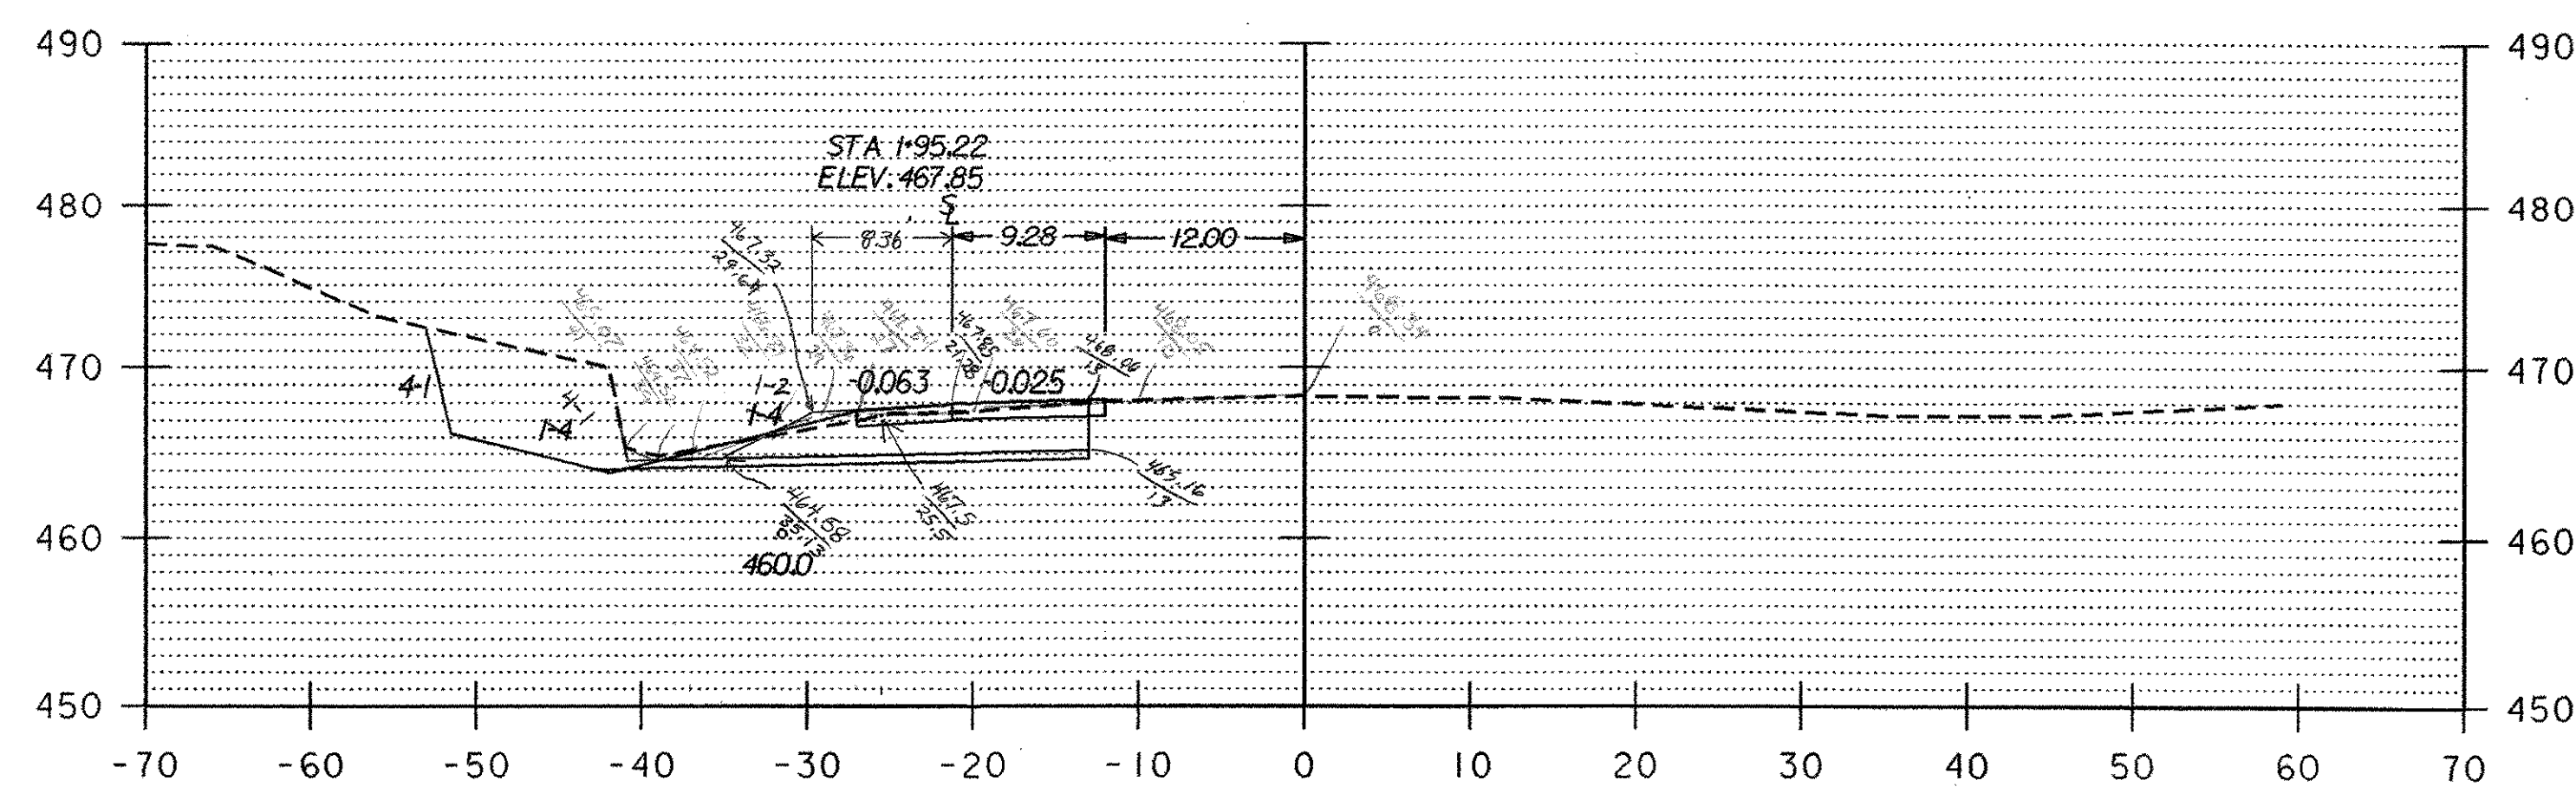


54+00

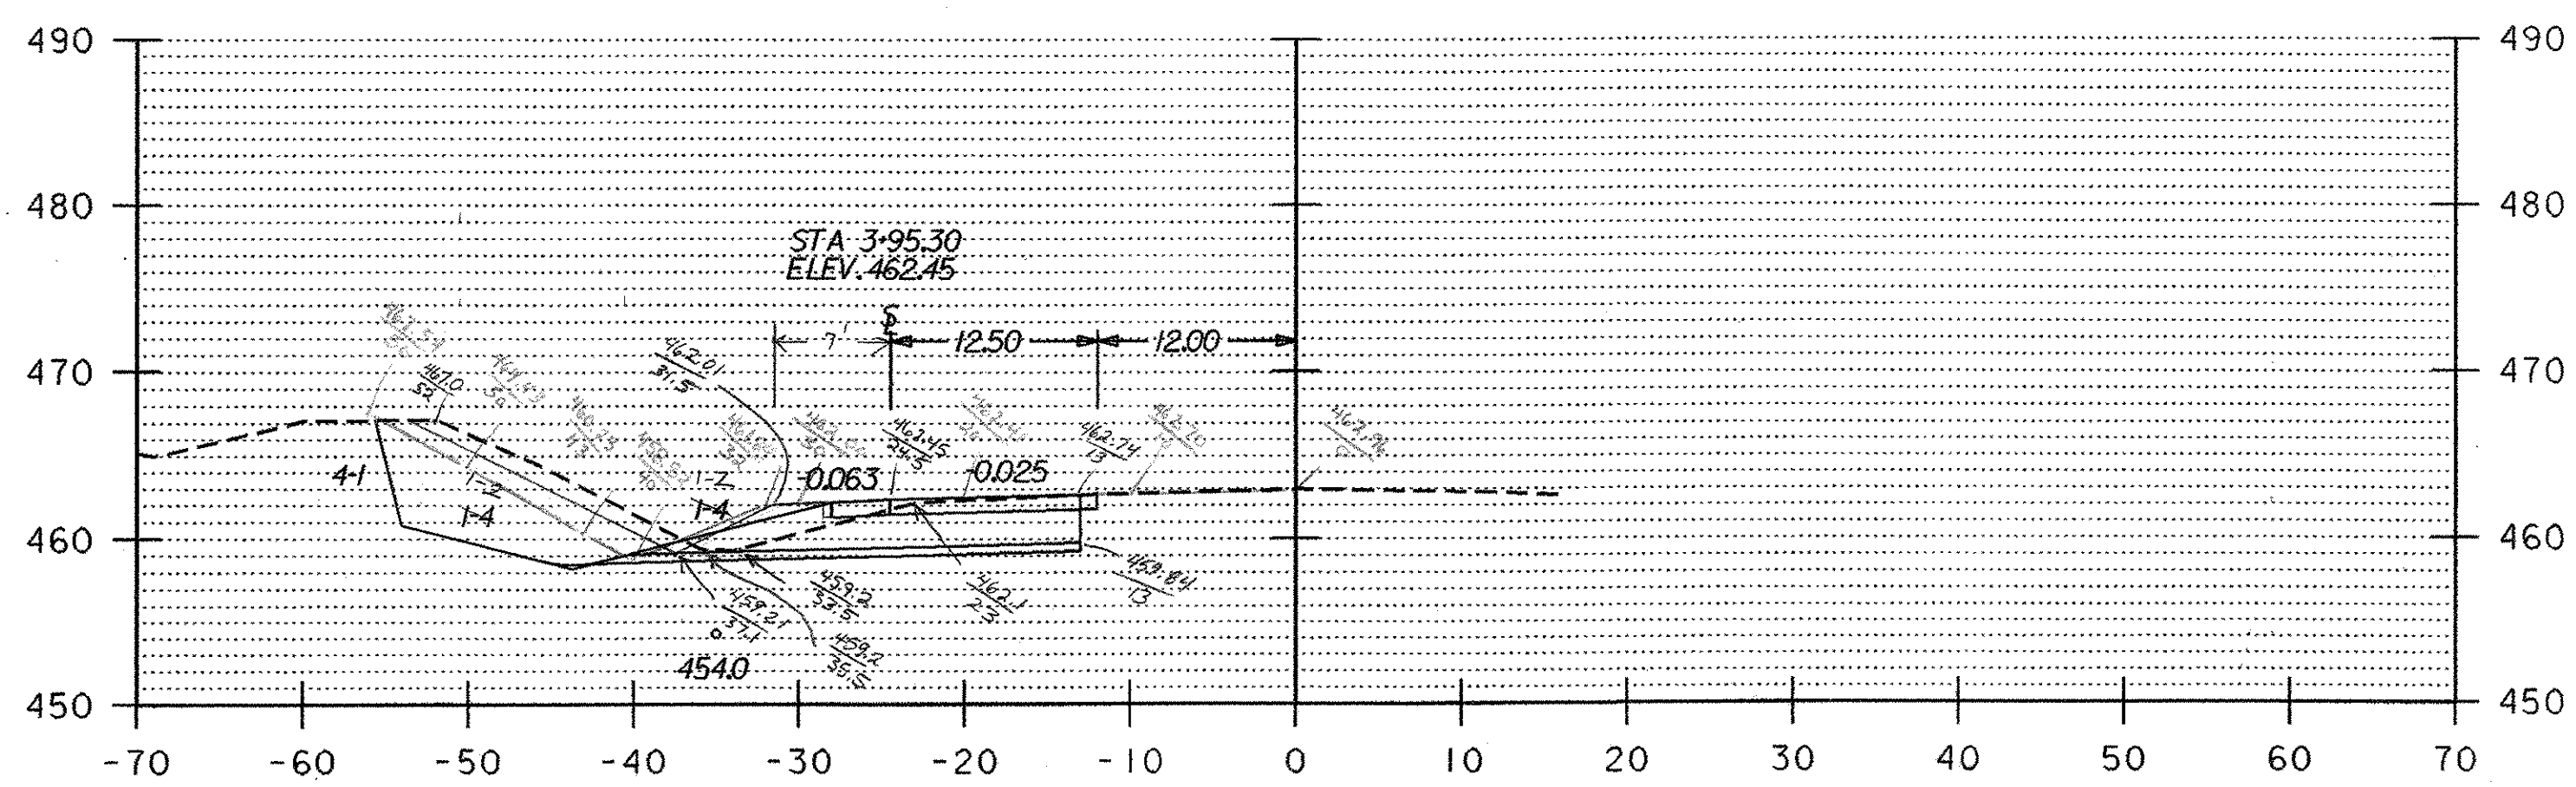


52+00

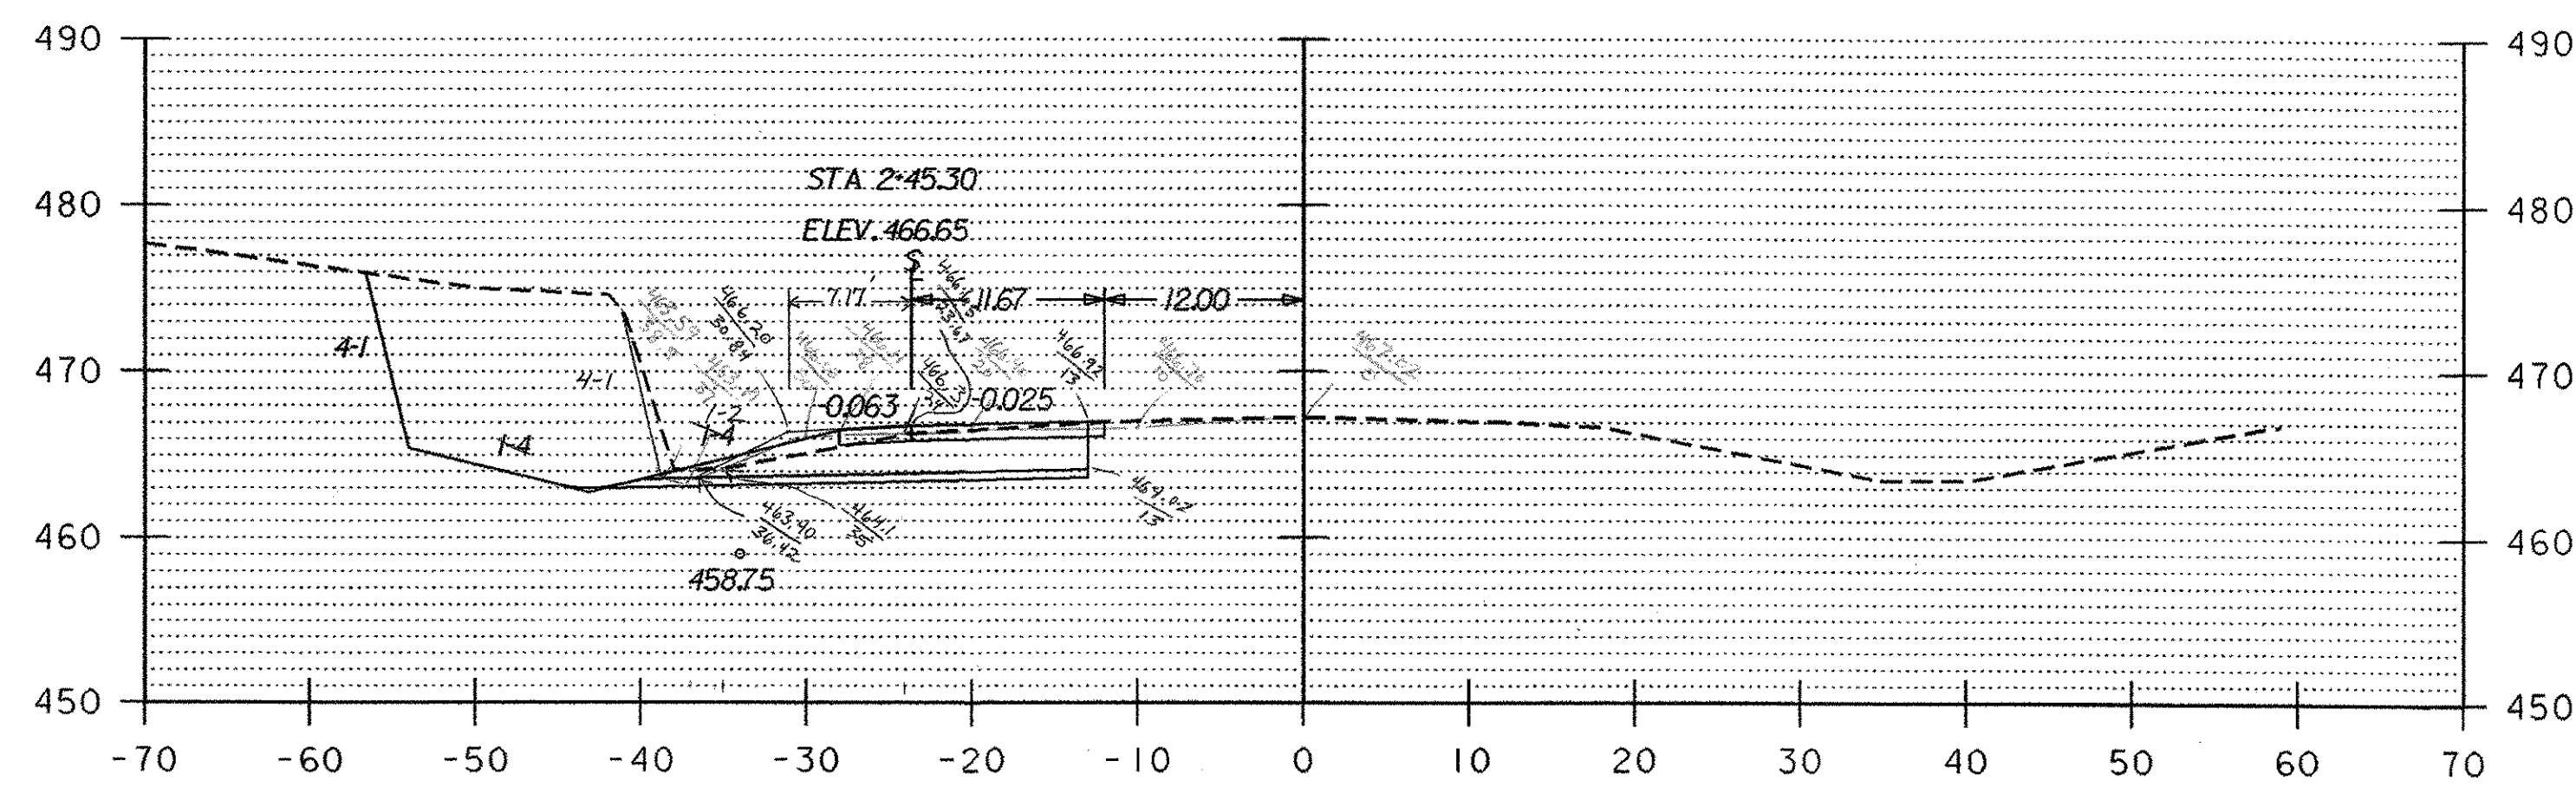

53+50

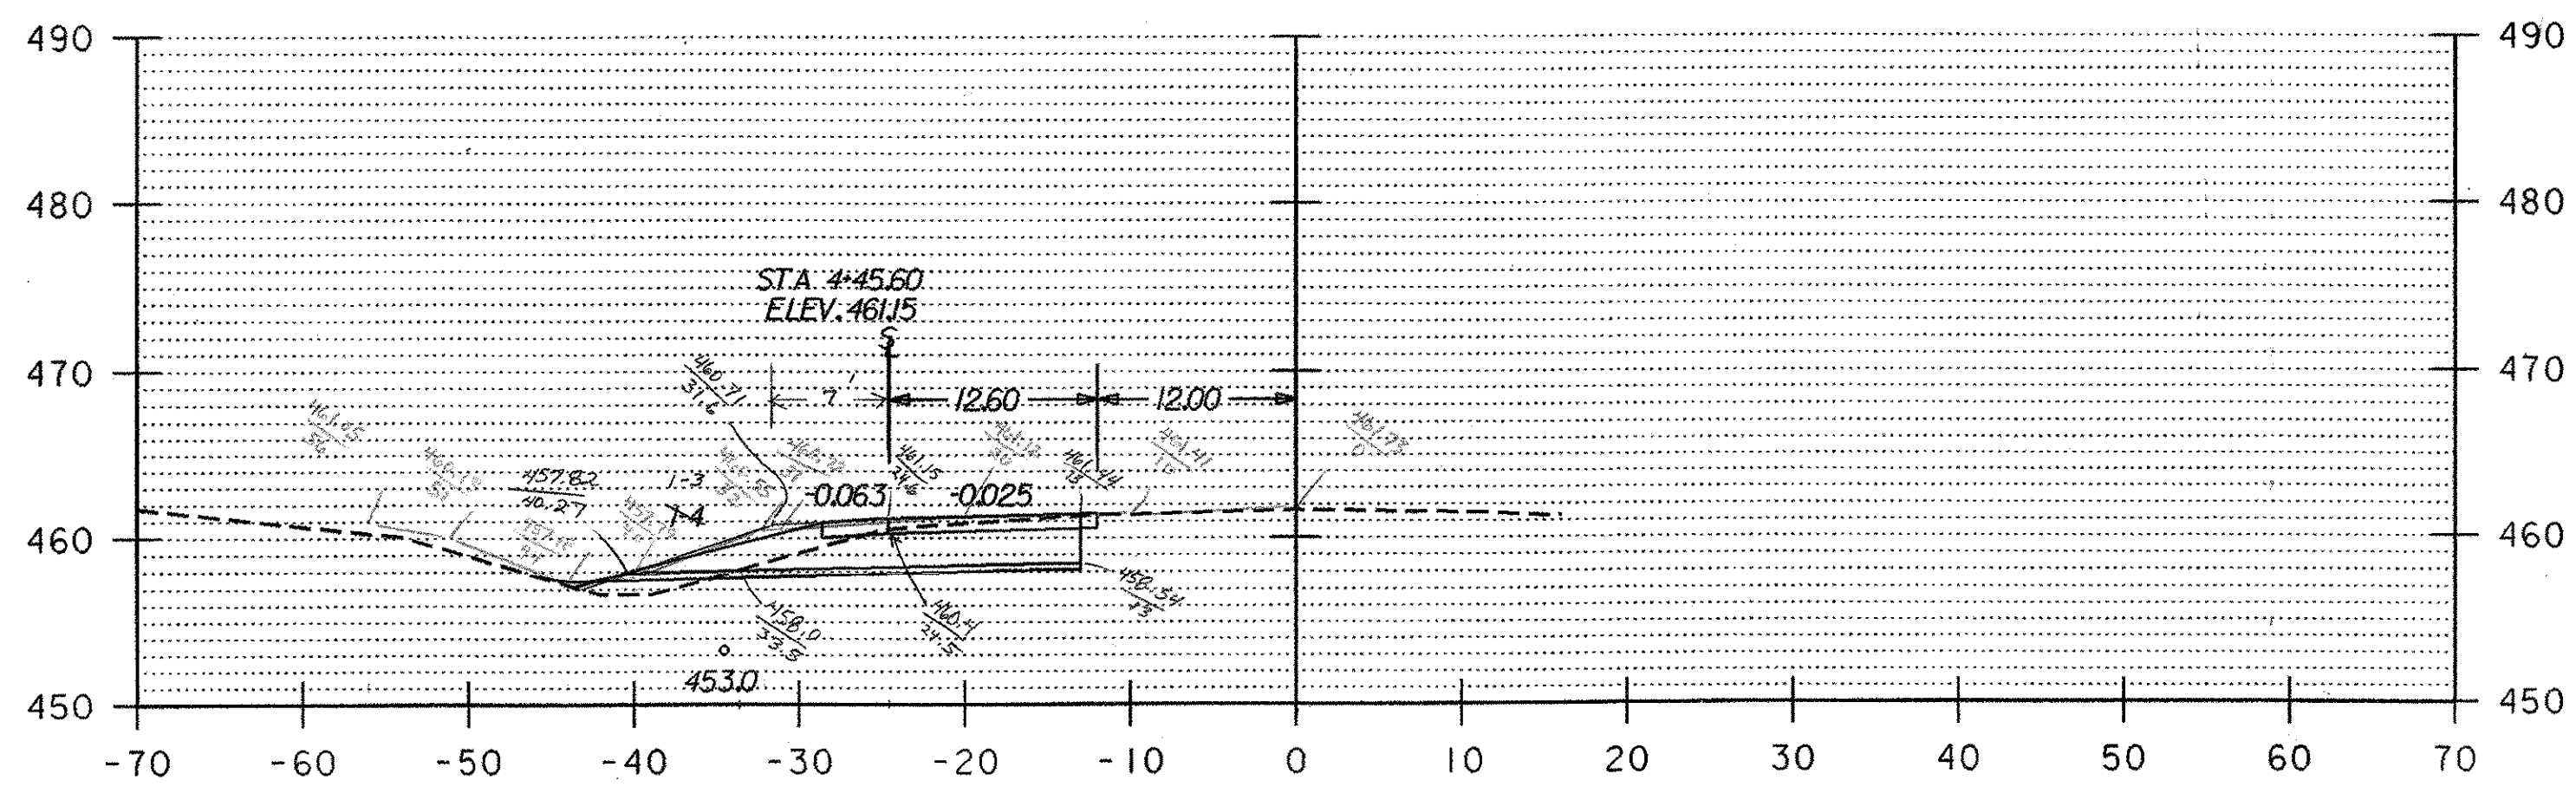

51+50

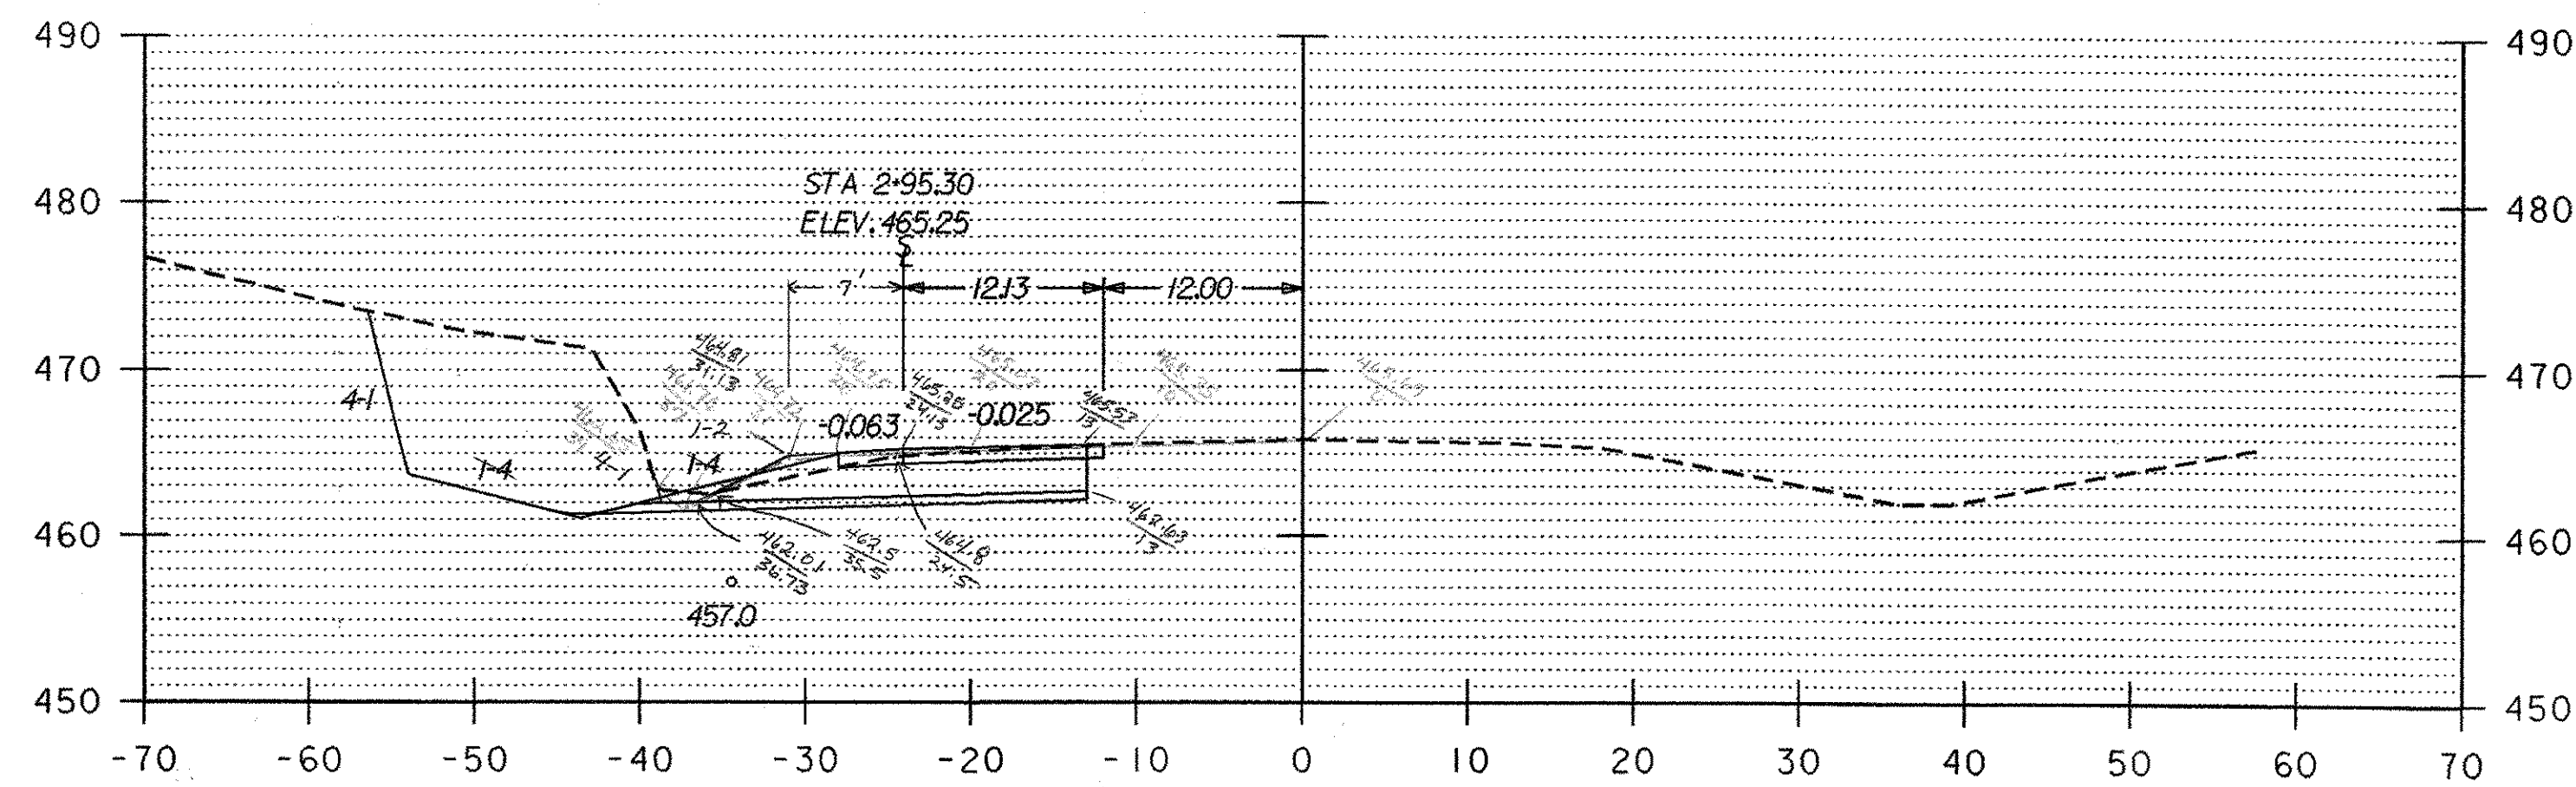


53+00

NOTE: NO SAND CUSHION USED

51+50 - 54+00

DATUM  
 VERTICAL ASSUMED  
 HORIZONTAL N/A

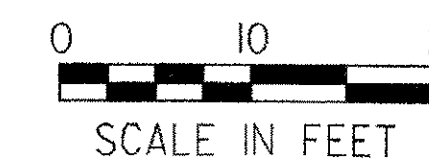

SURVEYED BY Zambon DATE 1/92  
 DRAWN BY Ross DATE 10/94  
 SQUAD LEADER BOMBARDIER  
 DESIGN FILE NO. /sqda/87a008/da008int.dgn  
 IPARM FILE da008xs2.i DATE PLOTTED 12-MAR-1999  
 PROJ. NAME Hartford-Sharon-Royalton  
 PROJ. NO. IM IR 089-(8)  
 SHEET 159 OF 260 SHEETS