




55+50

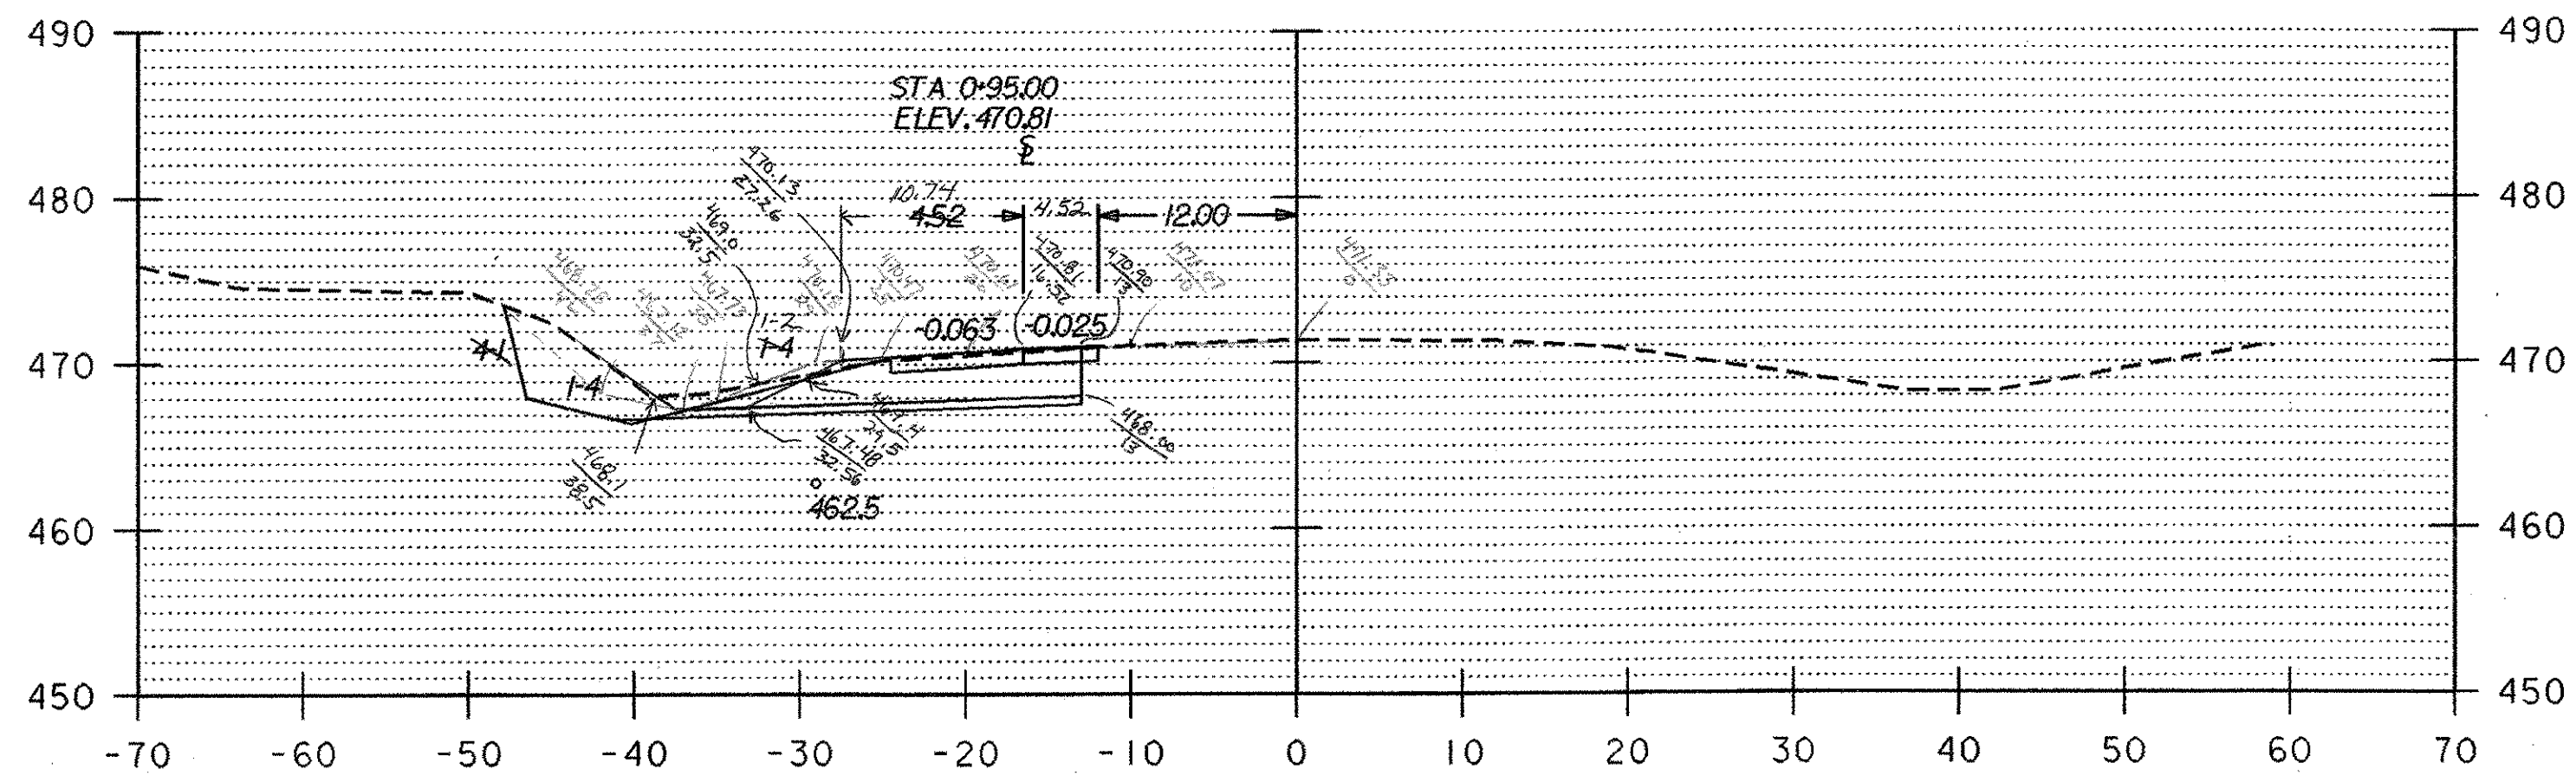


55+00

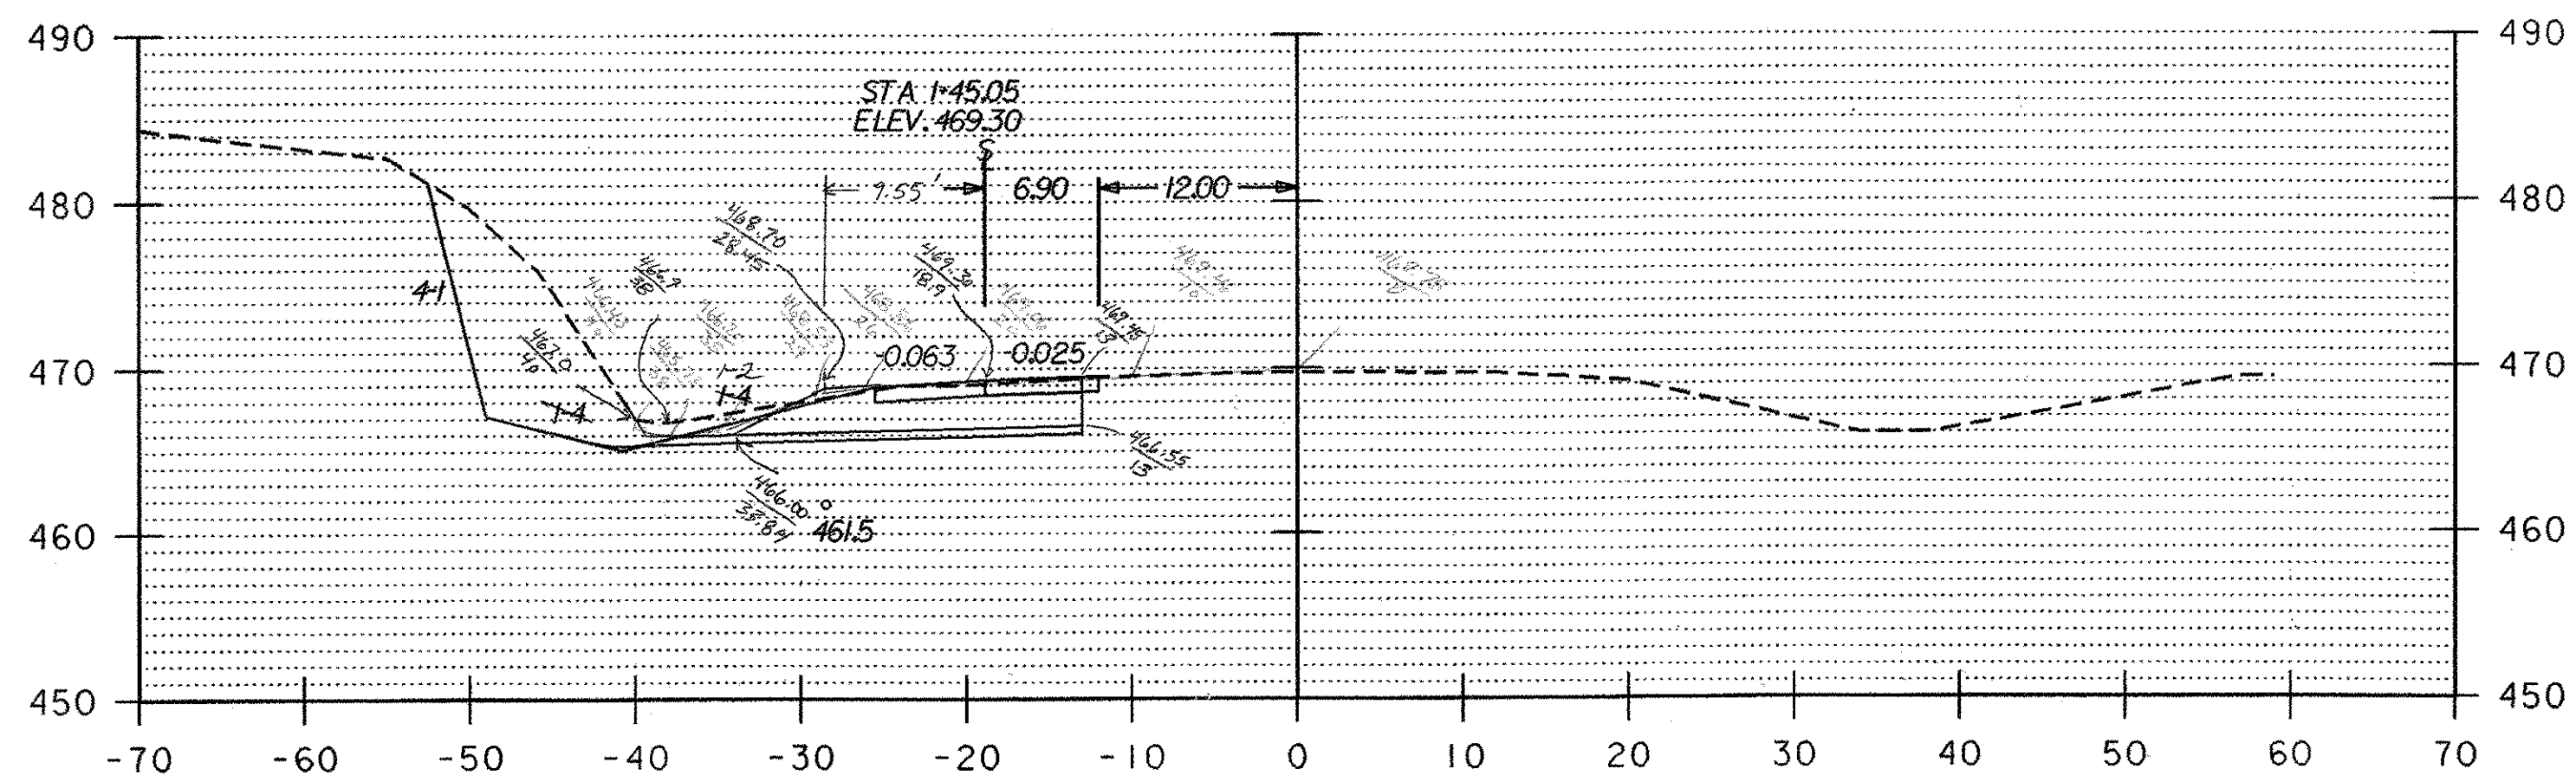

54+50

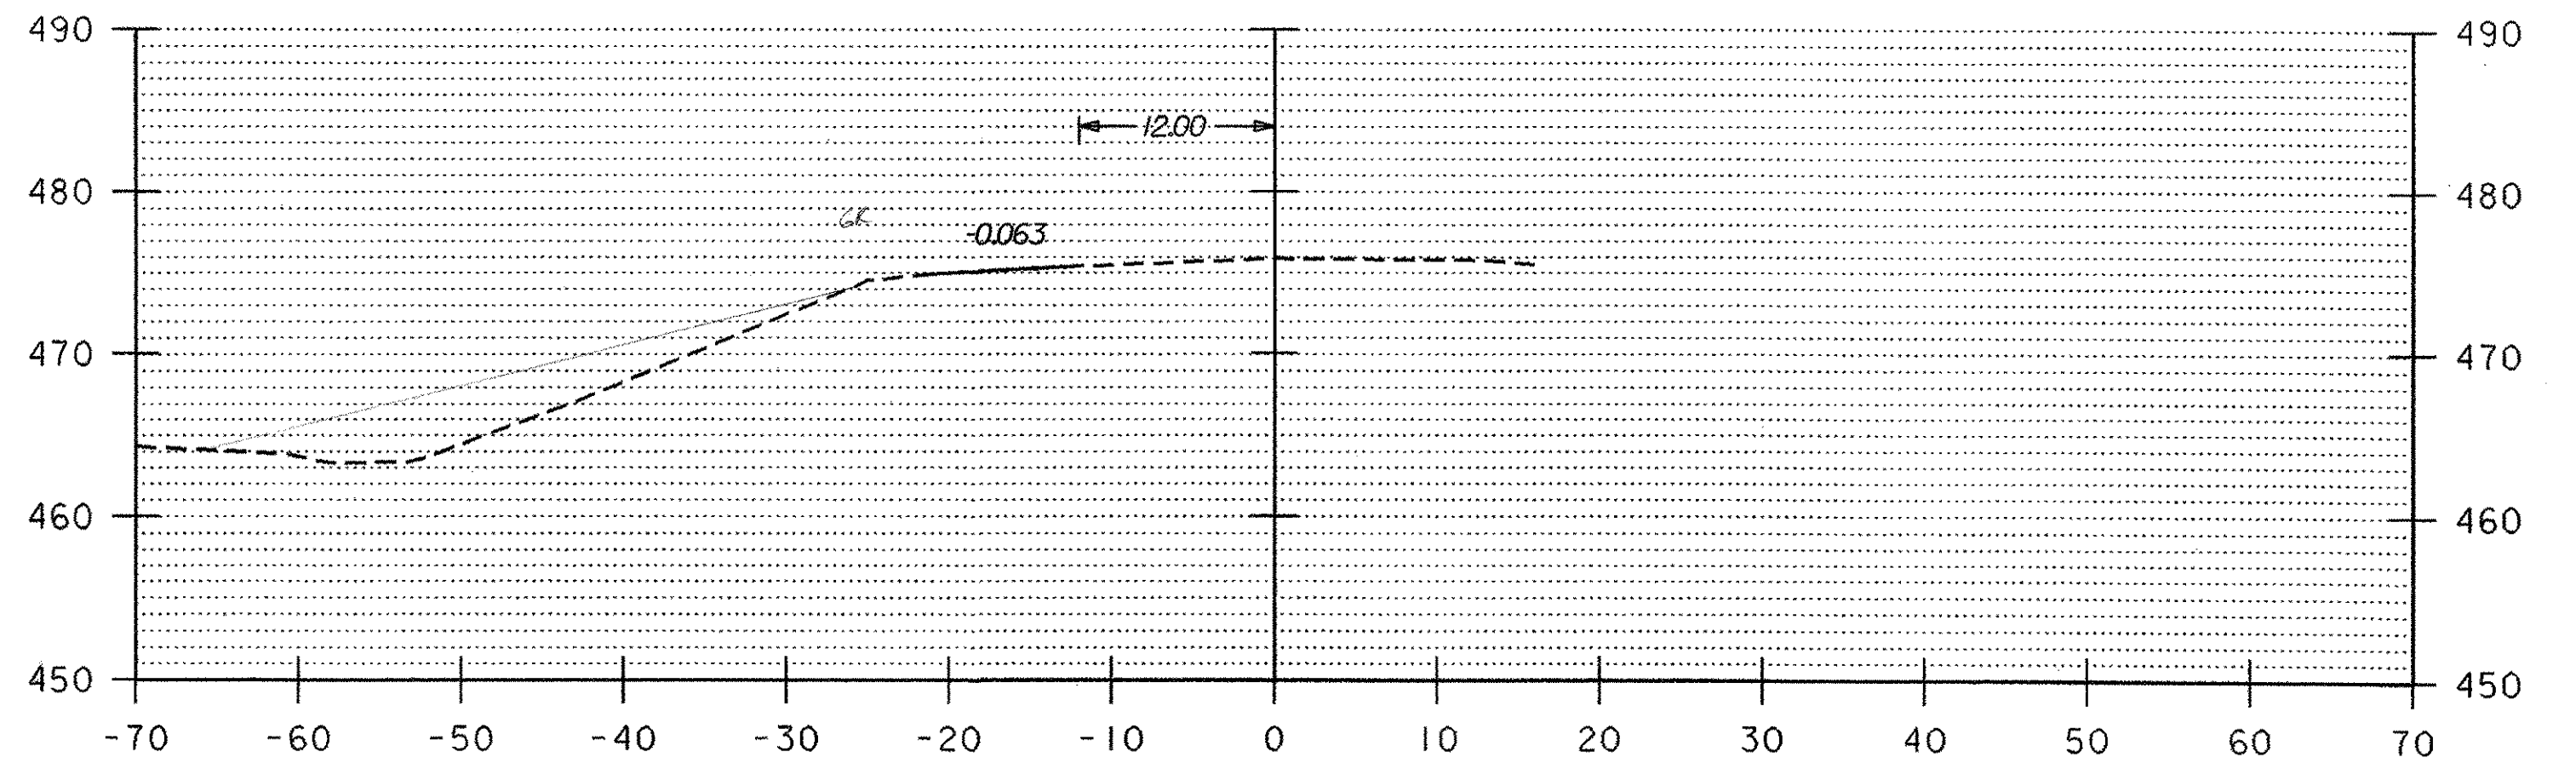

56+50

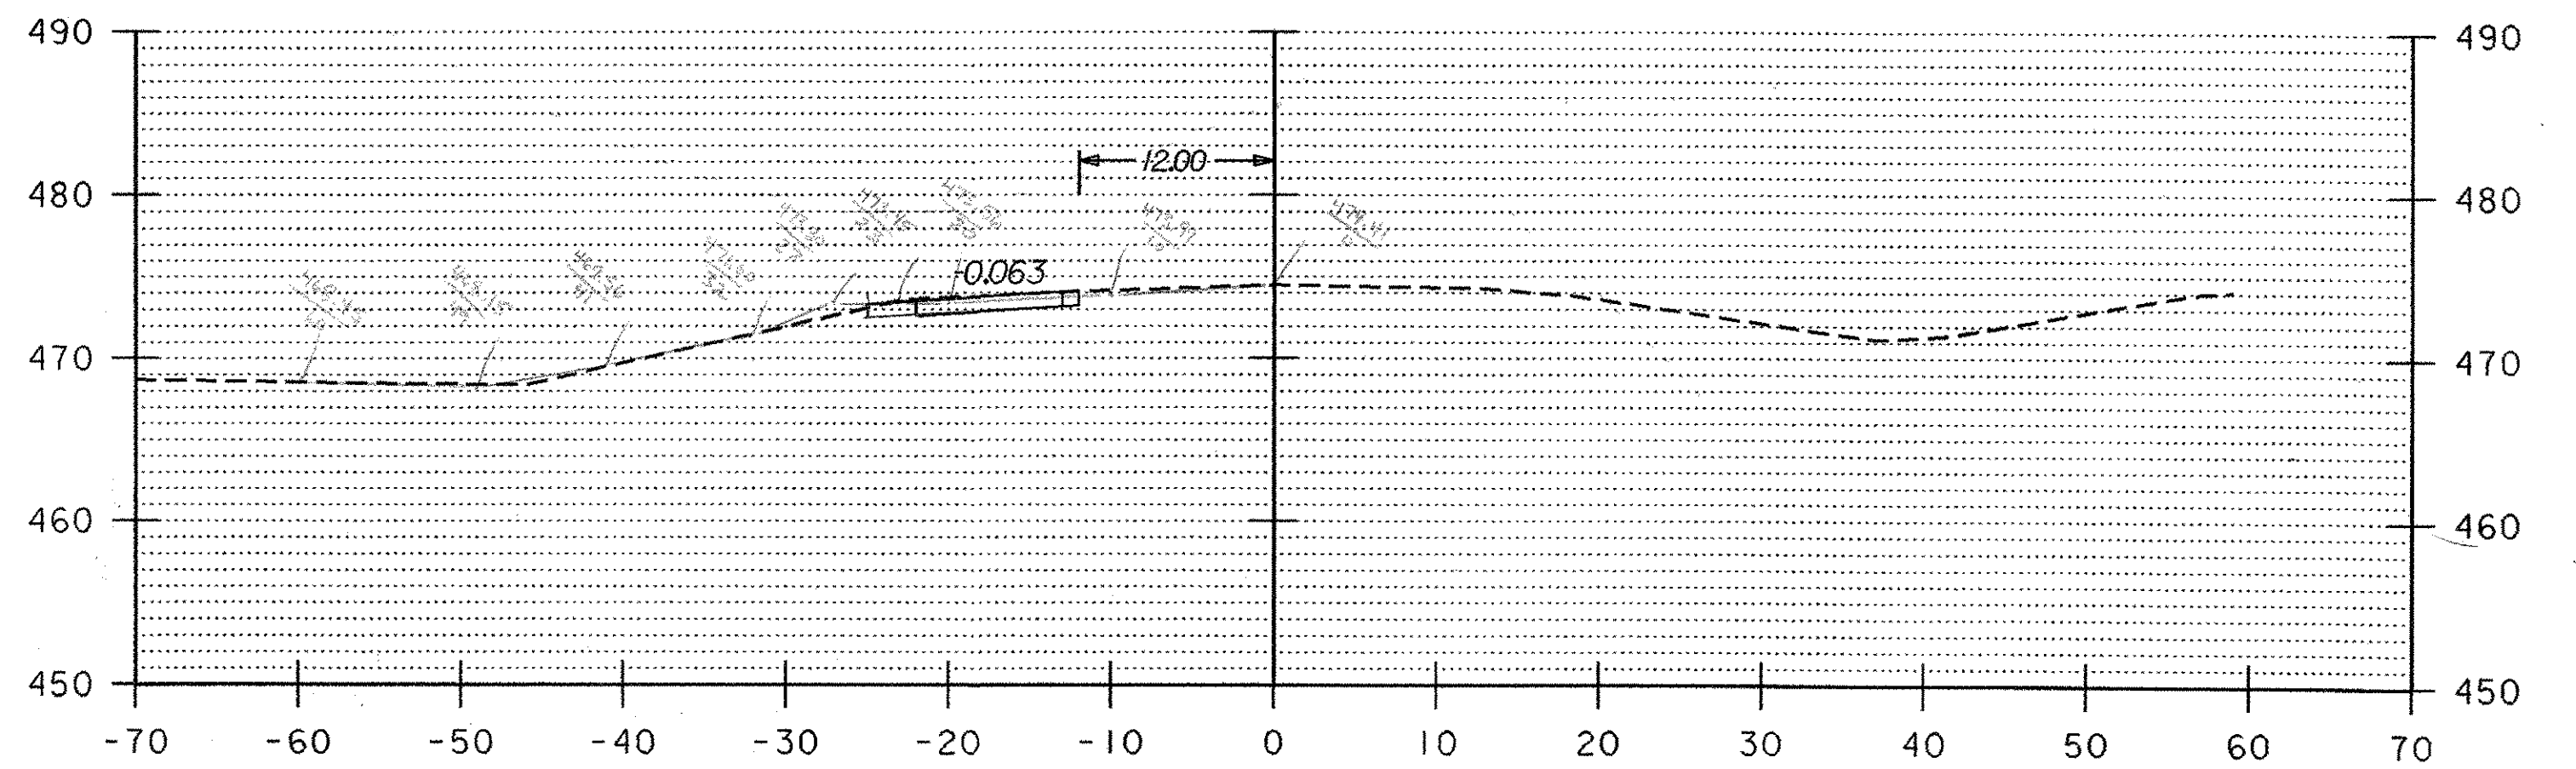

56+00

NOTE: NO SAND CUSHION USED

54+50 - 56+00

DATUM	
VERTICAL	ASSUMED
HORIZONTAL	N/A



SURVEYED BY	Zambon	DATE	1/92
DRAWN BY	Ross	DATE	10/94
SQUAD LEADER	BOMBARDIER		
DESIGN FILE NO.	/sqda/87a008/da008Int.dgn		
IPARM FILE	da008xs3.1	DATE PLOTTED	12-MAR-1999
PROJ. NAME	Hartford-Sharon-Royalton		
PROJ. NO.	IM IR 089-1(8)		
SHEET	160 OF 260 SHEETS		