


648+25 (NB OUTSIDE)
LEDGE REMOVAL

DATUM
VERTICAL assumed 500
HORIZONTAL n/a

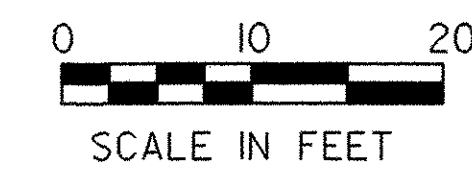

| | |
|---|---------------------------------------|
| PROJECT: HARTFORD-ROYALTON | PROJECT NO.: IM IR 089-1(8) |
| DESIGN FILE NAME: /sqda/87a008/mml2.dgn | PLOT DATE: 12-MAR-1999 |
| IPARM FILE NAME: ml2xs02.i | SURVEY DATE: fall 92 |
| SURVEYED BY: gllman | DRAWN BY: jf gruchacz |
| SQUAD LEADER: a. kreis | SHEET: 162 OF 260 |