


649+00 (NB OUTSIDE)
LEDGE REMOVAL

DATUM
VERTICAL assumed 500
HORIZONTAL n/a

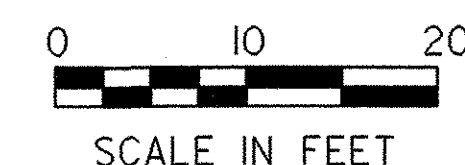

PROJECT: HARTFORD-ROYALTON	PROJECT NO.: IM IR 089-1(8)
DESIGN FILE NAME: /sqda/87a008/mml2.dgn	PLOT DATE: 12-MAR-1999
IPARM FILE NAME: ml2xs05.i	SURVEY DATE: fall 92
SURVEYED BY: gilman	DRAWN BY: Jf gruchacz
SQUAD LEADER: a. kreiss	SHEET: 165 OF 260