


649+25 (NB OUTSIDE)  
LEDGE REMOVAL

DATUM	
VERTICAL	assumed 500
HORIZONTAL	n/a

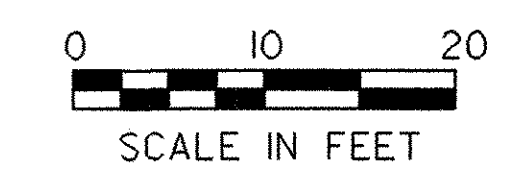

PROJECT: HARTFORD-ROYALTON	PROJECT NO.: IM IR 089-1(8)
DESIGN FILE NAME: /sqda/87a008/mml2.dgn	PLOT DATE: 12-MAR-1999
IPARM FILE NAME: ml2xs06.i	SURVEY DATE: fall 92
SURVEYED BY: glman	DRAWN BY: jf gruchacz
SQUAD LEADER: a. kreis	SHEET: 166 OF 260

*Planting ✓ wbs 2-7-92  
✓ wbs 2-7-92  
✓ sbs 12/6/92  
✓ sbs mmp/92*