


651+25 (NB OUTSIDE)
LEDGE REMOVAL

DATUM
VERTICAL assumed 500
HORIZONTAL n/a

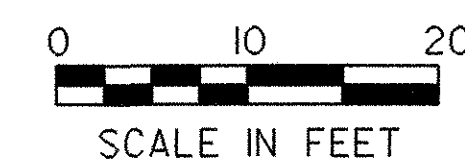

PROJECT: HARTFORD-ROYALTON	PROJECT NO.: IM IR 089-1(8)
DESIGN FILE NAME: /sqda/87a008/mml2.dgn	PLOT DATE: 12-MAR-1999
IPARM FILE NAME: ml2xsl4.i	SURVEY DATE: fall 92
SURVEYED BY: gilman	DRAWN BY: Jf gruchacz
SQUAD LEADER: a. kreis	SHEET: 174 OF 260