


651+50 (NB OUTSIDE)  
LEDGE REMOVAL

<b>DATUM</b>	
VERTICAL	assumed 500
HORIZONTAL	n/a

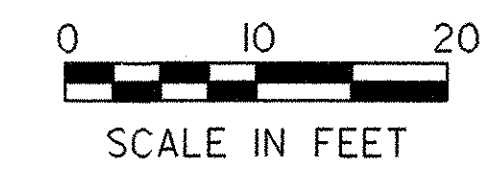

PROJECT: <b>HARTFORD-ROYALTON</b>	PROJECT NO.: <b>IM IR 089-1(8)</b>
DESIGN FILE NAME: /sqda/87a008/mml2.dgn	PLOT DATE: 12-MAR-1999
IPARM FILE NAME: m12xsl5.1	SURVEY DATE: fall 92
SURVEYED BY: gllman	DRAWN BY: jf gruchacz
SQUAD LEADER: a. kreis	SHEET: 175 OF 260