


652+00 (NB OUTSIDE)  
LEDGE REMOVAL

DATUM	
VERTICAL	assumed 500
HORIZONTAL	n/a

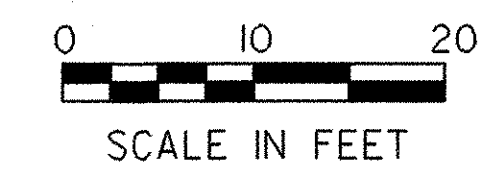

PROJECT: HARTFORD-ROYALTON	PROJECT NO.: IM IR 089-1(8)
DESIGN FILE NAME: /sqda/87a008/mml2.dgn	PLOT DATE: 12-MAR-1999
IPARM FILE NAME: ml2xsl7.1	SURVEY DATE: fall 92
SURVEYED BY: gllman	DRAWN BY: jf gruchacz
SQUAD LEADER: a. kreis	SHEET: 177 OF 260

Plotting: J. Allen 12/17/92  
 Plotting: J. Allen 12/17/92  
 Plotting: J. Allen 12/17/92