


652+25 (NB OUTSIDE)
LEDGE REMOVAL

Planning ✓
 Revising ✓
 Plotting ✓
 Checked ✓

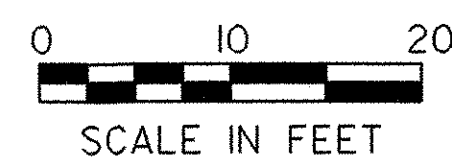

DATUM	
VERTICAL	assumed 500
HORIZONTAL	n/a

PROJECT: HARTFORD-ROYALTON	PROJECT NO.: IM IR 089-1(8)
DESIGN FILE NAME: /sqda/87a008/mml2.dgn	PLOT DATE: 12-MAR-1999
IPARM FILE NAME: ml2xsl8.l	SURVEY DATE: fall 92
SURVEYED BY: gilman	DRAWN BY: jf gruchacz
SQUAD LEADER: a. kreis	SHEET: 178 OF 260