



24'

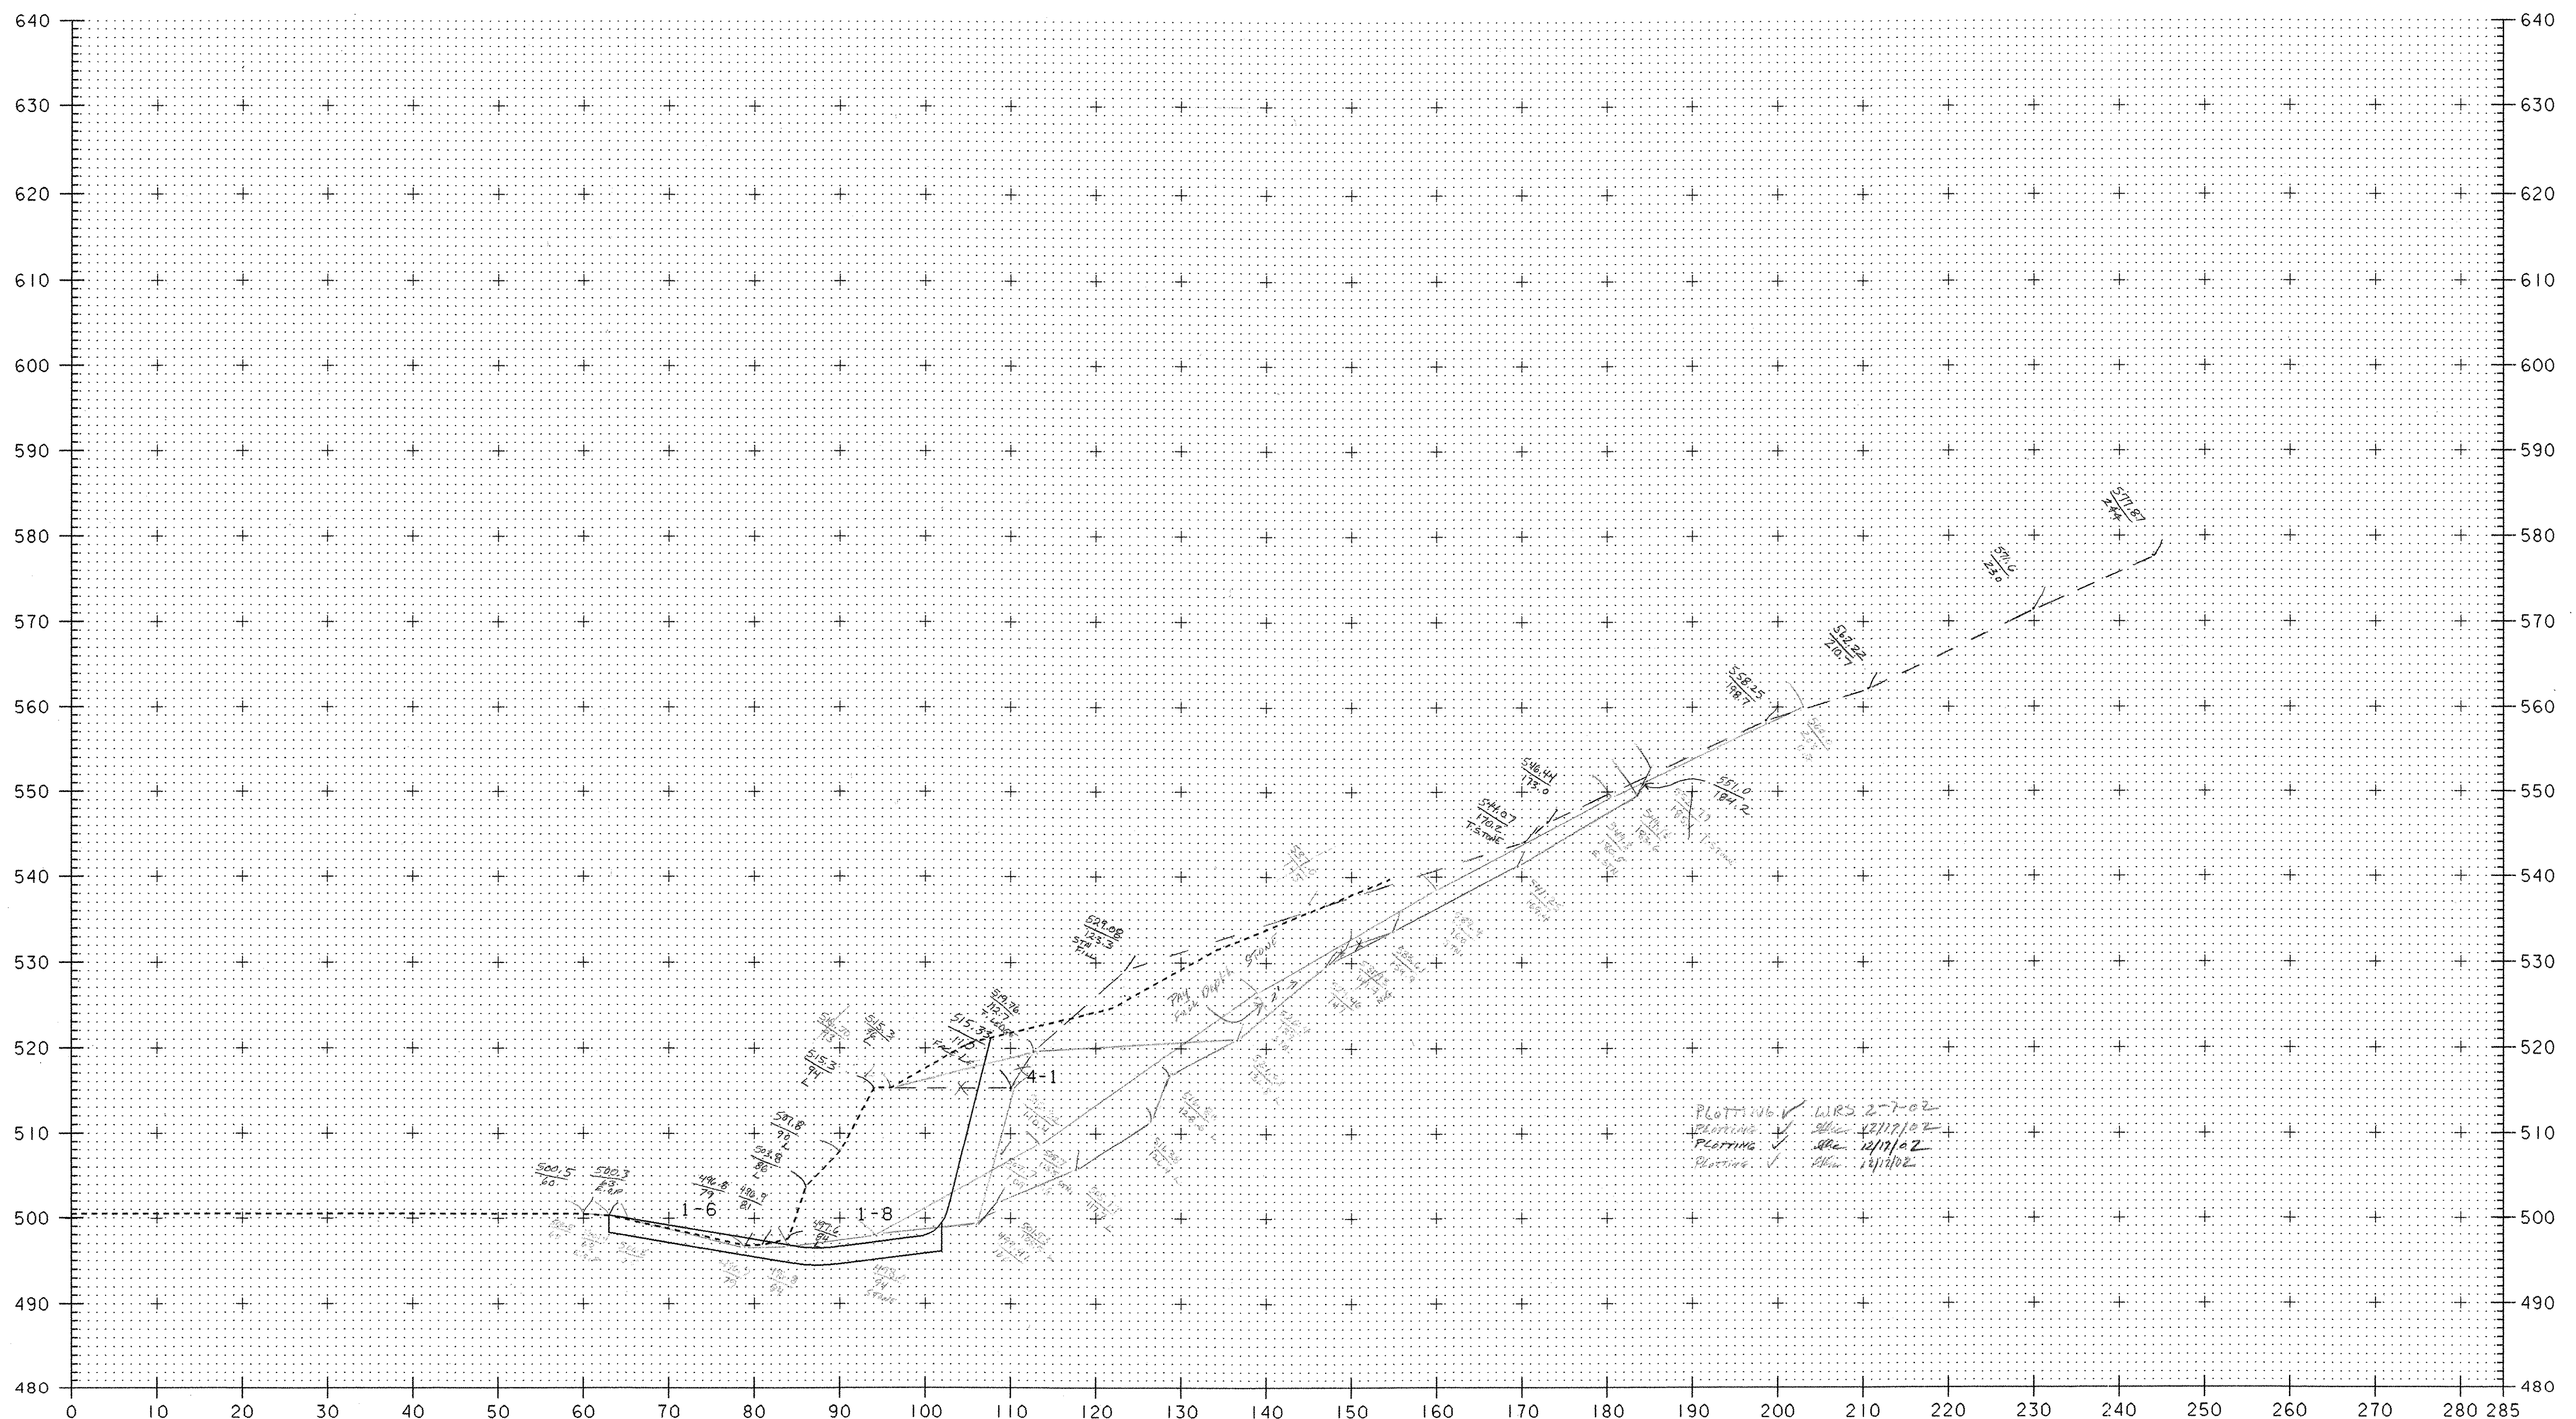

652+50 (NB OUTSIDE)  
LEDGE REMOVAL

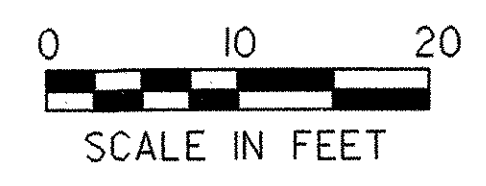

DATUM	
VERTICAL	assumed 500
HORIZONTAL	n/a

PROJECT: HARTFORD-ROYALTON	PROJECT NO.: IM IR 089-1(8)
DESIGN FILE NAME: /sqda/87a008/mml2.dgn	PLOT DATE: 12-MAR-1999
IPARM FILE NAME: ml2xsl9.i	SURVEY DATE: fall 92
SURVEYED BY: gilman	DRAWN BY: jf gruchacz
SQUAD LEADER: a. kreis	SHEET: 179 OF 260