


DATUM	
VERTICAL	assumed 500
HORIZONTAL	n/a

*LEDGE 0
@ 652+75
1-82*

652+75 (NB OUTSIDE)
LEDGE REMOVAL

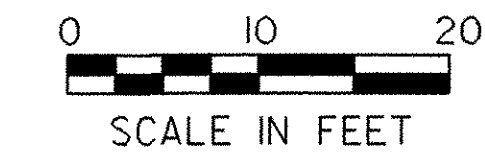

PROJECT: HARTFORD-ROYALTON	PROJECT NO.: IM IR 089-1(8)
DESIGN FILE NAME: /sqda/87a008/mml2.dgn	PLOT DATE: 12-MAR-1999
IPARM FILE NAME: ml2xs20.i	SURVEY DATE: fall 92
SURVEYED BY: gillman	DRAWN BY: jf gruchacz
SQUAD LEADER: a. kreis	SHEET: 180 OF 260

PLATTING ✓ WRS 2/7/02
 PLATTING ✓ WRS 12/17/02
 PLATTING ✓ WRS 11/17/02
 PLATTING ✓ WRS 11/17/02