


SEE SHEET 96

M.M. 13.0

MATCH LINE

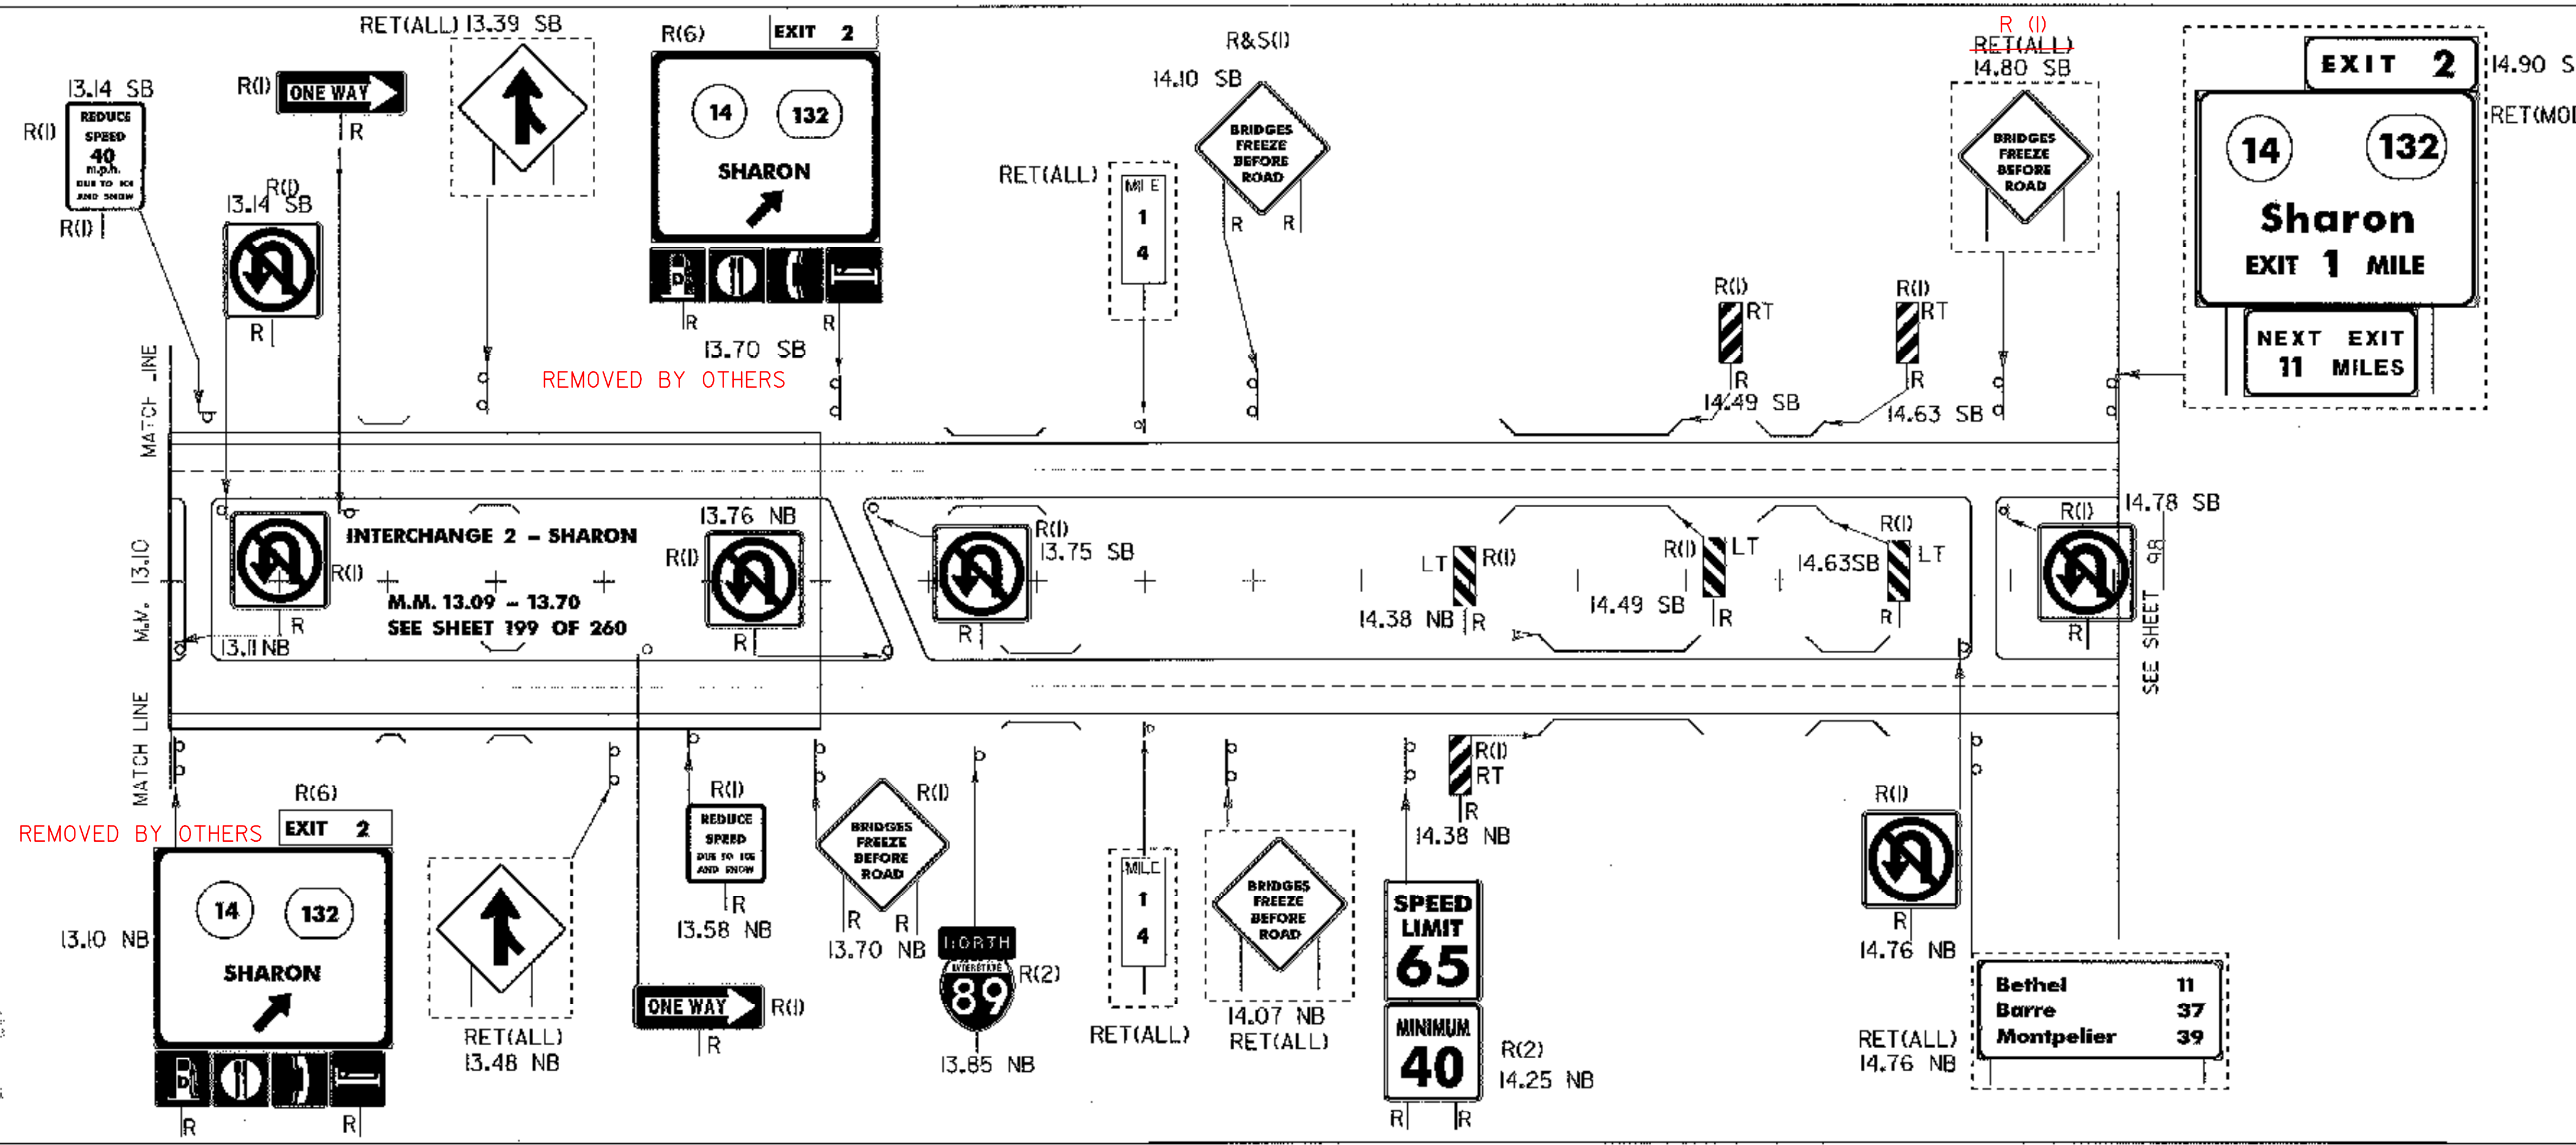

THINNING & TRIMMING, 201.31 FOR SIGNS (M.M. APPROX.)

	NB M.M.	SB M.M.
	12.45	12.65
	13.10	13.70
		14.21

REMOVING SIGNS

- NB 22
- SB 18

LEGEND

- R = REMOVE
- S = SALVAGED
- R&S = REMOVE AND SALVAGE
- RET = RETAIN

EXISTING SIGNS

PROJECT: HARTFORD-SHARON-ROYALTON	PROJECT NO.: IM IR 089-1(8)
DESIGN FILE NAME: /traf/87a008/ta008.dgn	PLOT DATE: 14-NOV-2000
IPARM FILE NAME: ta008i31	SURVEY DATE: 11/92
SURVEYED BY: LCS/LSW	DRAWN BY: LCS
SQUAD LEADER: DLP	SHEET: 186 OF 260

Bethel	11
Barre	37
Montpelier	39