

13.08 SB



SPEED LIMIT
65
MINIMUM
40

MILE 1 3

MATCH LINE

M.M. 3+0

MATCH LINE

RET(ALL)

MILE 1 0

RET(ALL)

MILE 1 1

10.86 SB

BRIDGE 13-1 I-89

11.76 SB

BRIDGE 13-2 I-89

RET(ALL)

MILE 1 2

12.38 SB

BRIDGE 14-1 I-89

12.65 SB
RET(ALL)

WHITE RIVER JCT. 15

12.34 SB

BRIDGE 14 I-89

MILE 1 3

SEE SHEET 104

RET(ALL)

MILE 1 0

RET(ALL)

MILE 1 1

10.86 NB

BRIDGE 13-1 I-89

11.76 NB

BRIDGE 13-2 I-89

EXIT 2
132 TO VERMONT 14
Sharon S. Royalton
1 MILE
NEXT EXIT 10 MILES

RET(ALL)

MILE 1 2

12.25 NB
STRAFFORD
NEXT RIGHT

12.28 NB

BRIDGE 14 I-89

12.38 NB

EXIT 2
132 TO VERMONT 14
Sharon S. Royalton
1/2 MILE

RET(ALL)


MILE 1 3

PLACE 25' BEYOND GORE

ONE WAY



13.14 SB

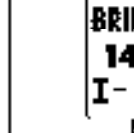

13.30 SB

BRIDGE 14-2 I-89

13.41 SB

BRIDGE 15-5 I-89

13.70 SB

EXIT 2

132 TO VERMONT 14
Sharon

13.90 SB

BRIDGE 16-5 I-89

14.10 SB

BRIDGES FREEZE BEFORE ROAD

14.21 SB

EXIT 2

132 TO VERMONT 14
Sharon
1/2 MILE

14.49 SB

BRIDGE 17-5 I-89

14.63 SB

BRIDGE 18-5 I-89

14.80 SB

BRIDGES FREEZE BEFORE ROAD

14.90 SB

RET(MOD.)

CHANGE ROUTE MARKERS

REMOVE "EXIT" CENTER "1 MILE"

USE PAY ITEM 675.21 MOD.

14.90 SB

RET(MOD.)

CHANGE ROUTE MARKERS

REMOVE "EXIT" CENTER "1 MILE"

USE PAY ITEM 675.21 MOD.

MATCH LINE

V.M. 13+0

MATCH LINE

SEE SHEET 106

LEGEND

- S - SALVAGED
- RET - RETAINED

ALL SIGNS AND POSTS ARE NEW UNLESS OTHERWISE NOTED.


NEW SIGNS

PROJECT:	HARTFORD-SHARON-ROYALTON	PROJECT NO.:	IM IR 089-1(8)
DESIGN FILE NAME:	/trnf/87a008/ta008i.dgn	PLOT DATE:	12-MAR-1999
IPARM FILE NAME:	ta008i.i	SURVEY DATE:	11/92
SURVEYED BY:	LCS/LSW	DRAWN BY:	LCS
SQUAD LEADER:	DLP	SHEET:	194 OF 260


Bethel	11
Barre	37
Montpelier	39

INTERCHANGE 2 - SHARON
M.M. 13.09 - 13.70

13.76 NB

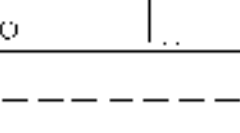

13.75 SB

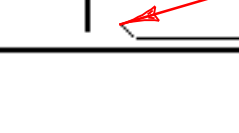

14.38 NB

& 13.91 NB

14.49 SB

14.63 NB

LT

LT

LT

14.78 SB



13.10 NB

EXIT 2

132 TO VERMONT 14

Sharon S. Royalton



13.30 NB

BRIDGE 14-2 I-89

13.38 NB

BRIDGE 15-N I-89

ONE WAY



PLACE 25' BEYOND GORE

RET(ALL)

13.48 NB

BRIDGES FREEZE BEFORE ROAD

13.70 NB

NORTH

ENGINEERED INTERSTATE SYSTEM

RET(ALL)

13.85 NB

MILE 1 4

BRIDGES FREEZE BEFORE ROAD

14.07 NB

RET(ALL)

14.25 NB

SPEED LIMIT 65

MINIMUM 40

14.38 NB

BRIDGE 17-N I-89

14.63 NB

BRIDGE 18-N I-89

14.76 NB

RET(ALL)

14.76 NB

Bethel 11

Barre 37

Montpelier 39