

**REMOVAL OF EXISTING DELINEATORS**

- RAMP "A" - 17
- RAMP "B" - 17
- RAMP "C" - 21
- RAMP "D" - 19

**LEGEND**

- TYPE I (AMBER) †
- TYPE I (WHITE) †
- TYPE II †
- TYPE III (AMBER) †
- TYPE III (WHITE) †


**DELINEATOR LAYOUT**

INTERCHANGE #2  
SHARON  
V.T. ROUTE 132

PREPARED BY LCS DATE 8/92  
 CHECKED BY DATE  
 DESIGN SUPERVISOR DLP DATE 8/92  
 PROJ.

**HARTFORD-SHARON-ROYALTON**

IM IR 089-1(B)  
 TRAFFIC SHEET NO. OF  
 SHEET 202 OF 260 SHEETS

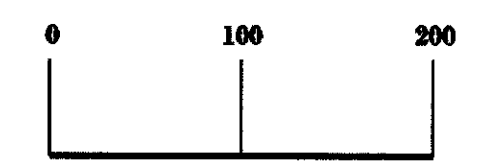

SCALE : 1 IN = 100FT