


CROSSOVER AT MM 9.70

DATUM
 VERTICAL ASSUMED
 HORIZONTAL NAD 83(1992)

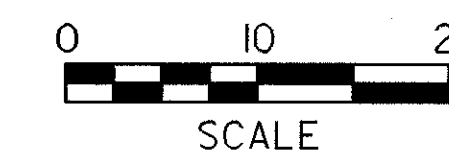

PROJECT: HARTFORD-SHAR-ROYALTON	PROJECT NO.: IM IR 089-(8)
DESIGN FILE NAME: /sqda/87a008g/da08nui.dgn	PLOT DATE: 12-MAR-1999
IPARM FILE NAME: da08gx01	SURVEY DATE: 7-98
SURVEYED BY: gilman	DRAWN BY: jf gruchacz
SQUAD LEADER: bombardier	SHEET: 246 OF 260