


**LEGEND**

- TYPE III BARRICADES.
- FLASHING ARROW PANEL
- CONCRETE MEDIAN BARRIER
- PAVEMENT MARKING REMOVAL
- REFLECTORIZED PLASTIC DRUM
- TYPE I DELINEATOR (YELLOW)
- TYPE I DELINEATOR (WHITE)
- FLOW OF TRAFFIC

REQUIRED STDS. E-103, E-104, E-104a, E-107a

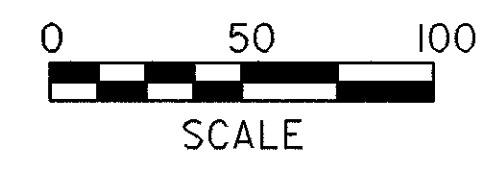

**CROSSOVER AT MM 13.00**

DATUM	
VERTICAL	ASSUMED
HORIZONTAL	NAD83(1992)

PROJECT: Hartford-Royalton	PROJECT NO. : IM IR 089-1(8)
DESIGN FILE NAME: /sqda/87a008g/da08nul.dgn	PLOT DATE: 12-MAR-1999
IPARM FILE NAME: da08gl03.1	SURVEY DATE: 7-98
SURVEYED BY: gilman	DRAWN BY: jfg
SQUAD LEADER: bombardier	SHEET: 251 OF 260