


DATUM  
 VERTICAL ASSUMED  
 HORIZONTAL NAD83(1992)

- LEGEND**
- - TYPE III BARRICADES.
  - ▤ - FLASHING ARROW PANEL
  - ▬ - CONCRETE MEDIAN BARRIER
  - /// - PAVEMENT MARKING REMOVAL
  - - REFLECTORIZED PLASTIC DRUM
  - - TYPE I DELINEATOR (YELLOW)
  - - TYPE I DELINEATOR (WHITE)
  - ← - FLOW OF TRAFFIC

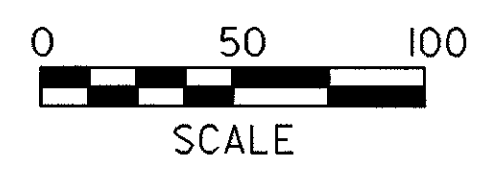

### CROSSOVER AT MM 13.00

REQUIRED STDS. E-103, E-104, E-104a, E-107a

PROJECT: Hartford-Royalton	PROJECT NO.: IM IR 089-1(8)
DESIGN FILE NAME: /sqda/87a008g/da08nui.dgn	PLOT DATE: 12-MAR-1999
IPARM FILE NAME: da08gl05.i	SURVEY DATE: 7-98
SURVEYED BY: gilman	DRAWN BY: jfg
SQUAD LEADER: bombardier	SHEET: 253 OF 260