


DATUM
 VERTICAL _____
 HORIZONTAL _____

crossover profile at mm 12.85

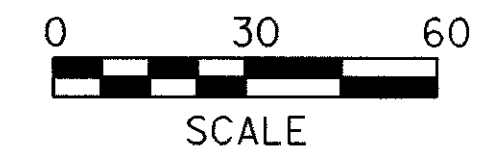

PROJECT: Hartford-Shar-Royalton	PROJECT NO. : IM IR 089-I(8)
DESIGN FILE NAME: /sqda/87a008g/da008gwr.dgn	PLOT DATE: 12-MAR-1999
IPARM FILE NAME: da08gpi3.i	SURVEY DATE: 7-98
SURVEYED BY: gilman	DRAWN BY: jfg
SQUAD LEADER: bombardier	SHEET: 254 OF 260