


### CROSSOVER AT MM 13.00

<b>DATUM</b>	
VERTICAL	ASSUMED
HORIZONTAL	NAD 83(1992)

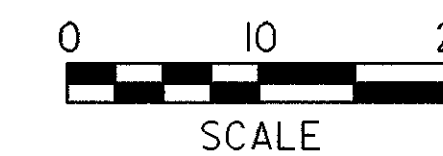

PROJECT: HARTFORD-SHAR-ROYALTON	PROJECT NO.: IM IR 089-I(8)
DESIGN FILE NAME: /sqda/87a008g/da08nul.dgn	PLOT DATE: 12-MAR-1999
IPARM FILE NAME: da08g×07	SURVEY DATE: 7-98
SURVEYED BY: gilman	DRAWN BY: jf gruchacz
SQUAD LEADER: bombardier	SHEET: 255 OF 260