


REVISIONS
 DATE BY CHECKED BY
 1/15/90 J. SMITH

STA. 9+80 LT.
 END EXCAVATION OF SOLID ROCK.

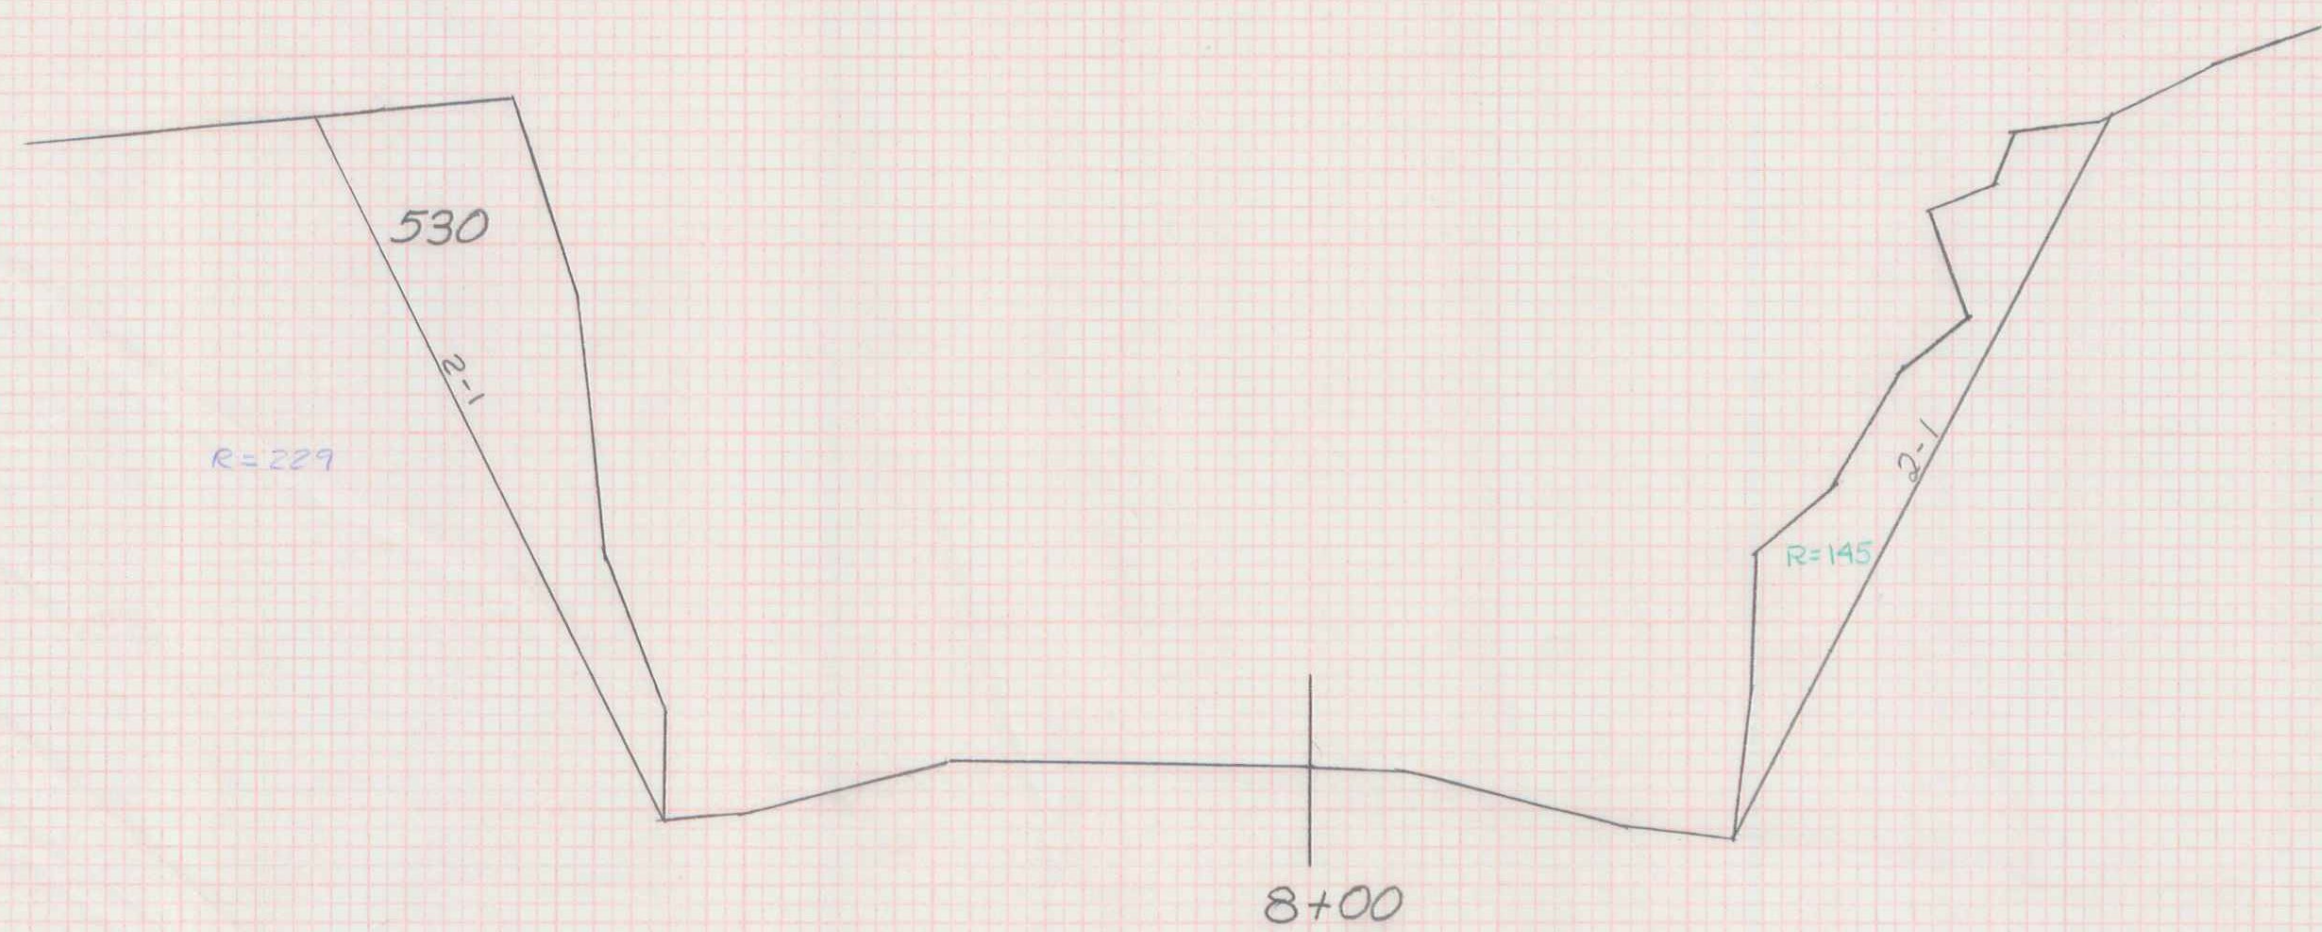

DATE	BY	CHECKED

DATE	BY	CHECKED

EXIT 8 - RAMP 'B'

MM	51.50	MM	N/A
STA	N/A	STa	N/A
TOWN	SPRINGFIELD-HARTFORD		
PROJECT	IR 091-1(20)		
HORIZ. & VERT. SCALES			
1"=10'			
DATE	JAN. '90		
SHEET	72	OF	133 SHEETS