

FINAL SURVEY NOTE BOOK No. _____ DATE _____ BY _____

SUBMITTED BY _____

REVISIONS BY _____

DATE _____

AREA CHECKED _____

ORIGINAL SURVEY NOTE BOOK No. _____ DATE _____ BY _____

SUBMITTED BY _____

REVISIONS BY _____

DATE _____


AREA CHECKED _____

510



10+25


510

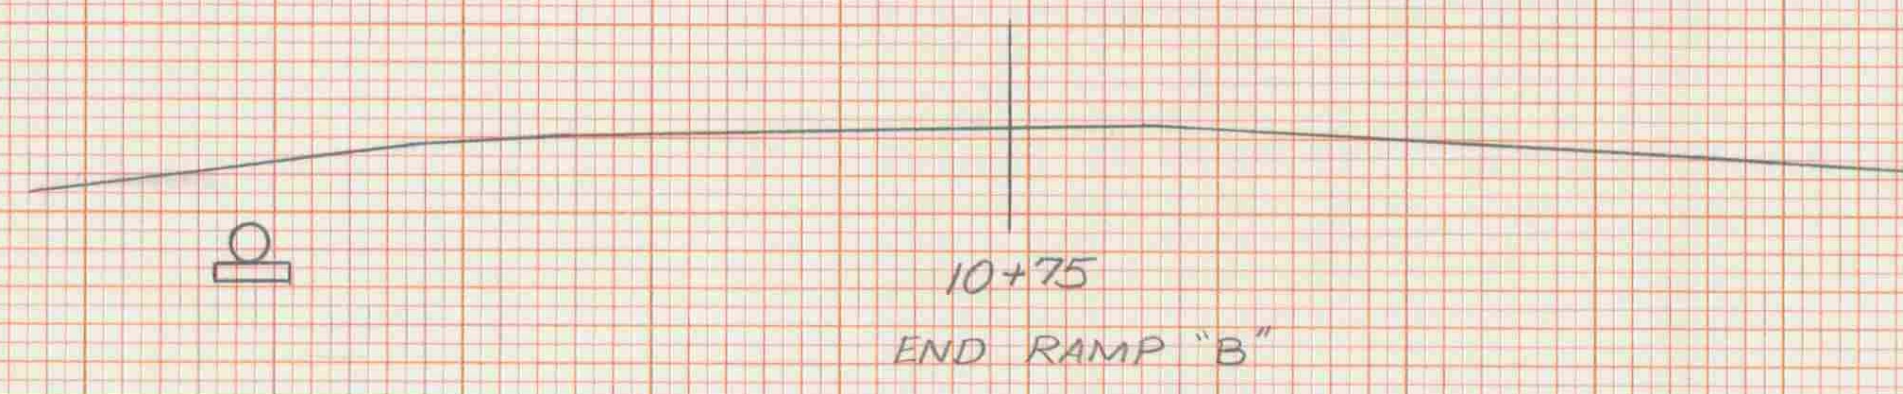

10+75
END RAMP "B"


STA 10+60 RT.
END EXCAVATION OF SOLID ROCK.

520

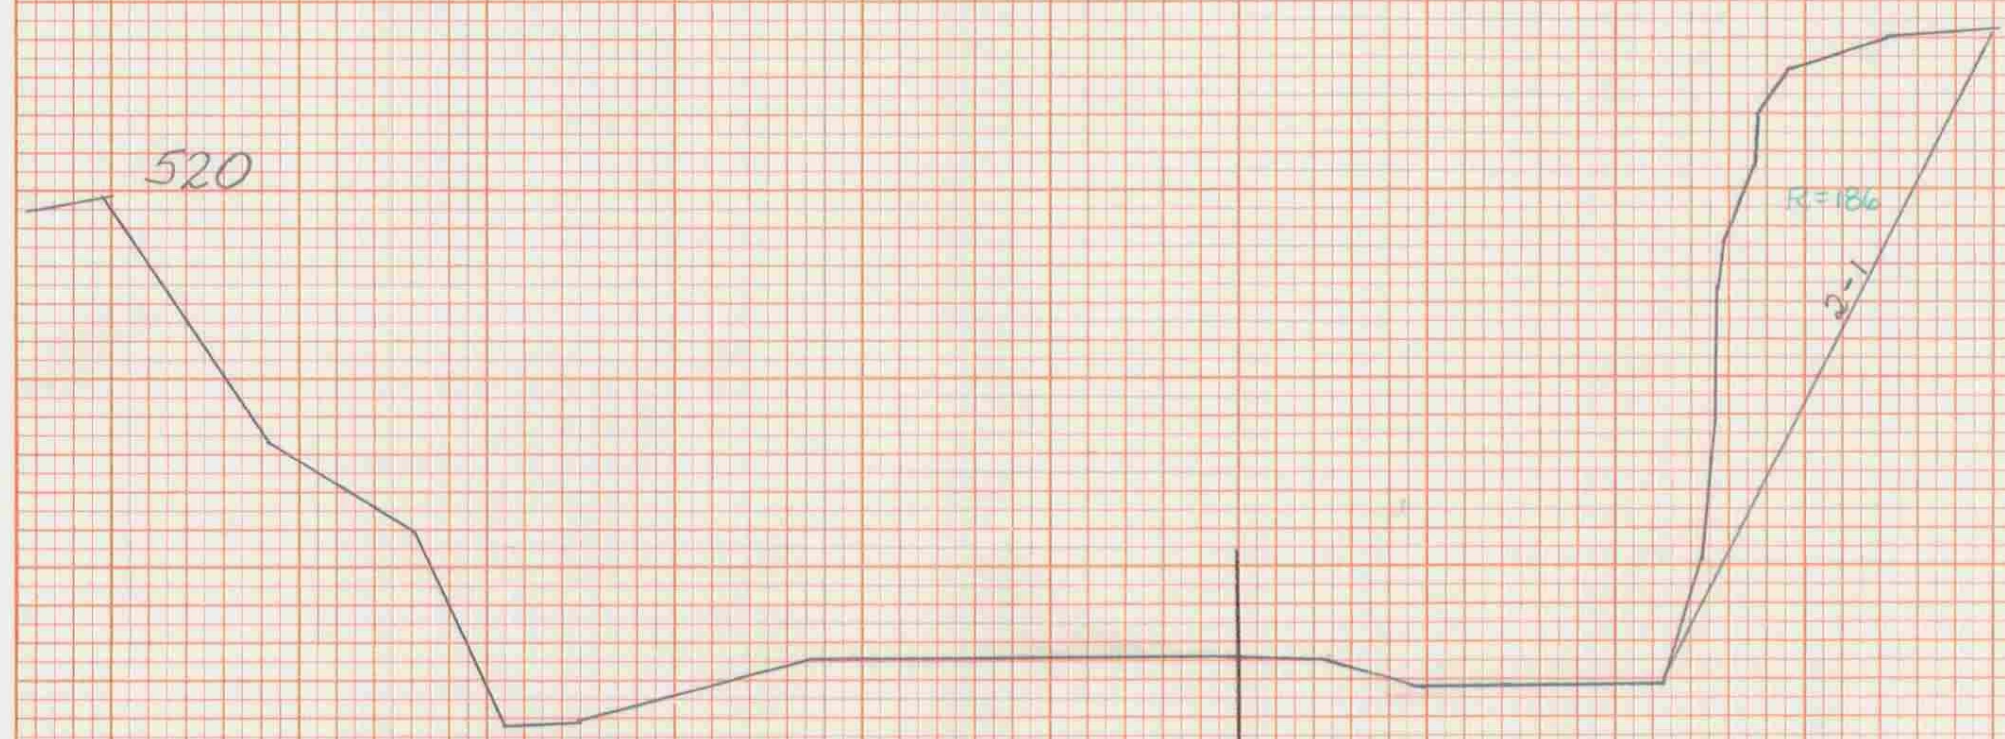

10+00

510

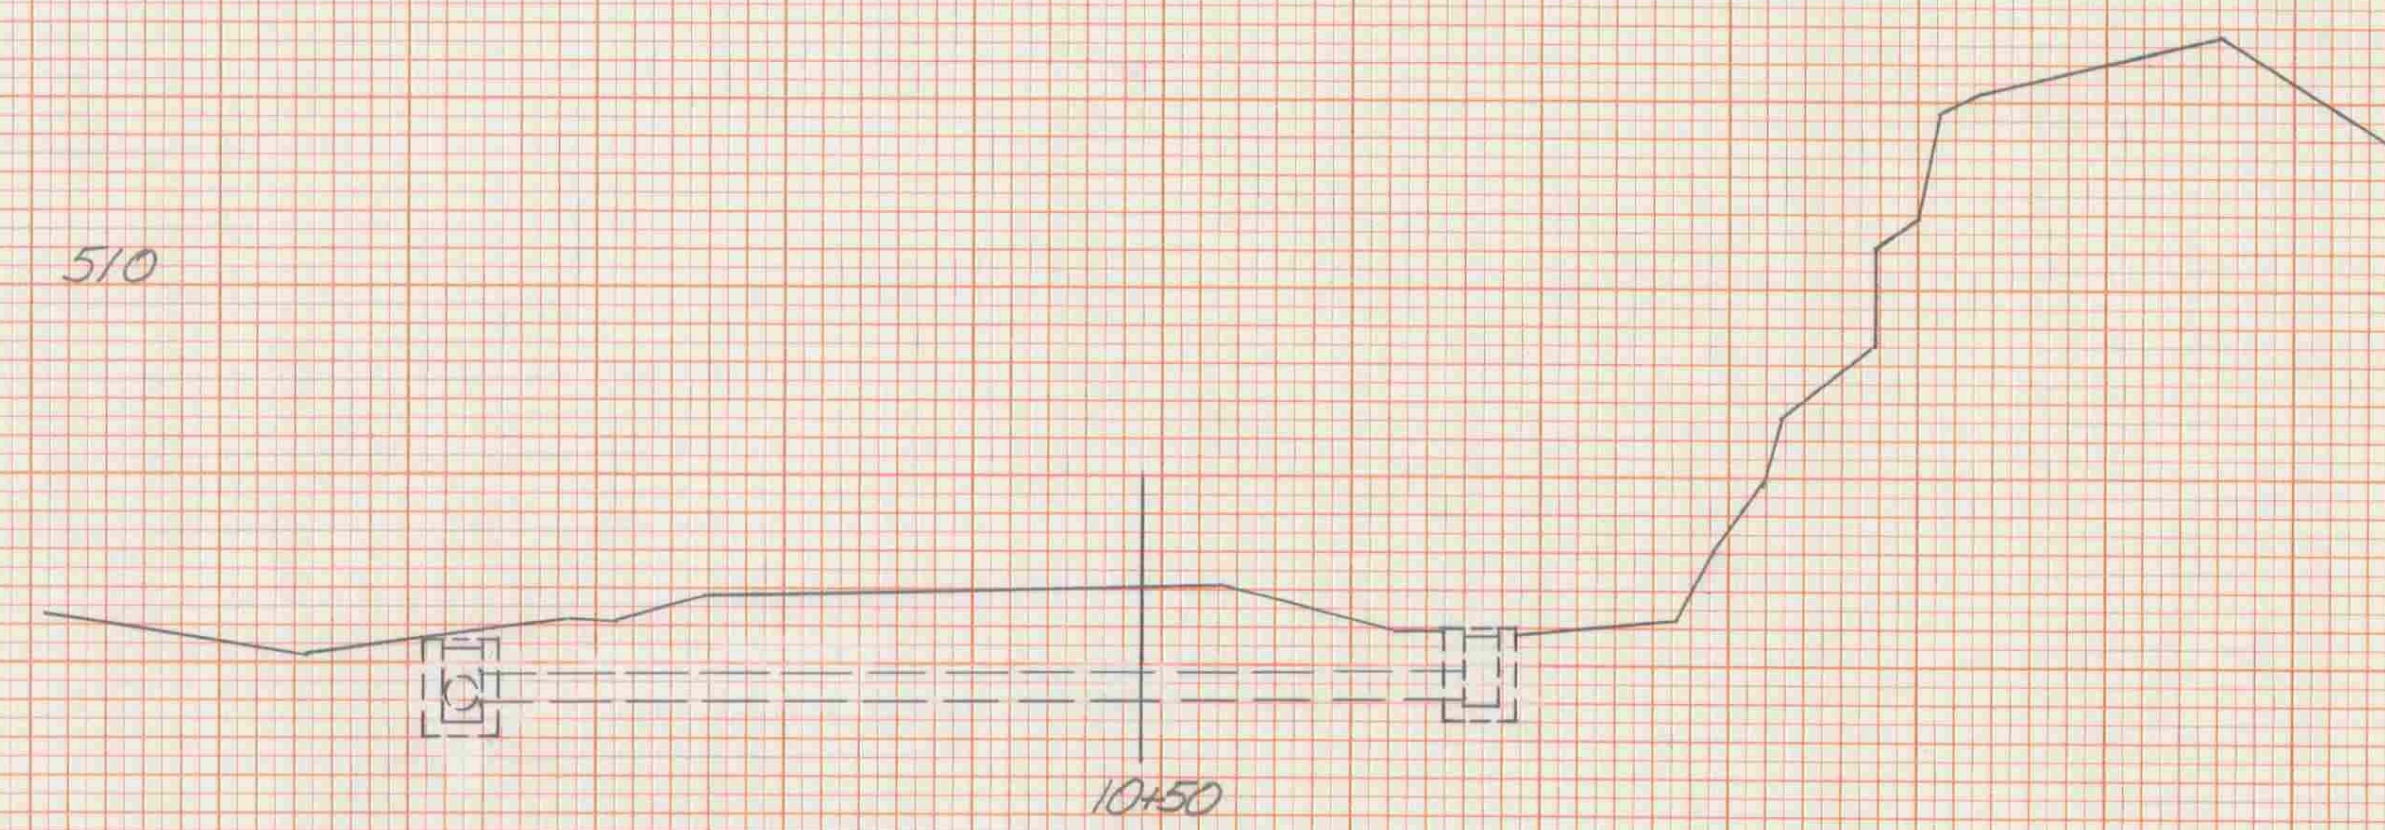

10+50

EXIT 8 - RAMP 'B'

MM	51.50	MM	N/A
STA	N/A	STA	N/A
TOWN	SPRINGFIELD-HARTFORD		
PROJECT	IR 091-1(20)		
HORIZ. & VERT. SCALES			
1"=10'	-----		
DATE :	JAN '90		
SHEET	73	OF	133 SHEETS