


DATE	
BY	
APPROVED	
FINAL SURVEY	
NOTE BOOK	
AREA	
FIELD CHECKED	

DATE	
BY	
APPROVED	
ORIGINAL SURVEY	
NOTE BOOK	
AREA	
FIELD CHECKED	

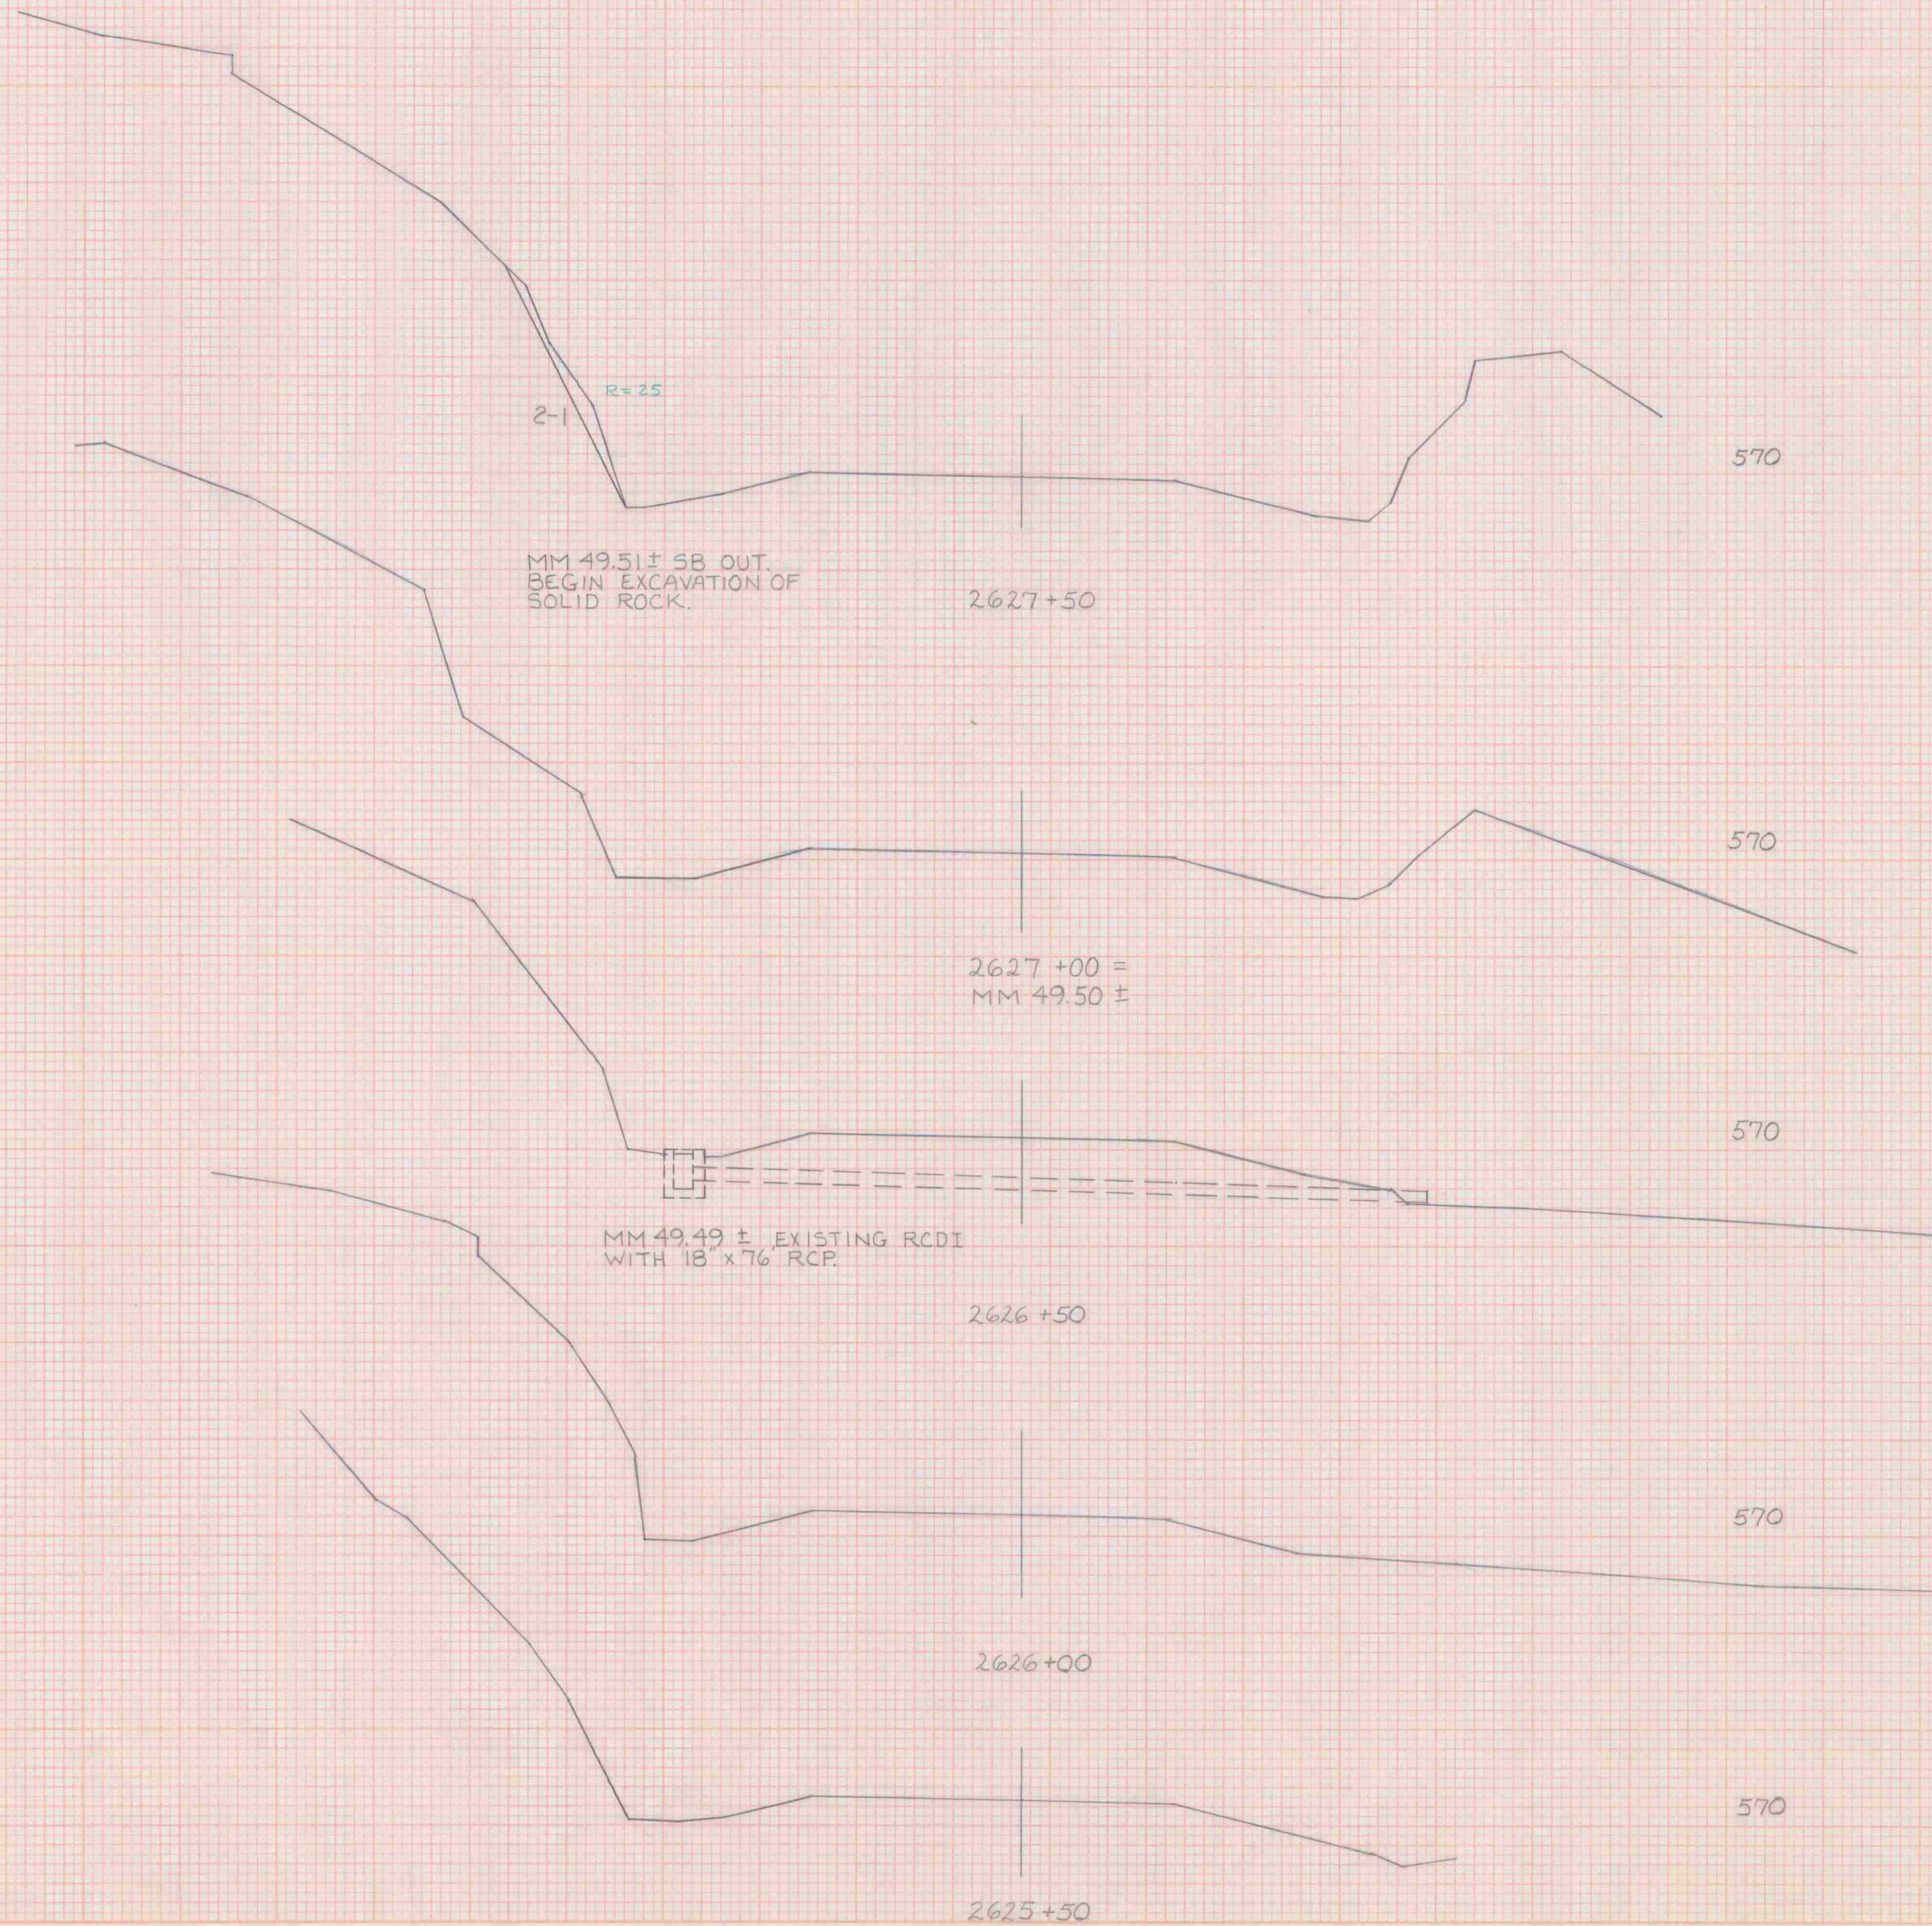

MM 49.51 MM 49.59
 STA. 2625+50 STA. 2627+50
 TOWN SPRINGFIELD-HARTFORD
 PROJECT IR NO 091-11201
 SHEET 82 OF 133 SHEETS
 HORIZ. AND VERT. SCALE
 1" = 10'
 DATE: JAN. '90