


DATE	
BY	
APPROVED	
SUPPLY	
NOTE BOOK	
NO.	

DATE	
BY	
APPROVED	
SUPPLY	
NOTE BOOK	
NO.	

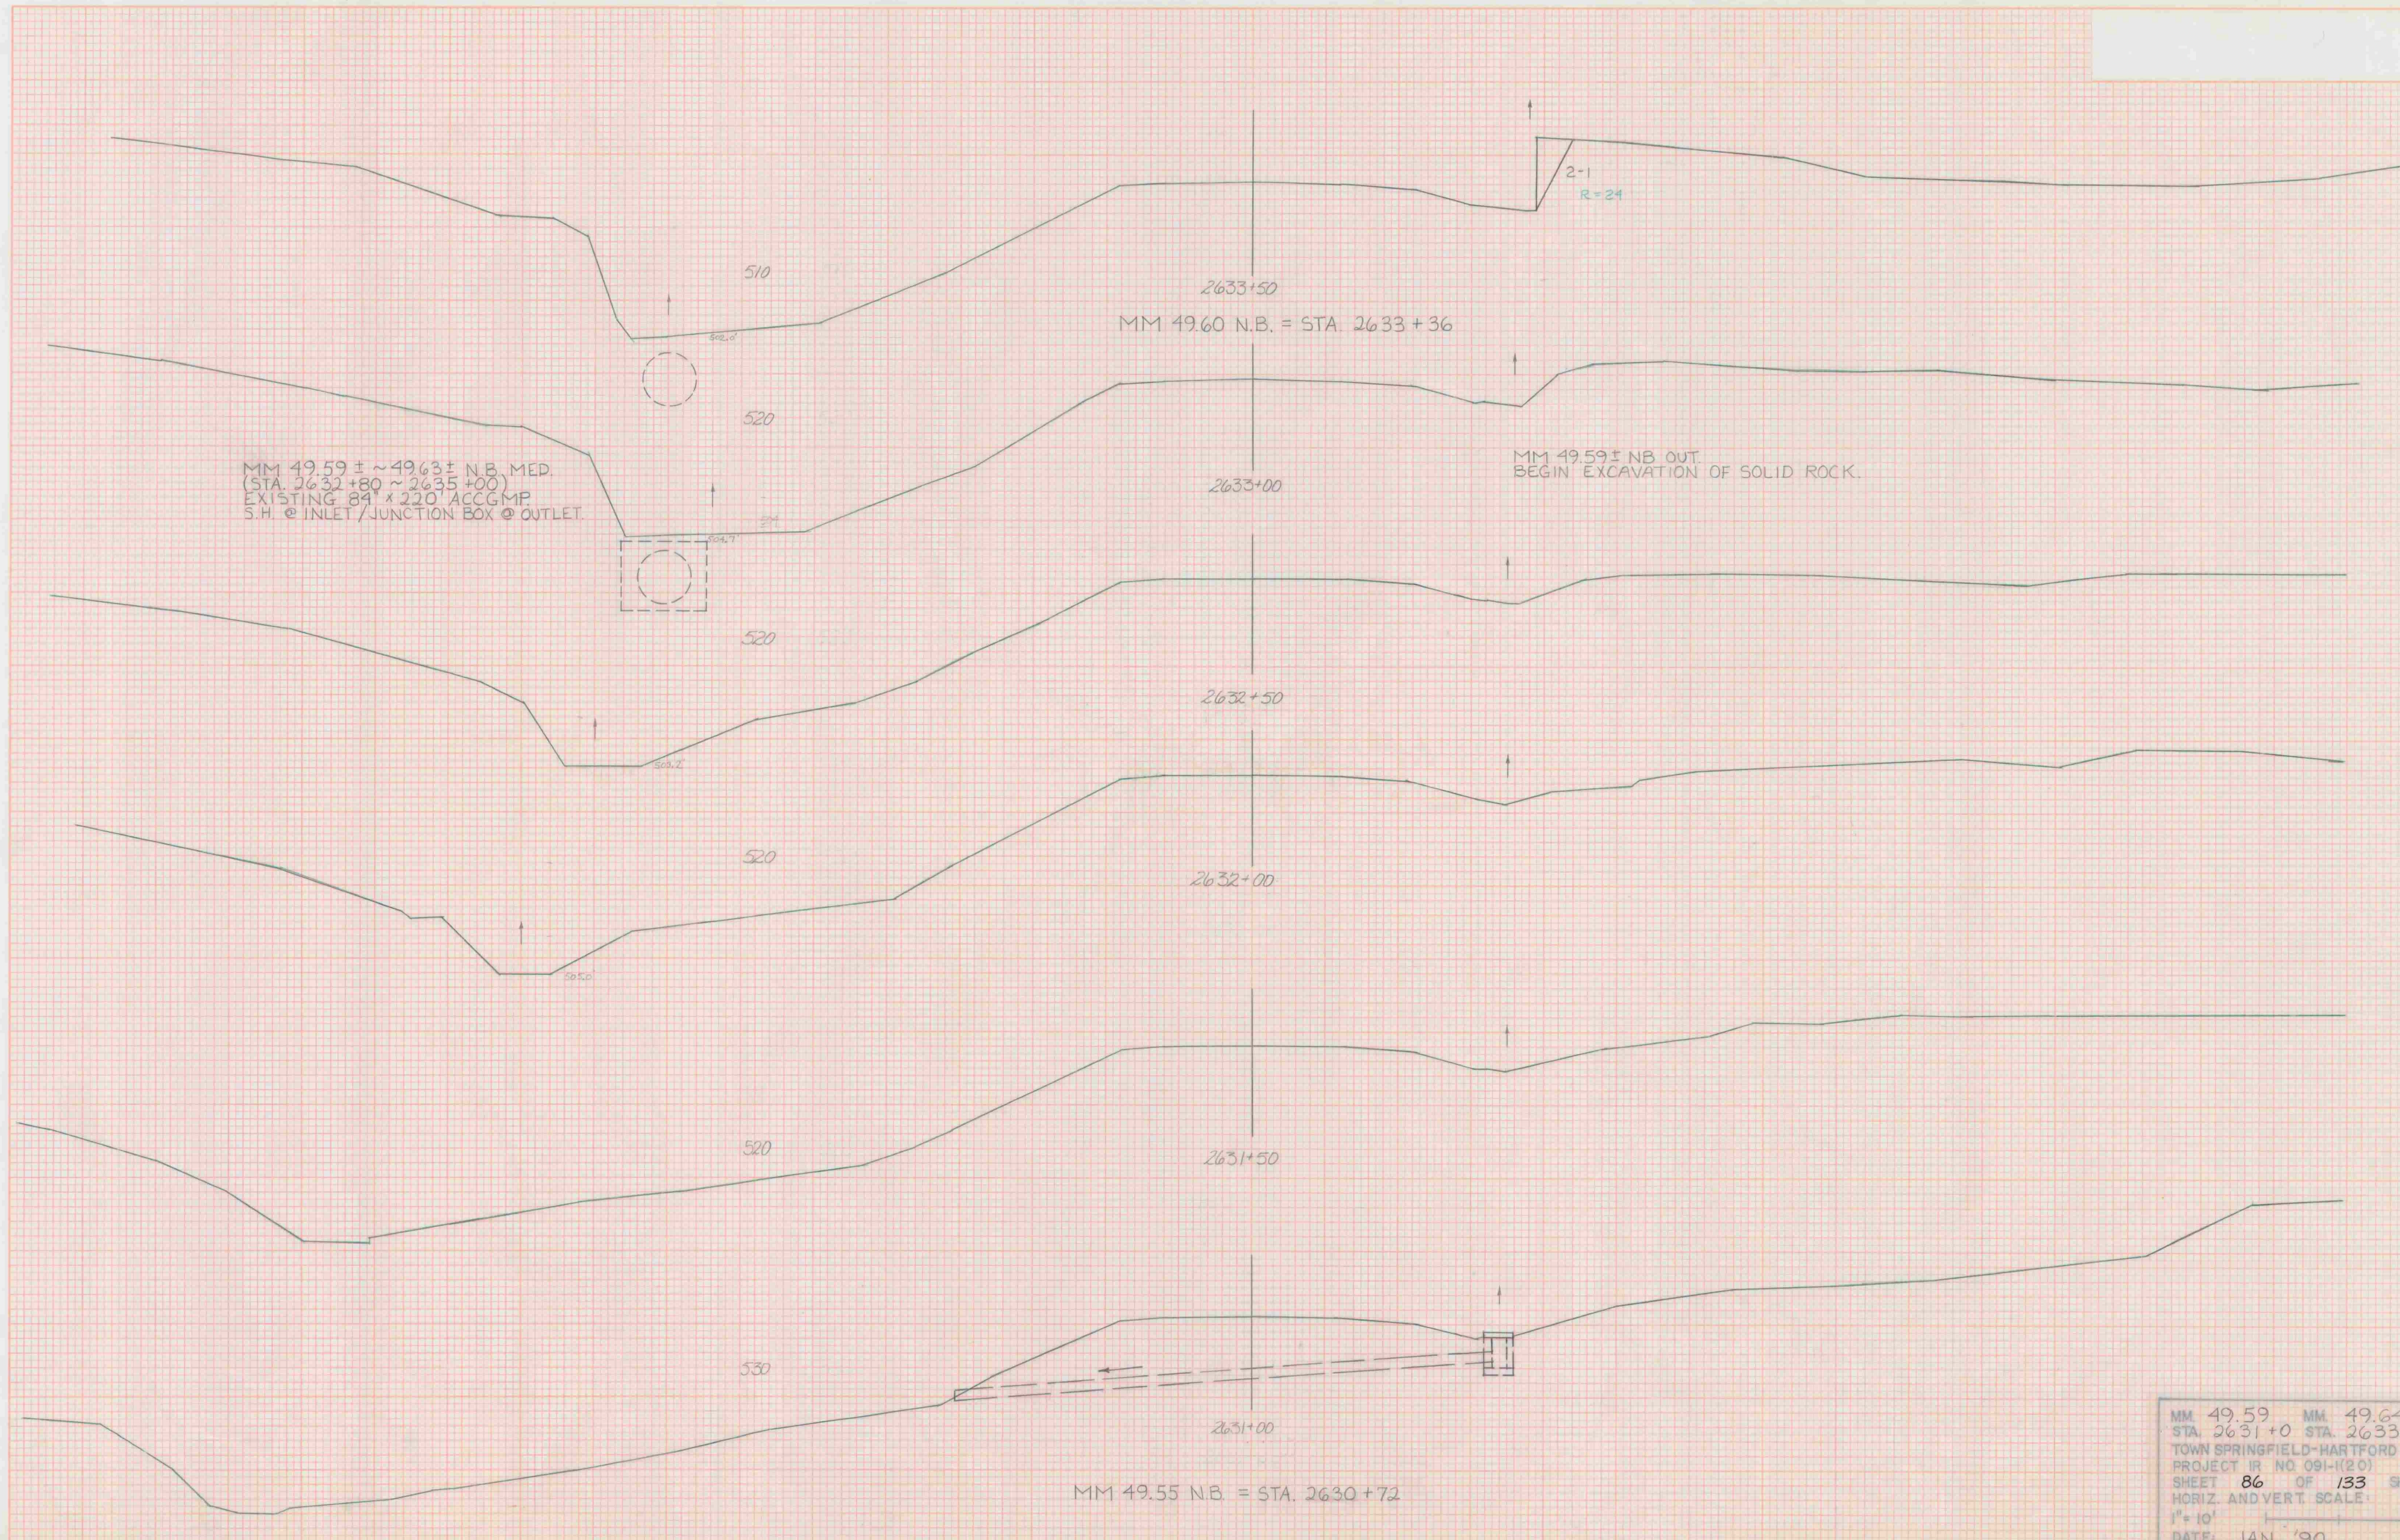

MM 49.59 MM 49.64
STA. 2631+0 STA. 2633+50
TOWN SPRINGFIELD-HARTFORD
PROJECT IR NO 091-(120)
SHEET 86 OF 133 SHEETS
HORIZ. AND VERT. SCALE:
1" = 10'
DATE: JAN. '90