


DATE: \_\_\_\_\_ BY: \_\_\_\_\_  
 ORIGINAL SURVEY WHITE BOOK SHEETS CHECKED: \_\_\_\_\_  
 SURVEYED: \_\_\_\_\_  
 TEMPLATE: \_\_\_\_\_  
 AREA: \_\_\_\_\_  
 SCALE: \_\_\_\_\_

DATE: \_\_\_\_\_ BY: \_\_\_\_\_  
 ORIGINAL SURVEY WHITE BOOK SHEETS CHECKED: \_\_\_\_\_  
 SURVEYED: \_\_\_\_\_  
 TEMPLATE: \_\_\_\_\_  
 AREA: \_\_\_\_\_  
 SCALE: \_\_\_\_\_

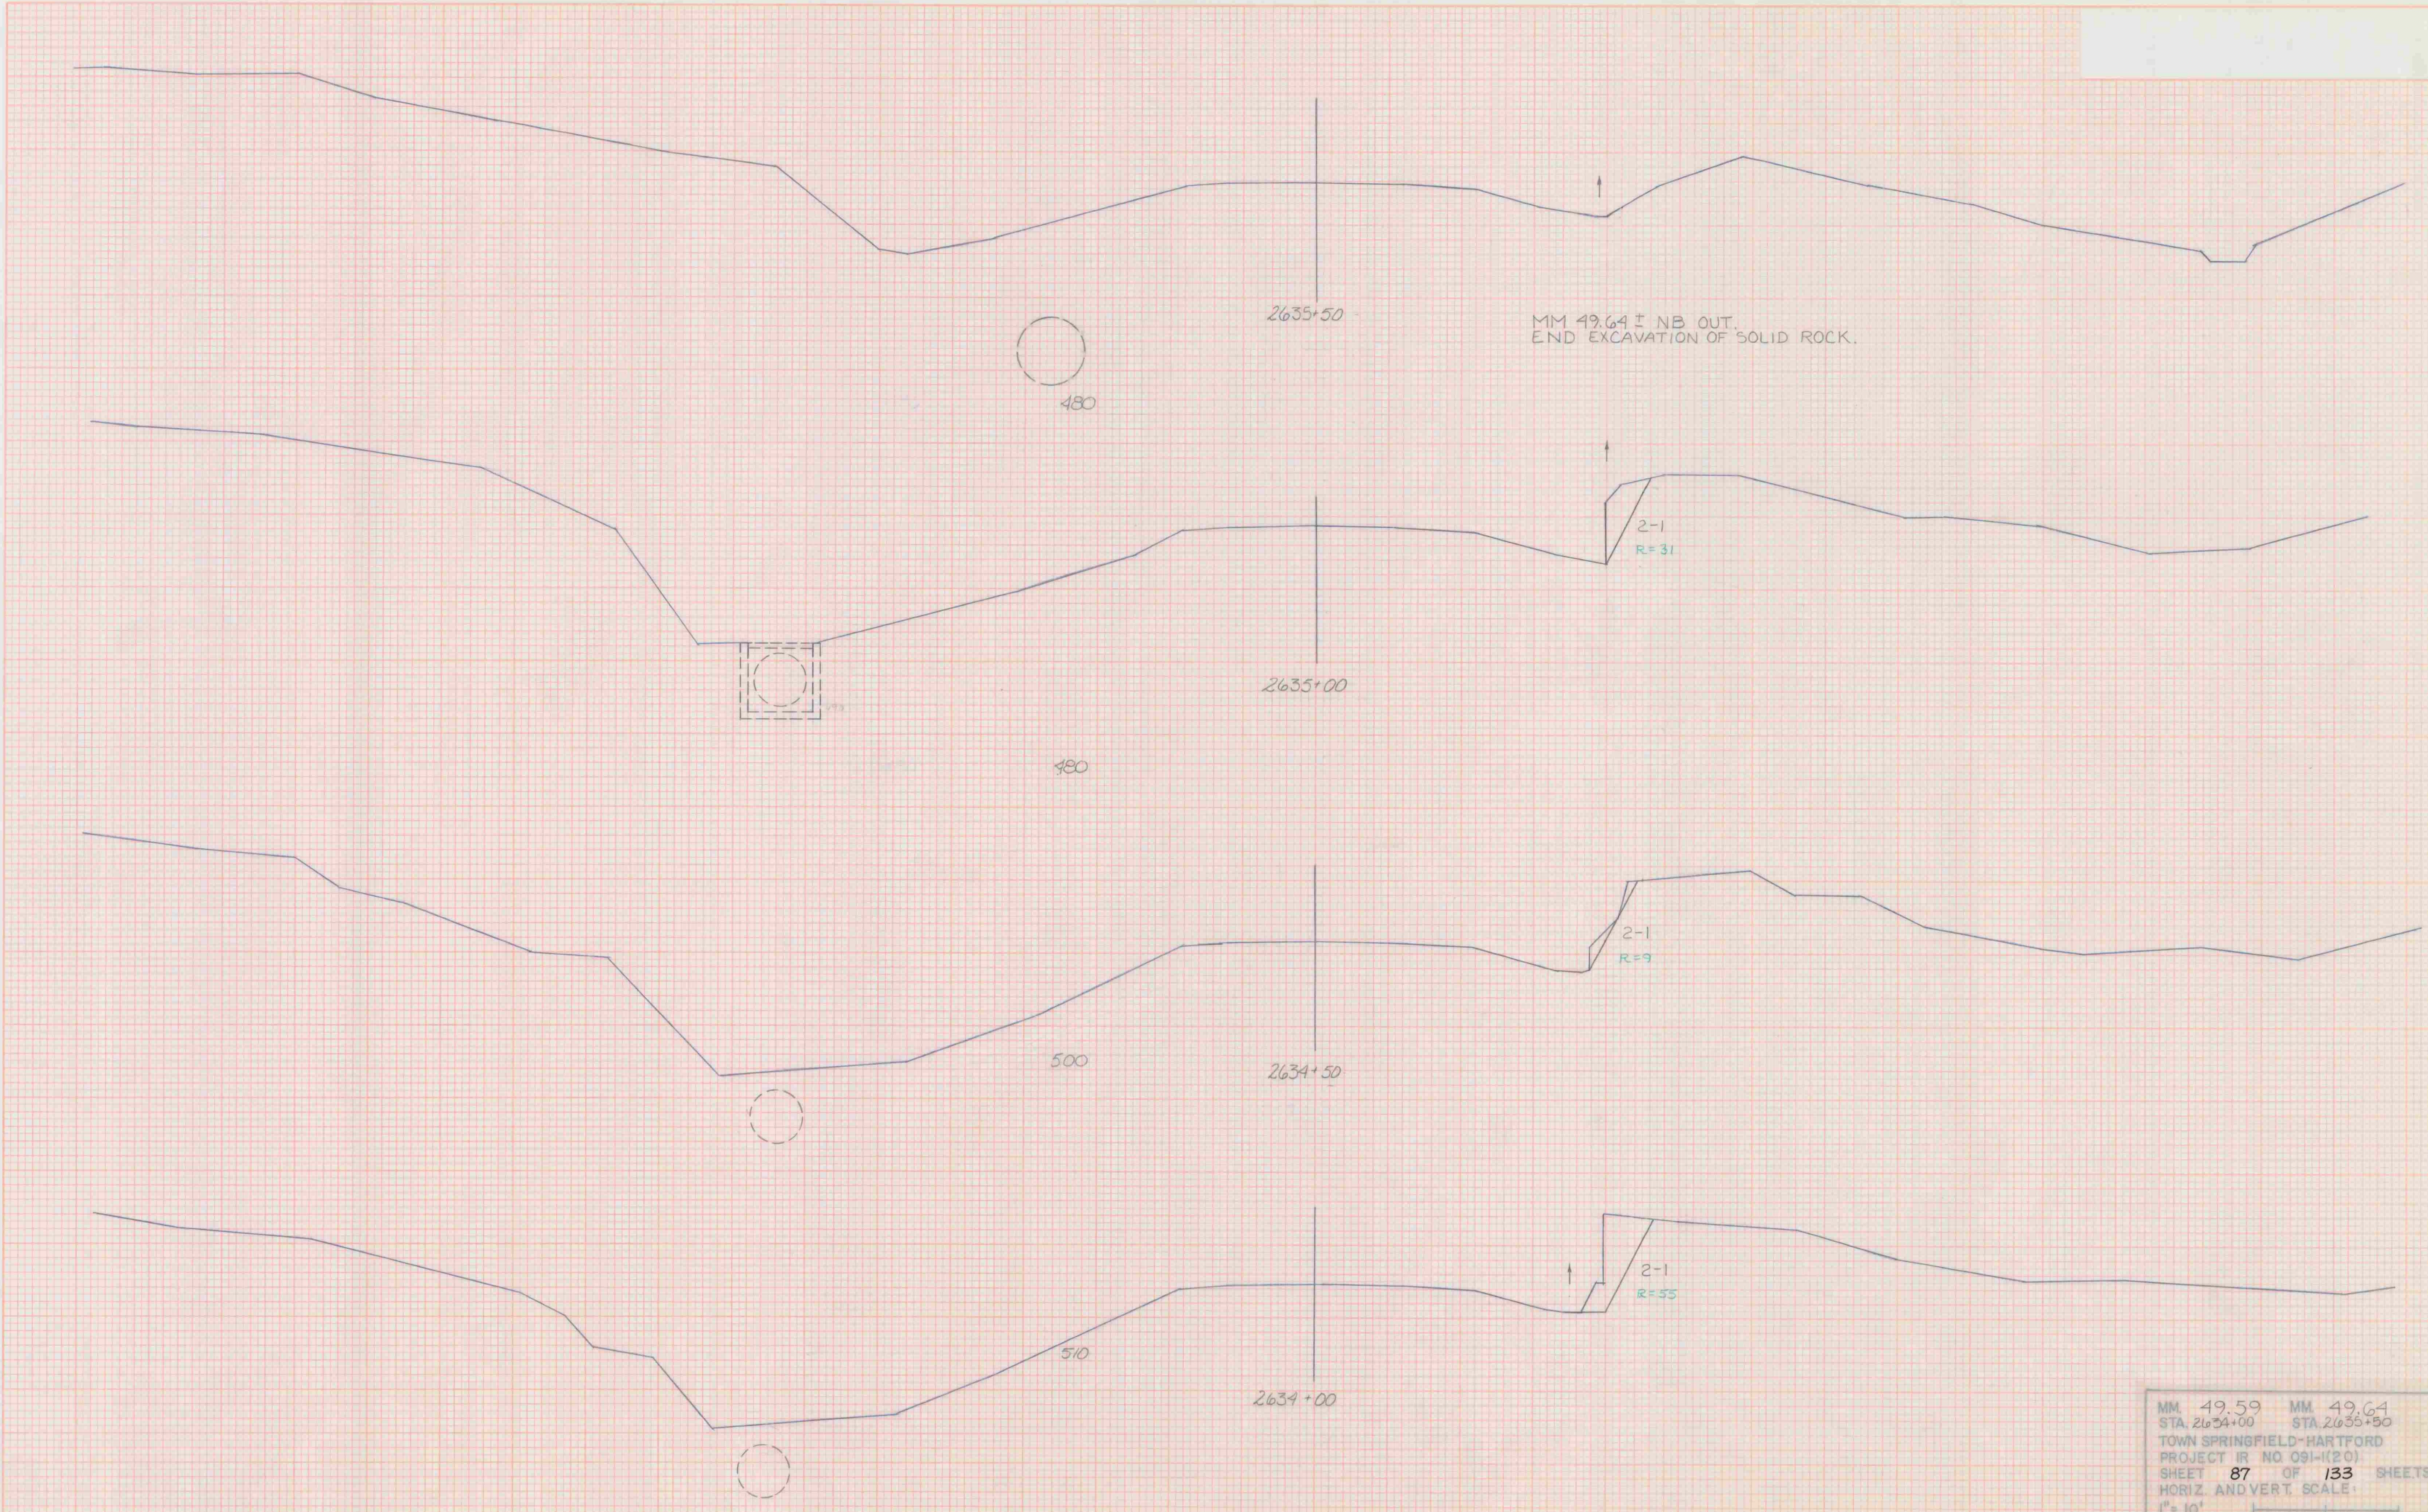

MM. 49.59 STA. 2634+00    MM. 49.64 STA. 2635+50  
 TOWN SPRINGFIELD-HARTFORD  
 PROJECT IR NO 091-1(20)  
 SHEET 87 OF 133 SHEETS  
 HORIZ. AND VERT. SCALE:  
 1" = 10'  
 DATE: JAN. '90