


DATE	
BY	
REVISIONS	
NO.	DESCRIPTION
1	
2	
3	
4	
5	
6	
7	
8	
9	
10	

DATE	
BY	
REVISIONS	
NO.	DESCRIPTION
1	
2	
3	
4	
5	
6	
7	
8	
9	
10	

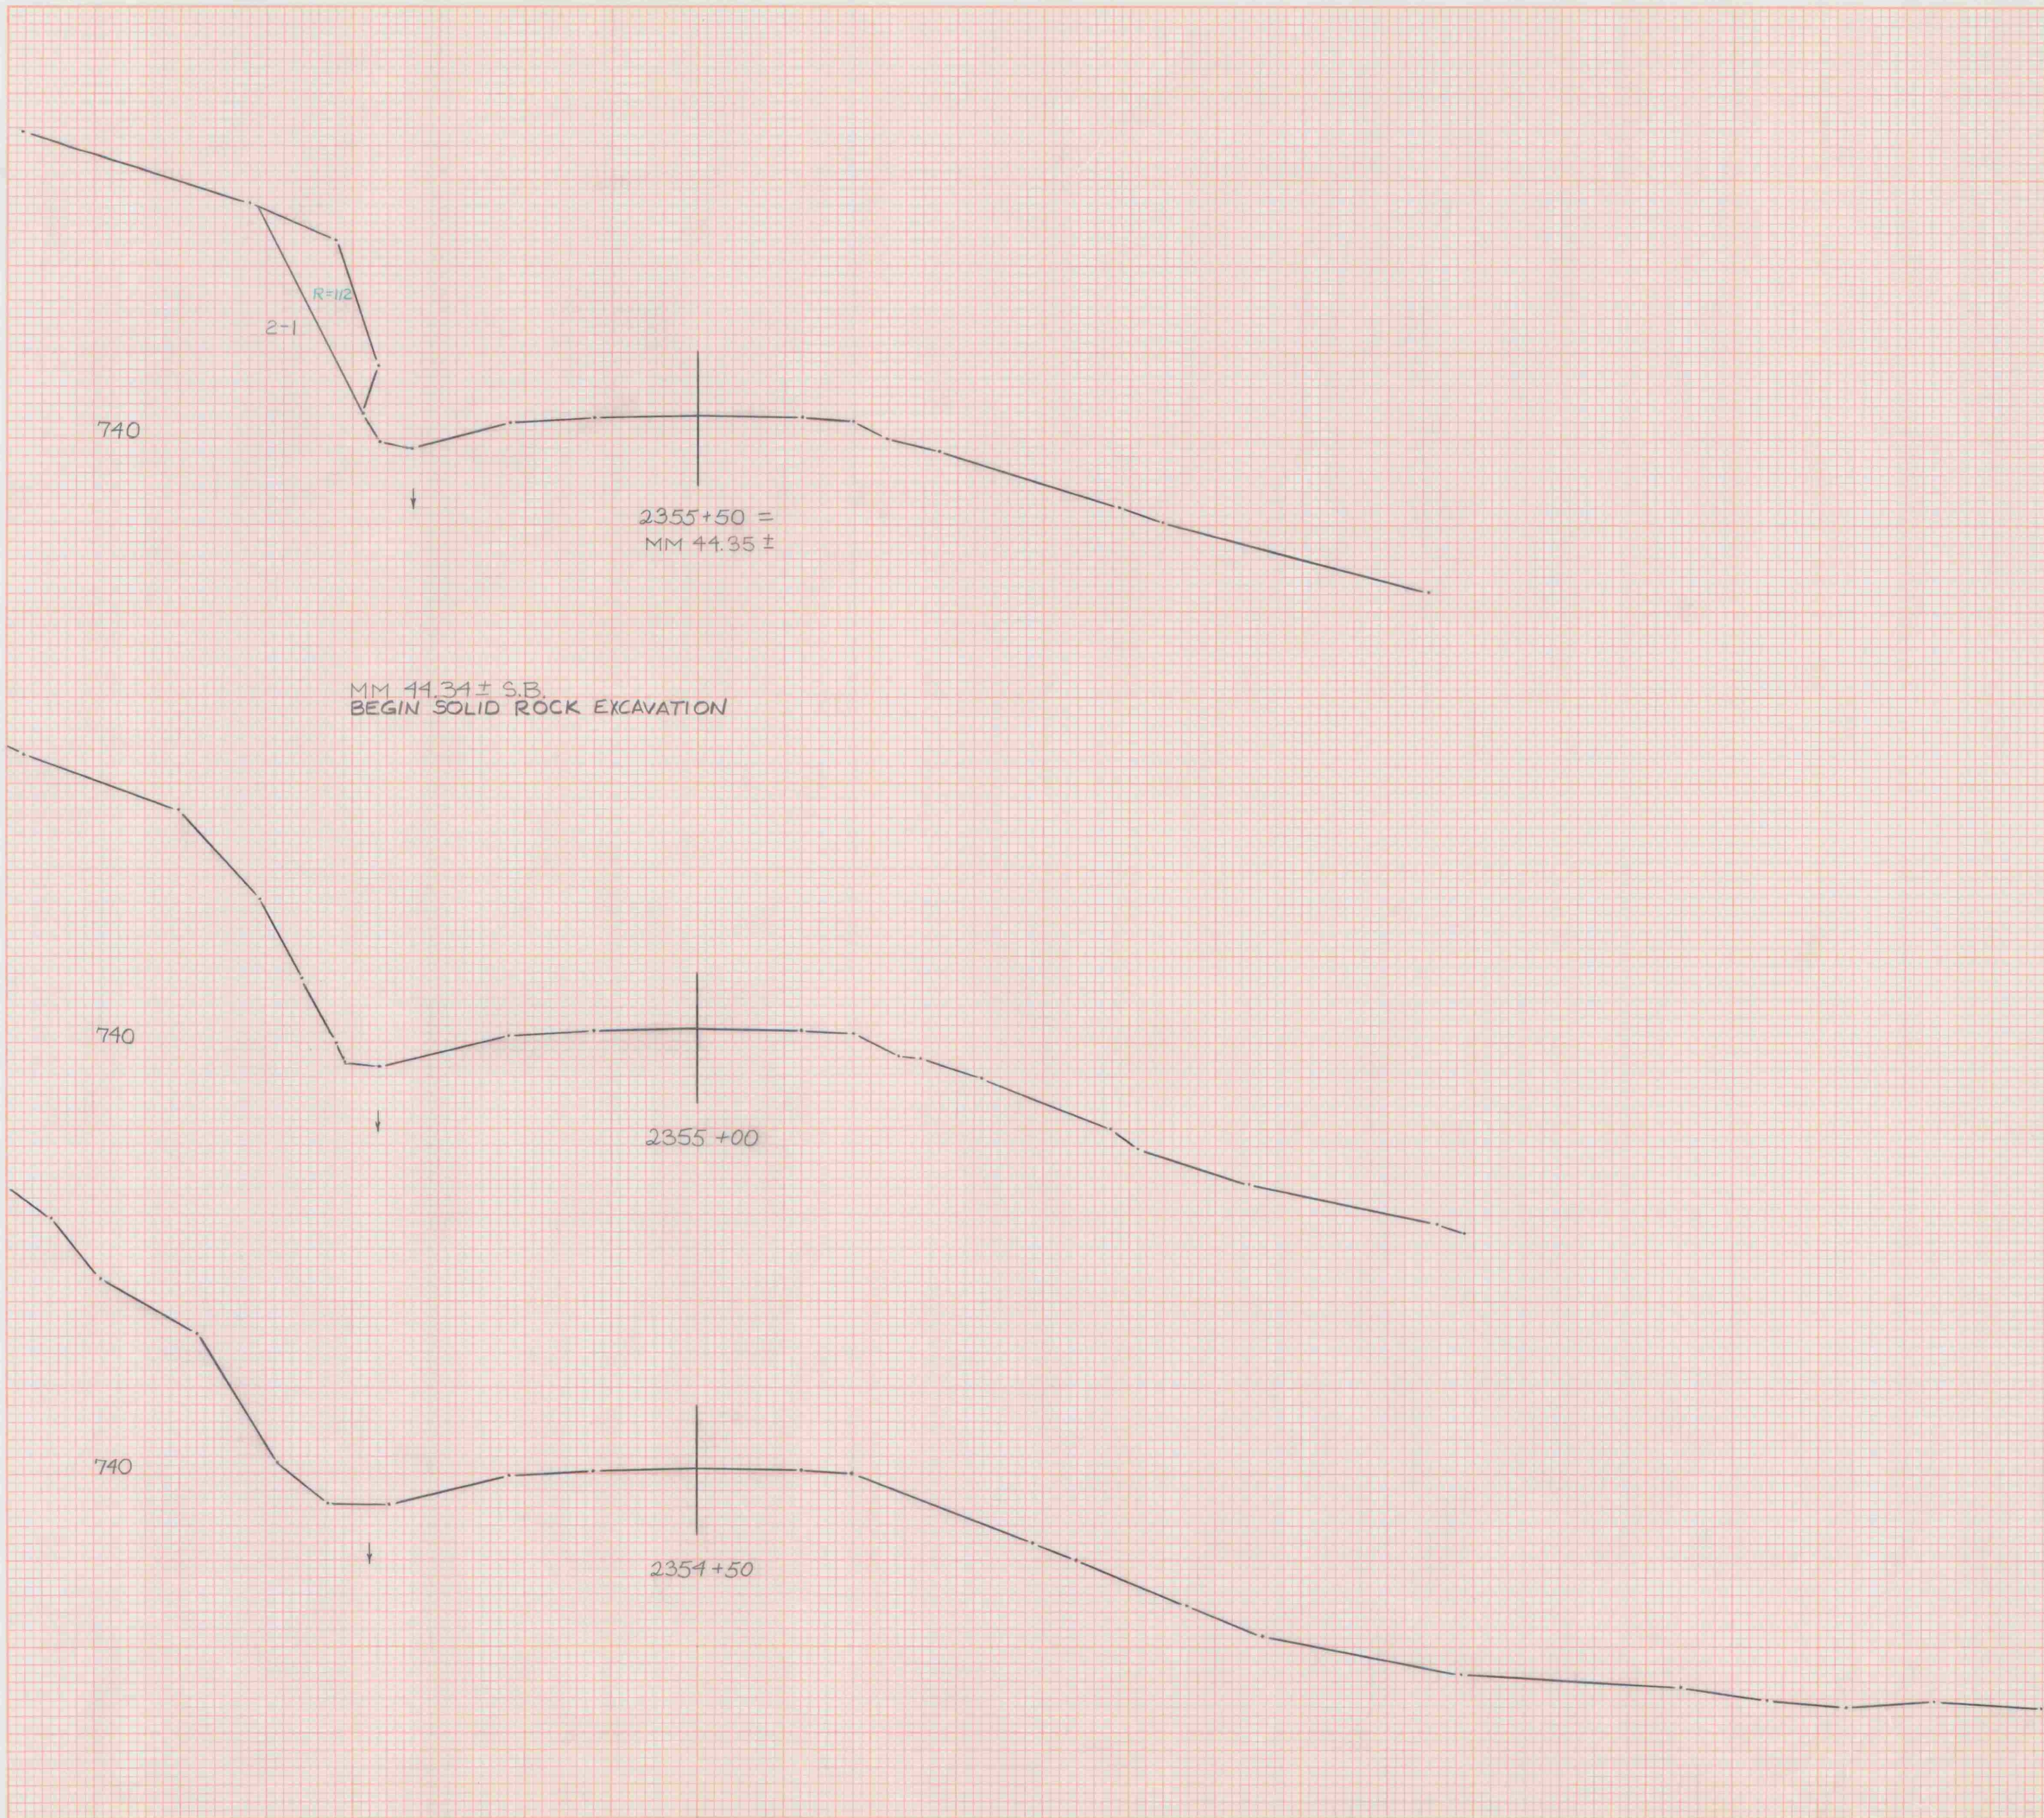

MM 44.34 ± S.B.
BEGIN SOLID ROCK EXCAVATION

SOUTHBOUND
MM 44.34 MM 44.45
STA 2354+50 STA 2355+50
TOWN SPRINGFIELD-HARTFORD
PROJECT IR 091-K20
HORIZ. & VERT. SCALES
1"=10'
DATE: JAN. '90
SHEET 89 OF 133 SHEETS