



DATE	
SCALE	
PROJECT	
DESIGNER	
CHECKER	
APPROVER	
DATE	

DATE	
SCALE	
PROJECT	
DESIGNER	
CHECKER	
APPROVER	
DATE	


740

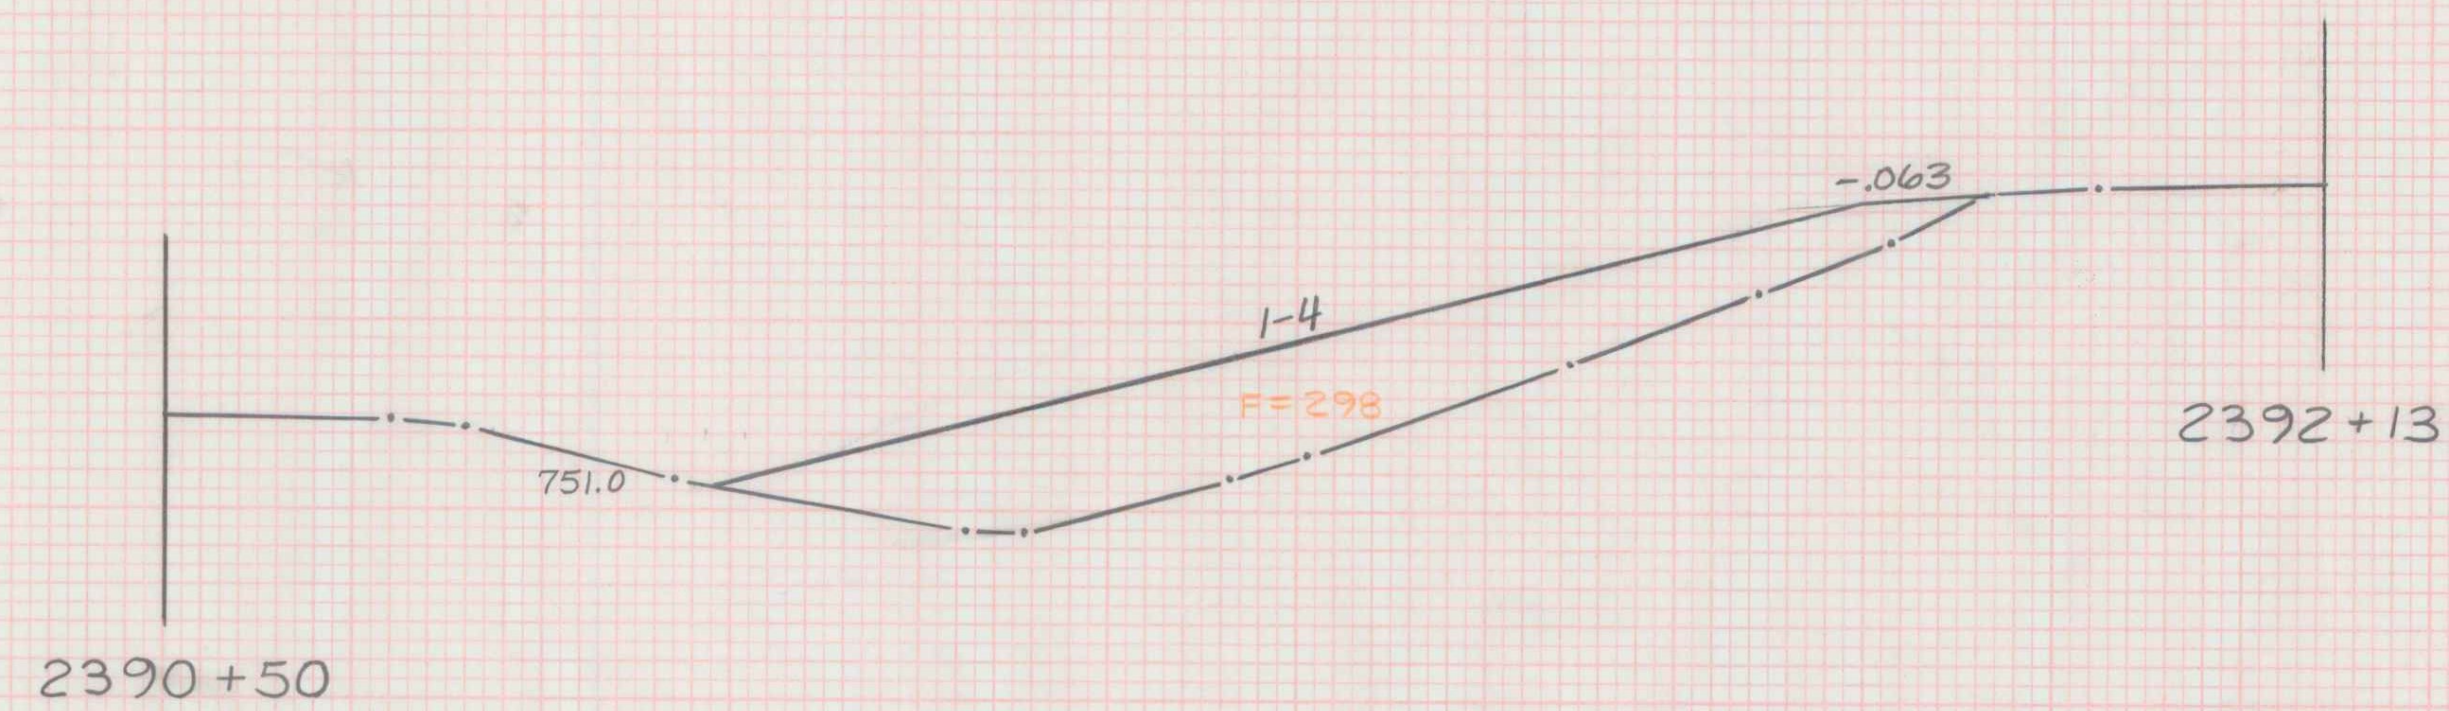


740

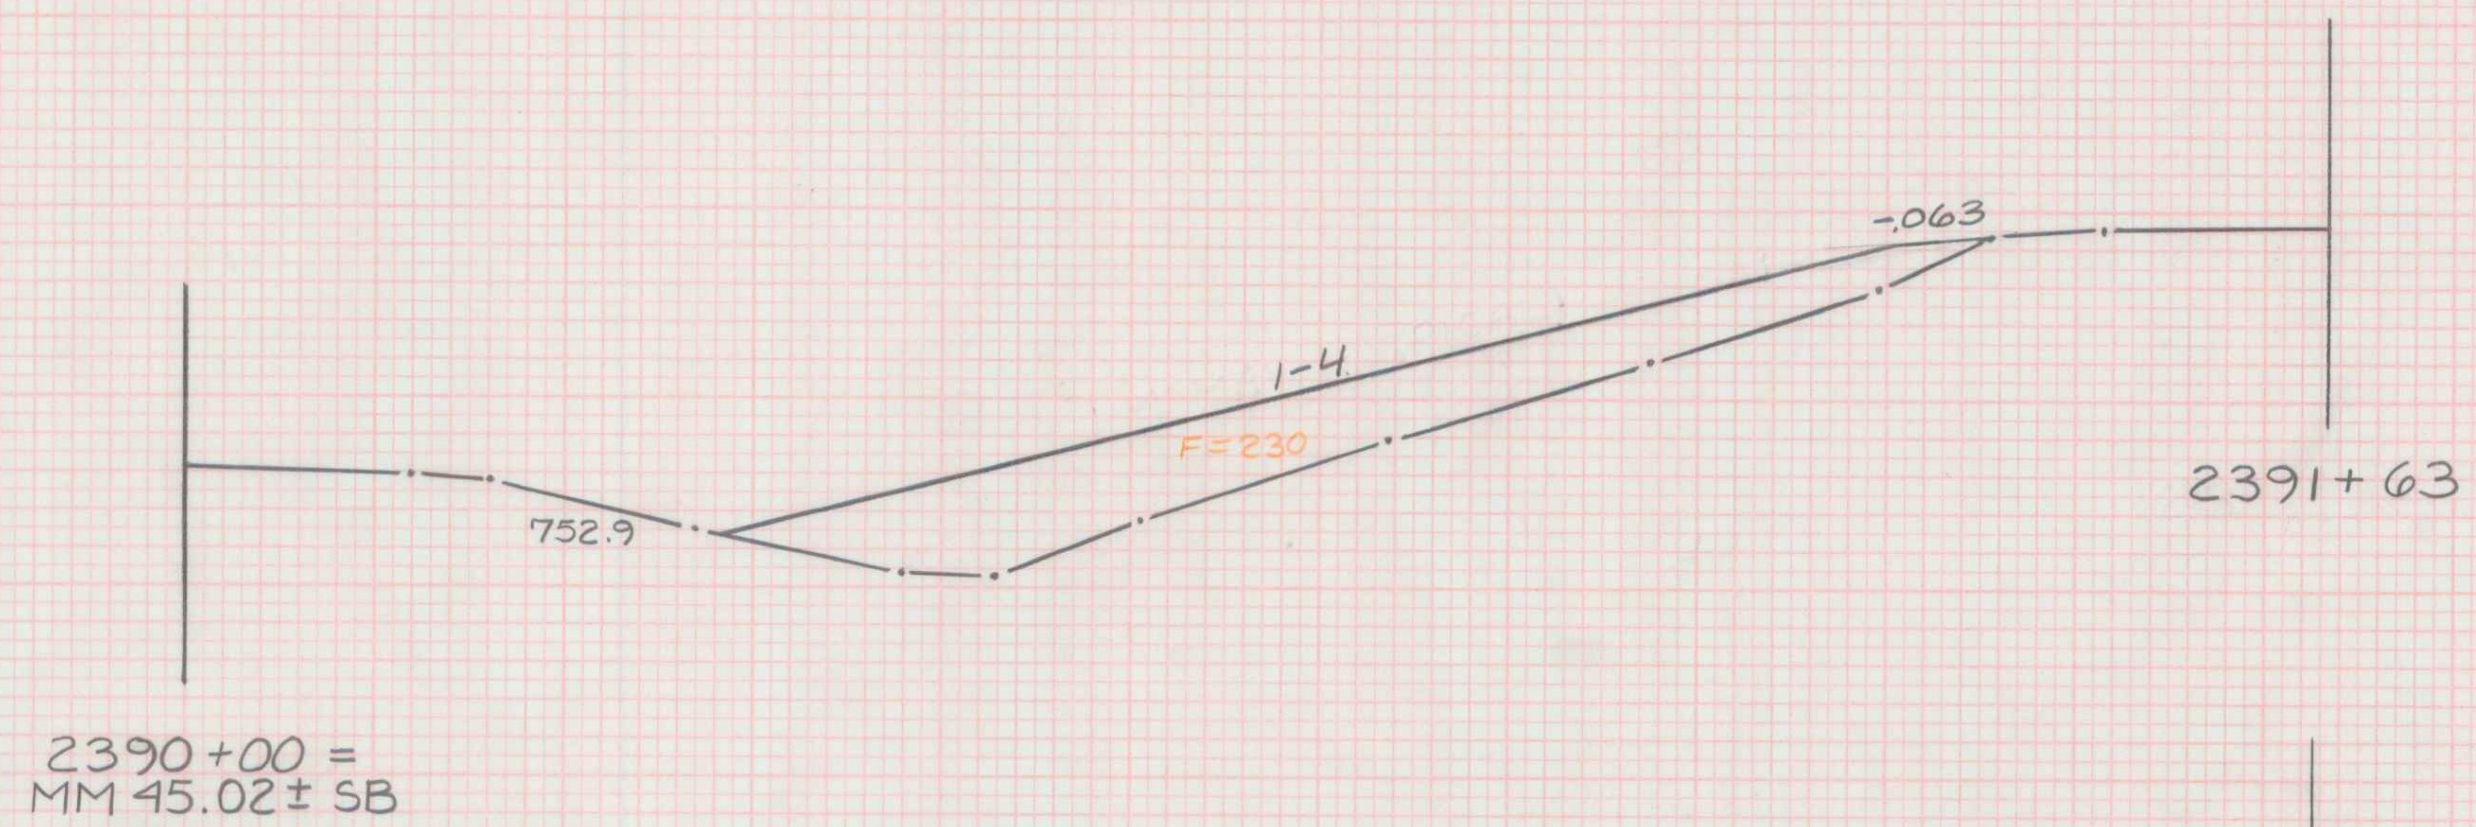

740

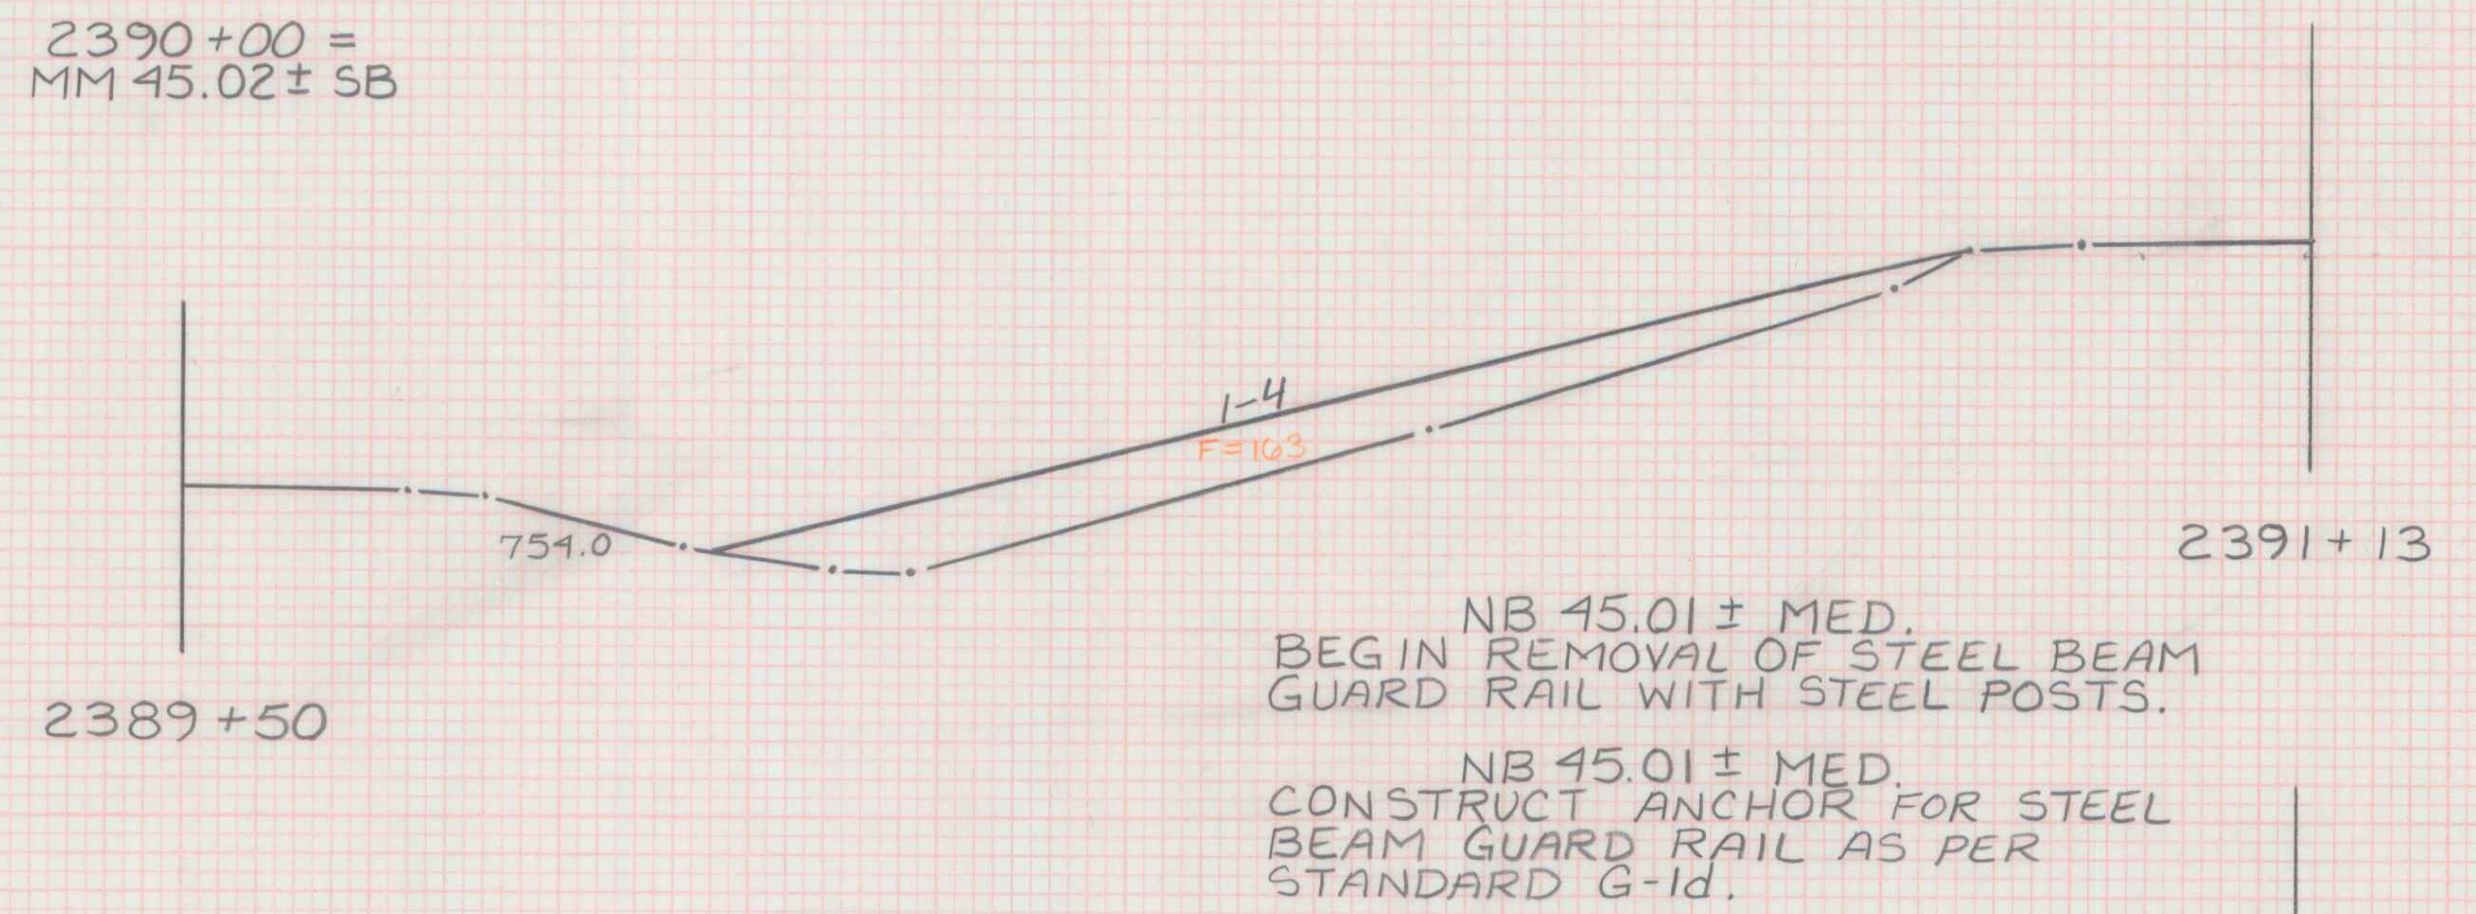

740

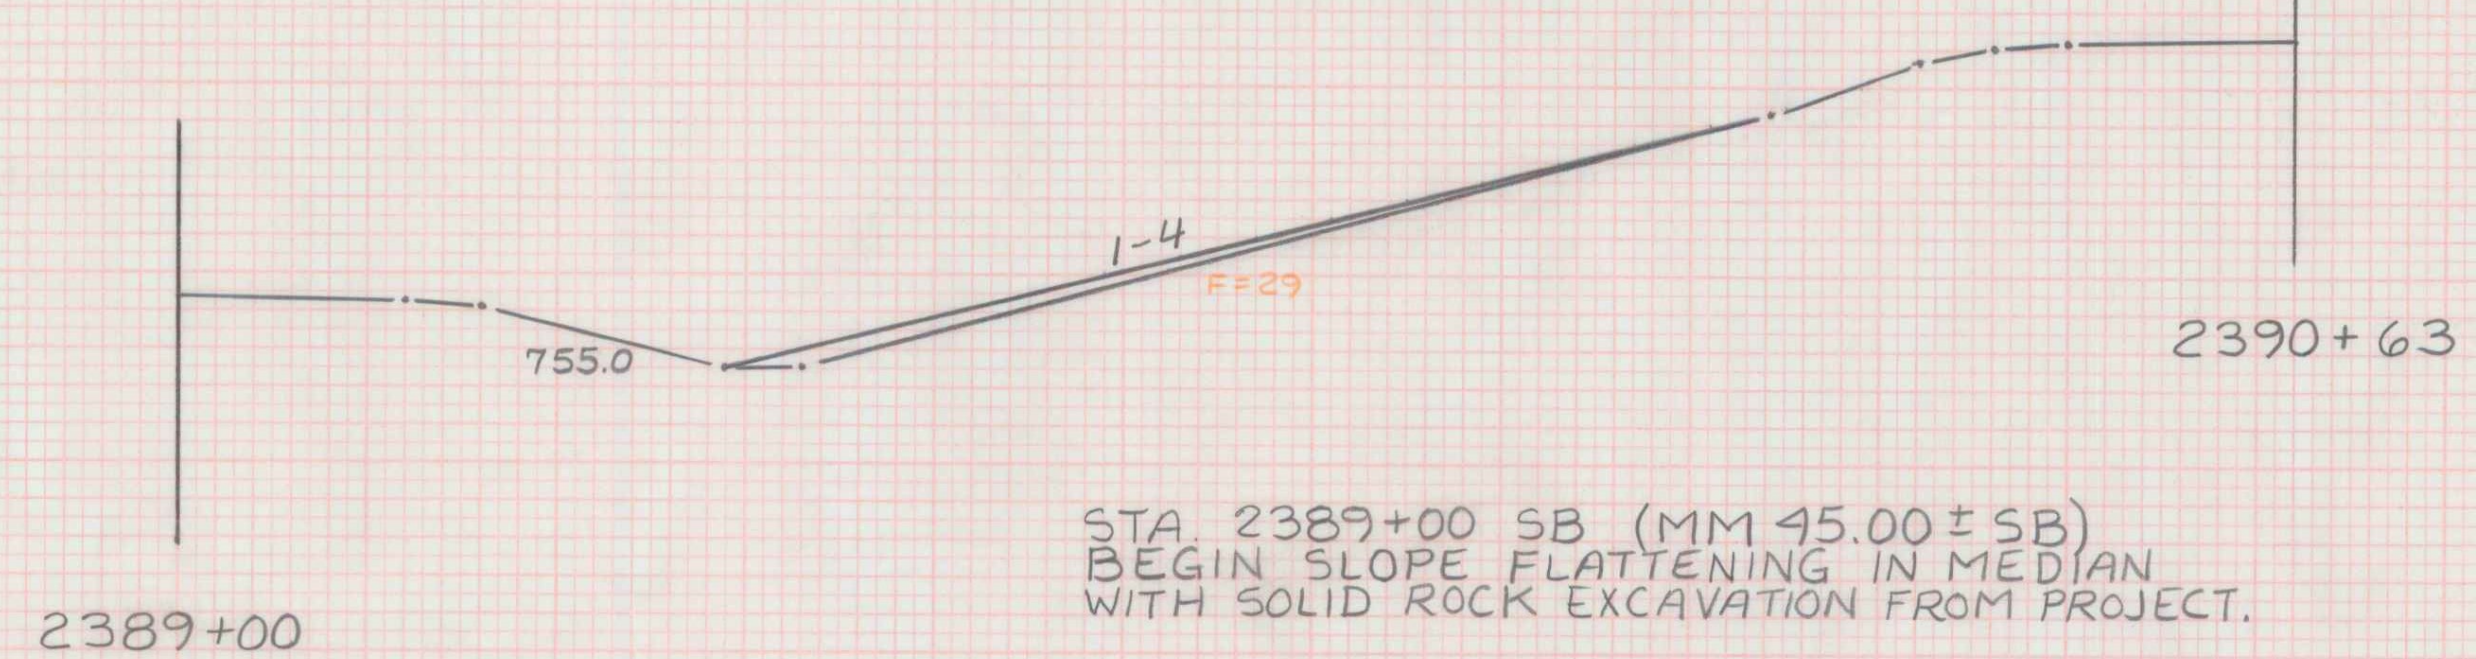

ROCK DISPOSAL AREA

MM 45.00 MM 45.38  
 STA 2389+0 STA 2390+50  
 TOWN SPRINGFIELD-HARTFORD  
 PROJECT IR 091-1(20)  
 HORIZ. & VERT. SCALES  
 1"=10'  
 DATE: OCT. 4, 1990  
 SHEET 94 OF 133 SHEETS