



DATE	
SCALE	
PROJECT	
NO.	
NAME	
DESIGNER	
CHECKER	
DATE	

DATE	
SCALE	
PROJECT	
NO.	
NAME	
DESIGNER	
CHECKER	
DATE	

730

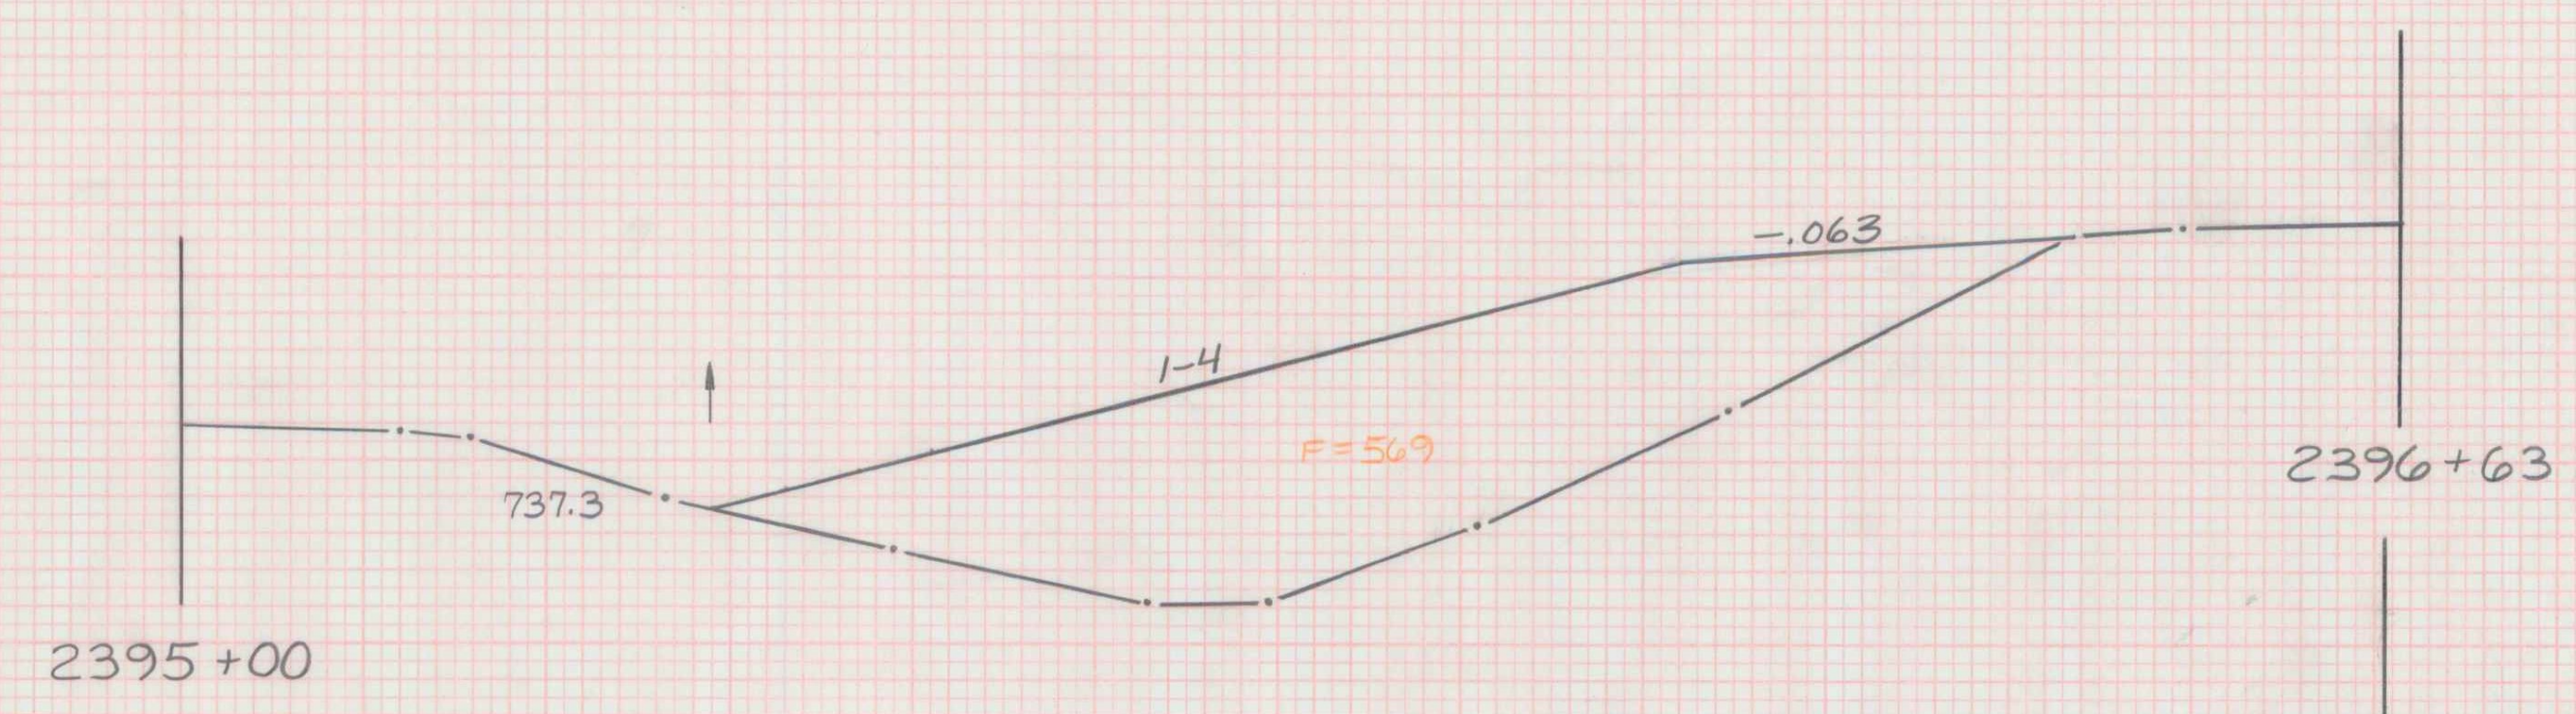


730

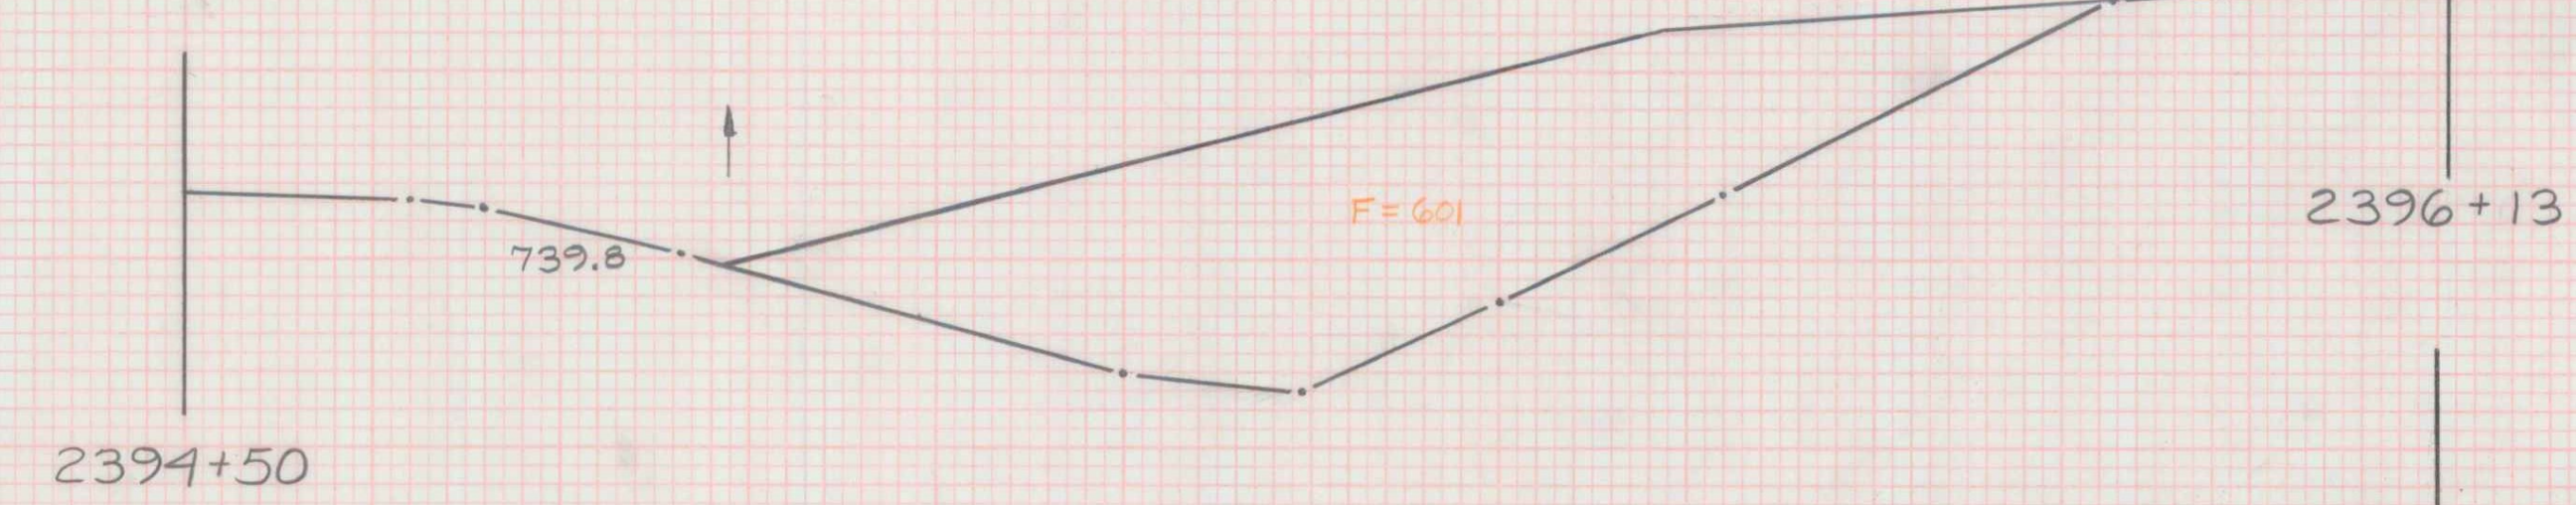


730

2394+00 =
MM 45.10 ± SB

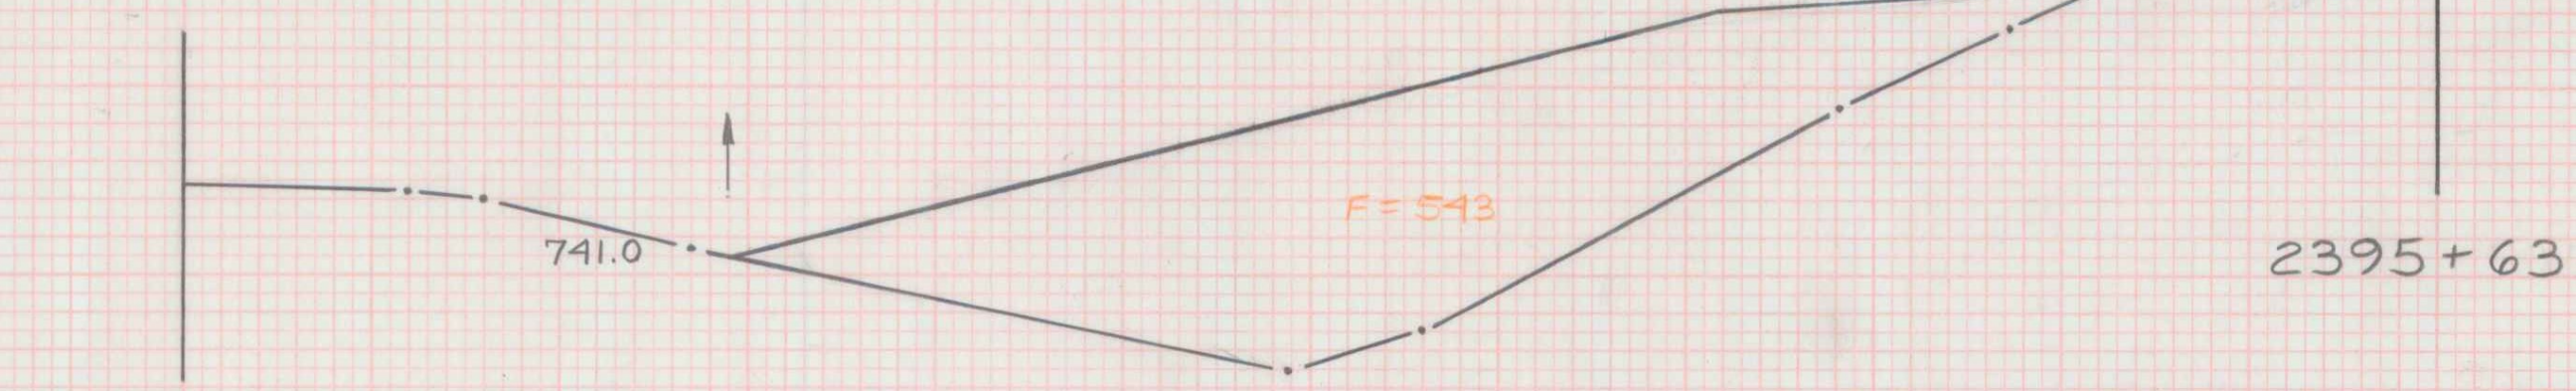

730

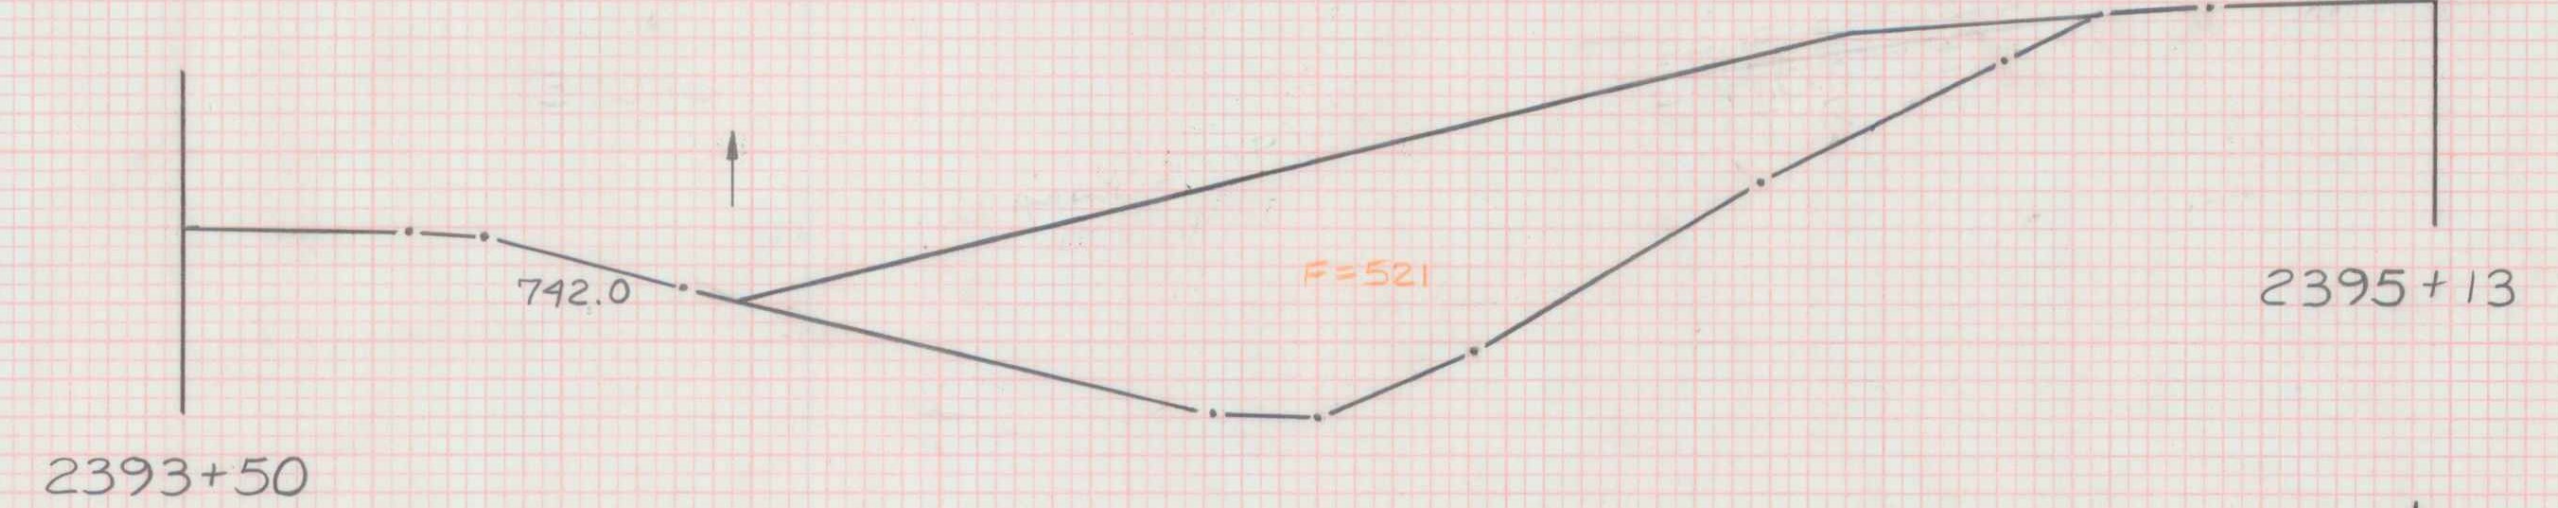

730

