

DATE	
BY	
CHECKED	
APPROVED	
SCALE	
PROJECT	
TOWN	
STATE	
COUNTY	
SECTION	

DATE	
BY	
CHECKED	
APPROVED	
SCALE	
PROJECT	
TOWN	
STATE	
COUNTY	
SECTION	

SB 2402+37.5
EXIST. 48" x 150' ACCGMP
W/ RIP RAP H.W. @ INLET
8 ga.

SB 2402+37.5 RT.
REMOVE BIT CONC. DITCH. PAYMENT
AS COMMON EXCAVATION, ITEM 203.15
PLACE NEW 48" x 40' PCCSP W/ COLLAR
AND CONSTRUCT NEW SADDLE BRANCH WITH NEW CAST IRON GRATE, TYPE C
REFER TO STANDARD SHEET D-17
SADDLE BRANCH PAYMENT TO BE
SUBSIDIARY TO THE PRICE OF
THE NEW 48" PCCSP.

NB 2404+00 LT.
EXIST. 48" x 118' ACCGMP
W/ RIP RAP C.H. @ OUTLET
8 ga.





730

730

730

730

720

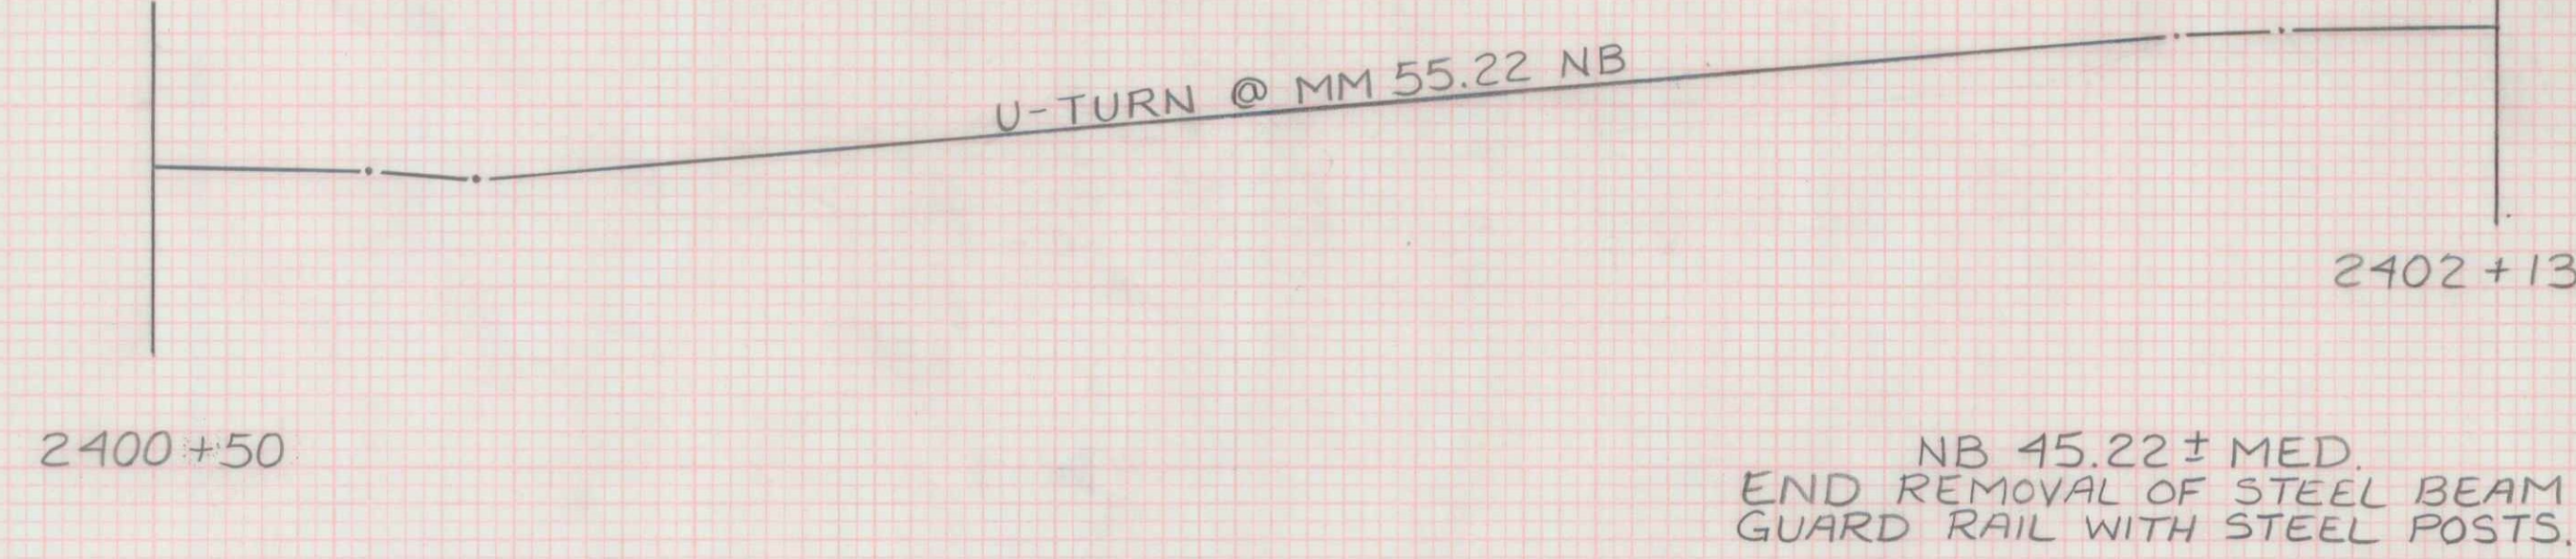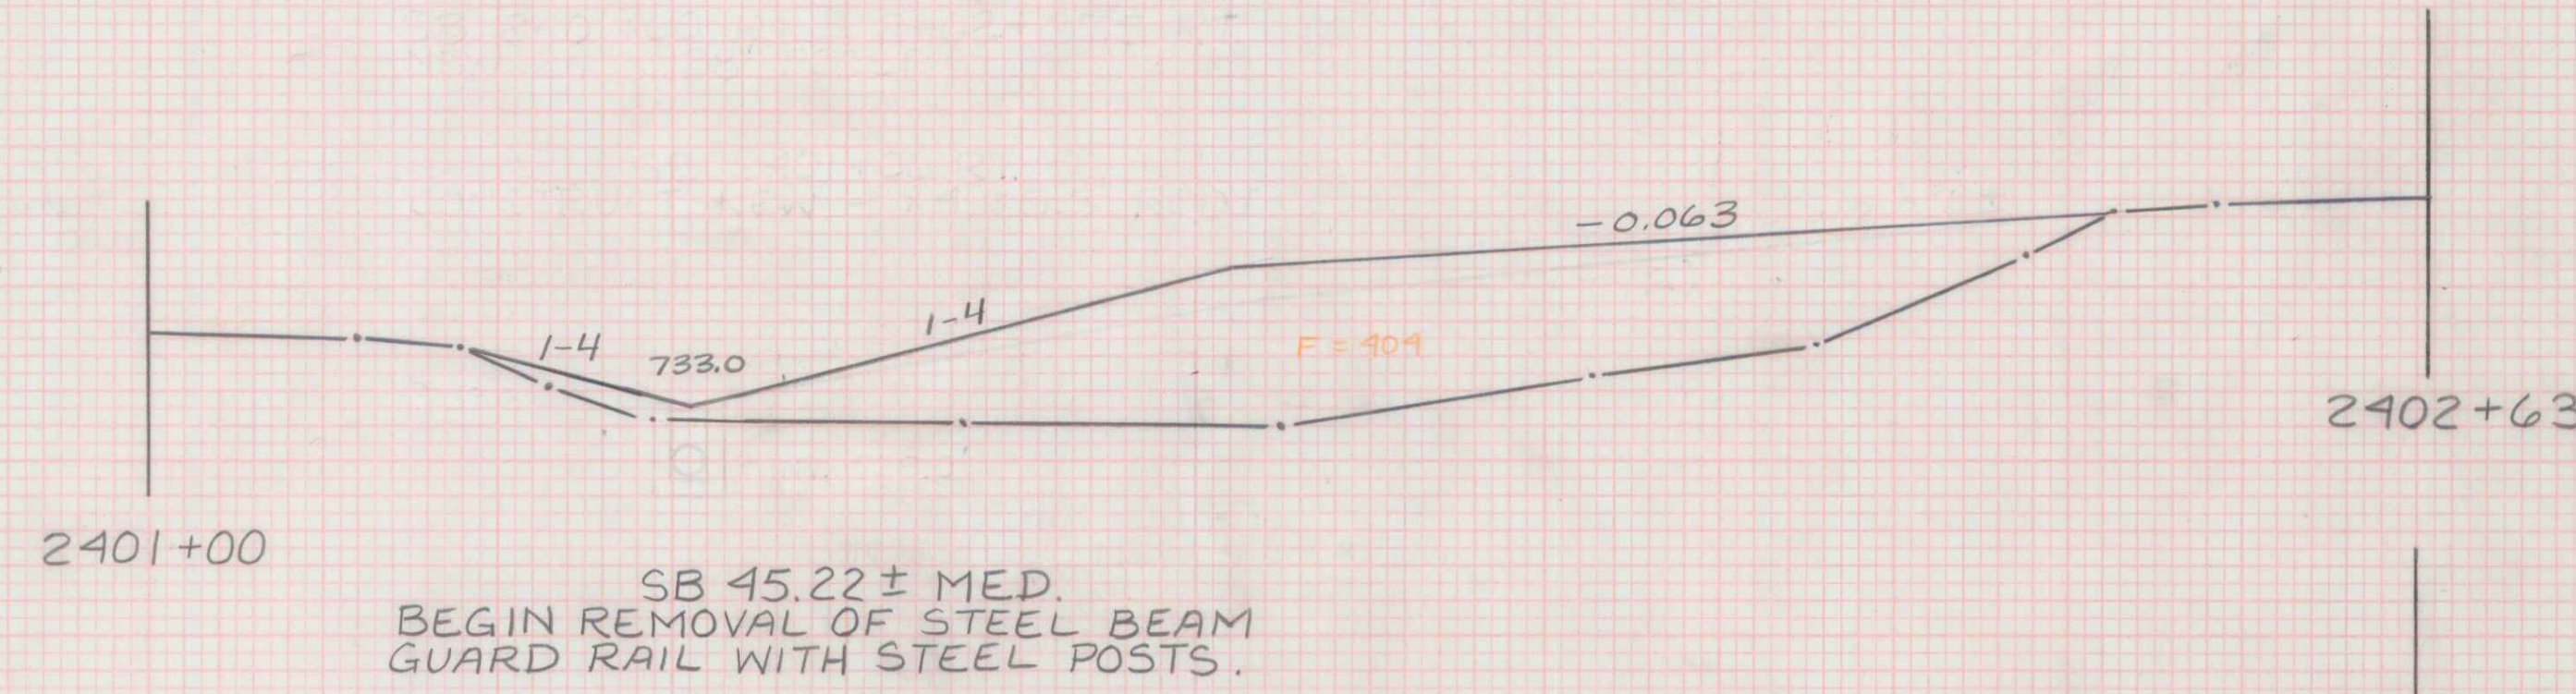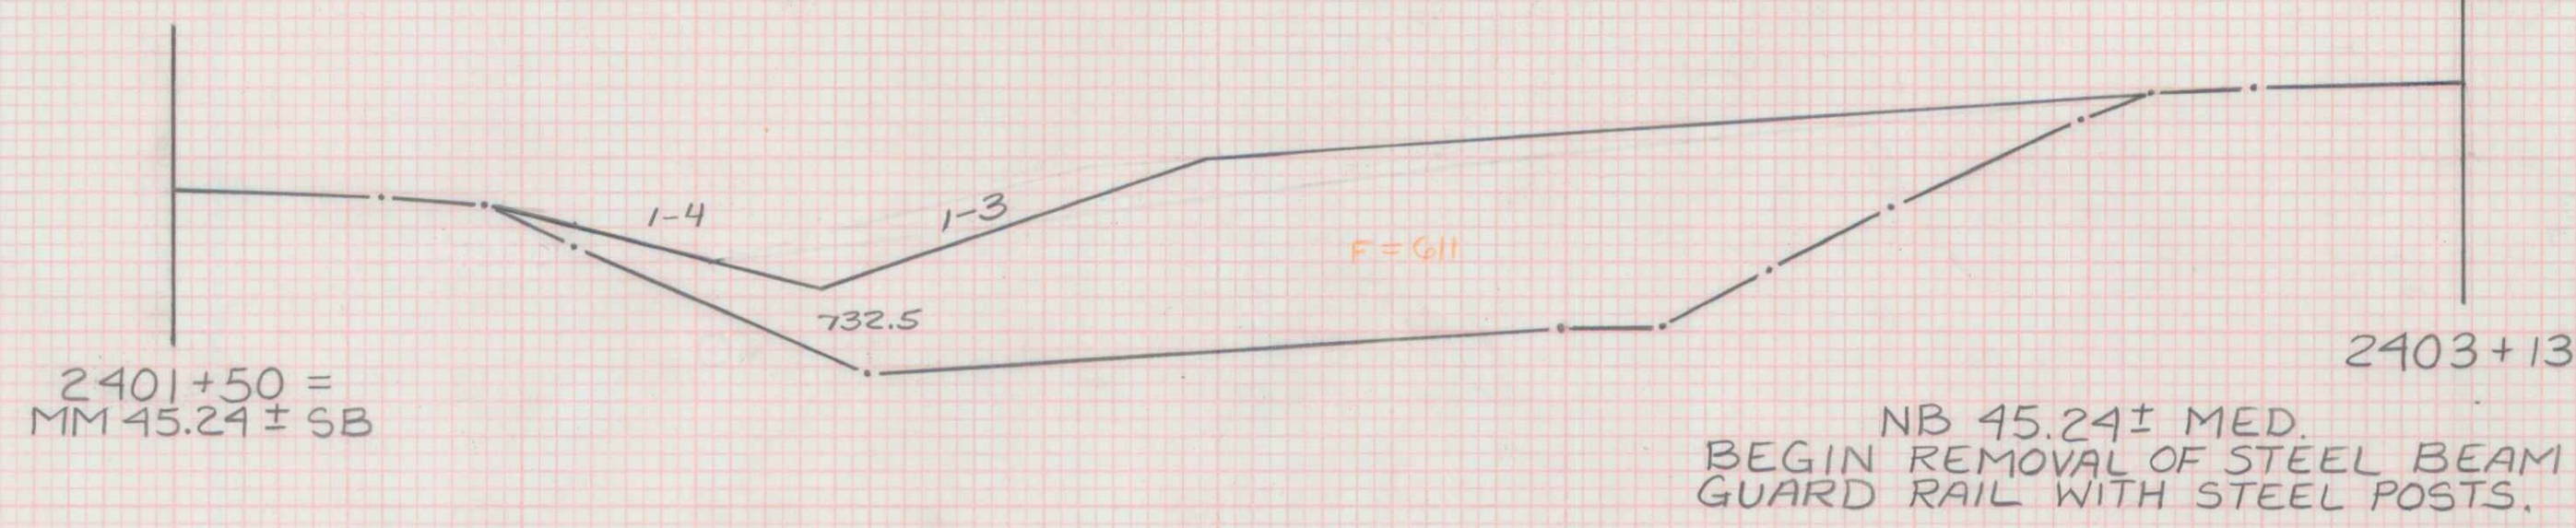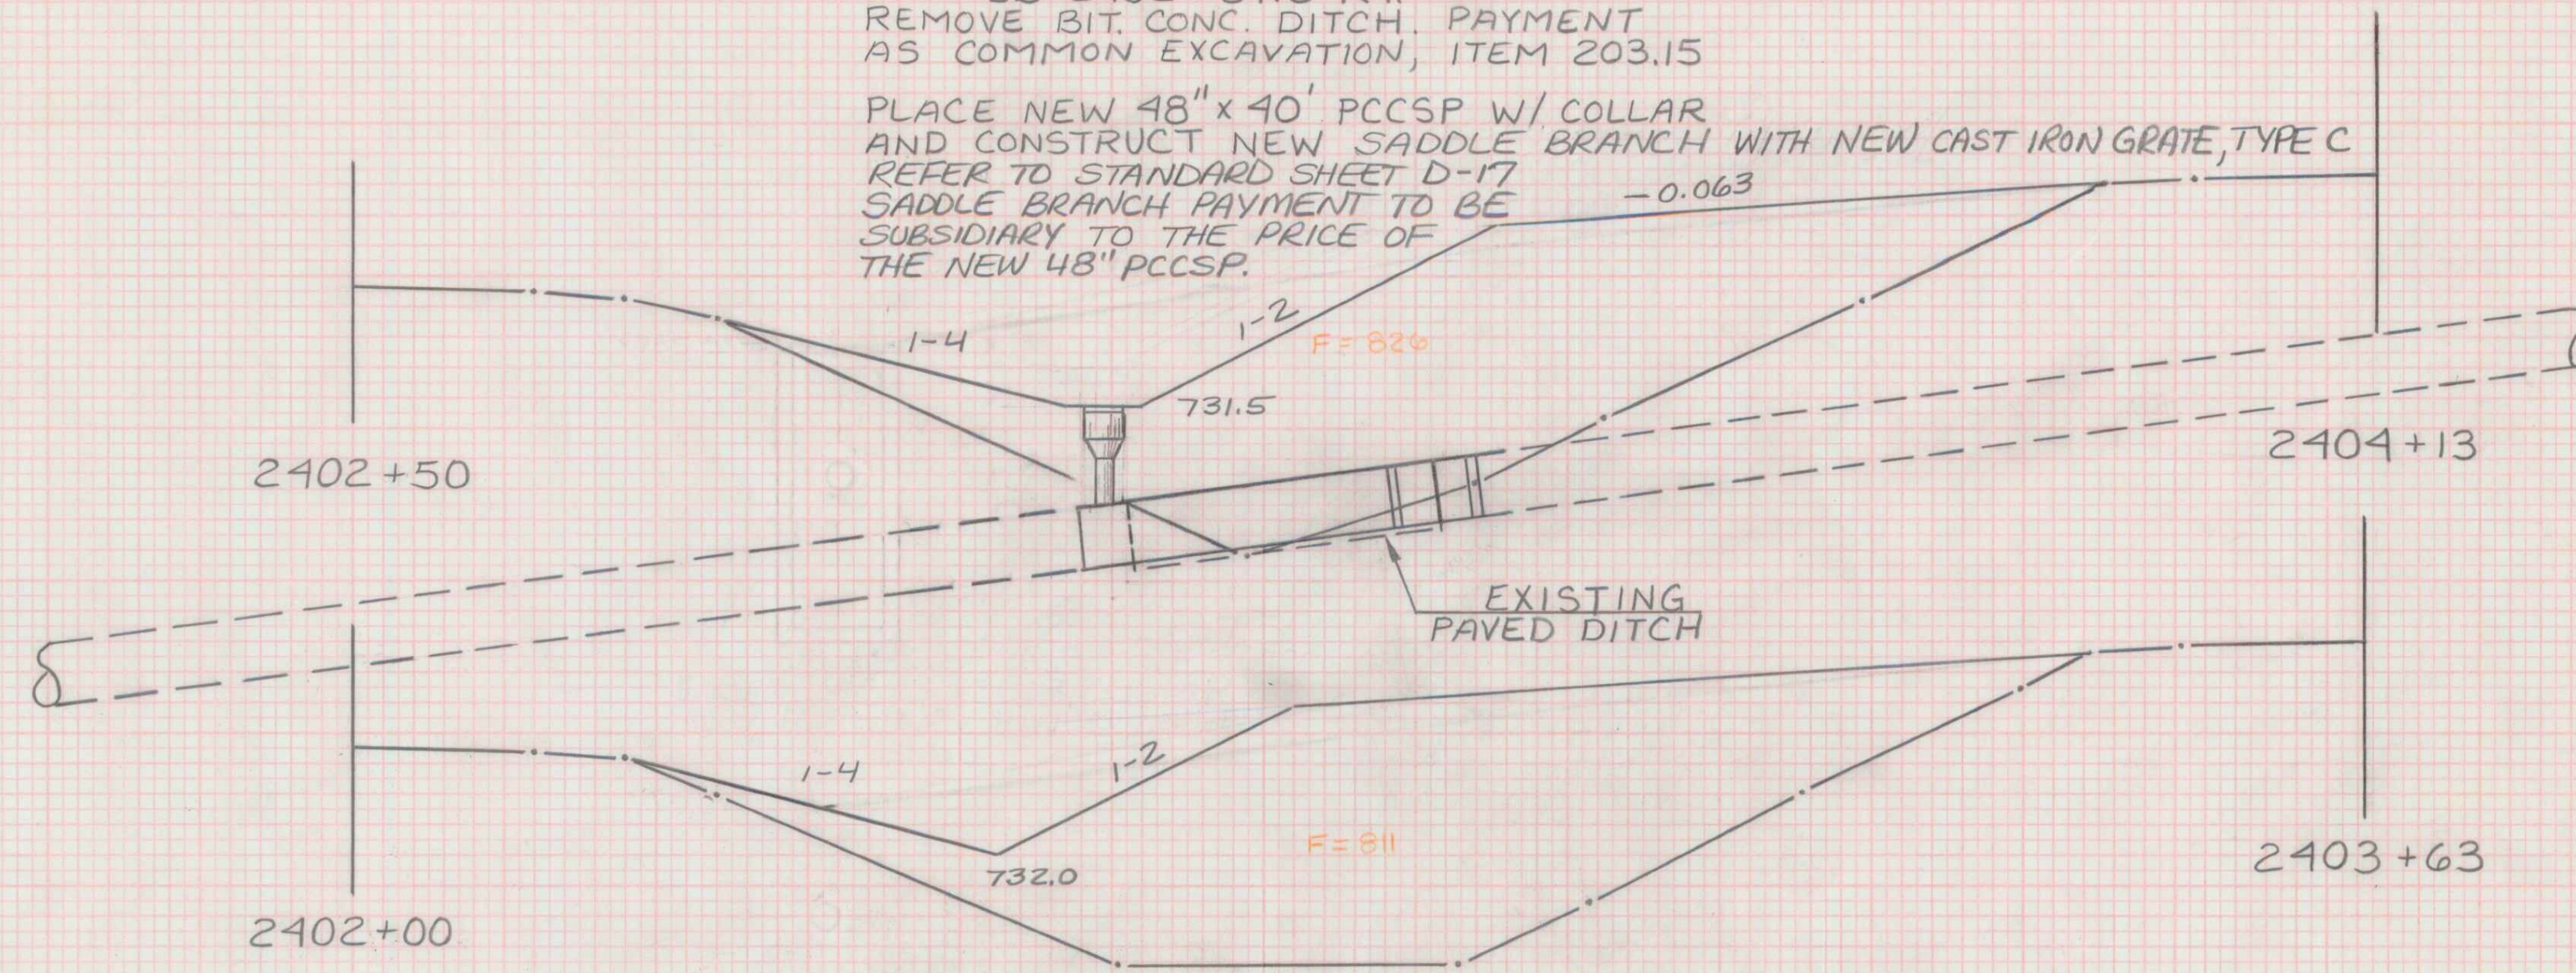

REVISED 06-02-1992
ROCK DISPOSAL AREA
MM 45.00 MM 45.38
STA 2400+50 STA 2402+50
TOWN SPRINGFIELD-HARTFORD
PROJECT IR 091-1(20)
HORIZ. & VERT. SCALES
1"=10'
DATE: OCT. 4, 1990
SHEET 99 OF 133 SHEETS