
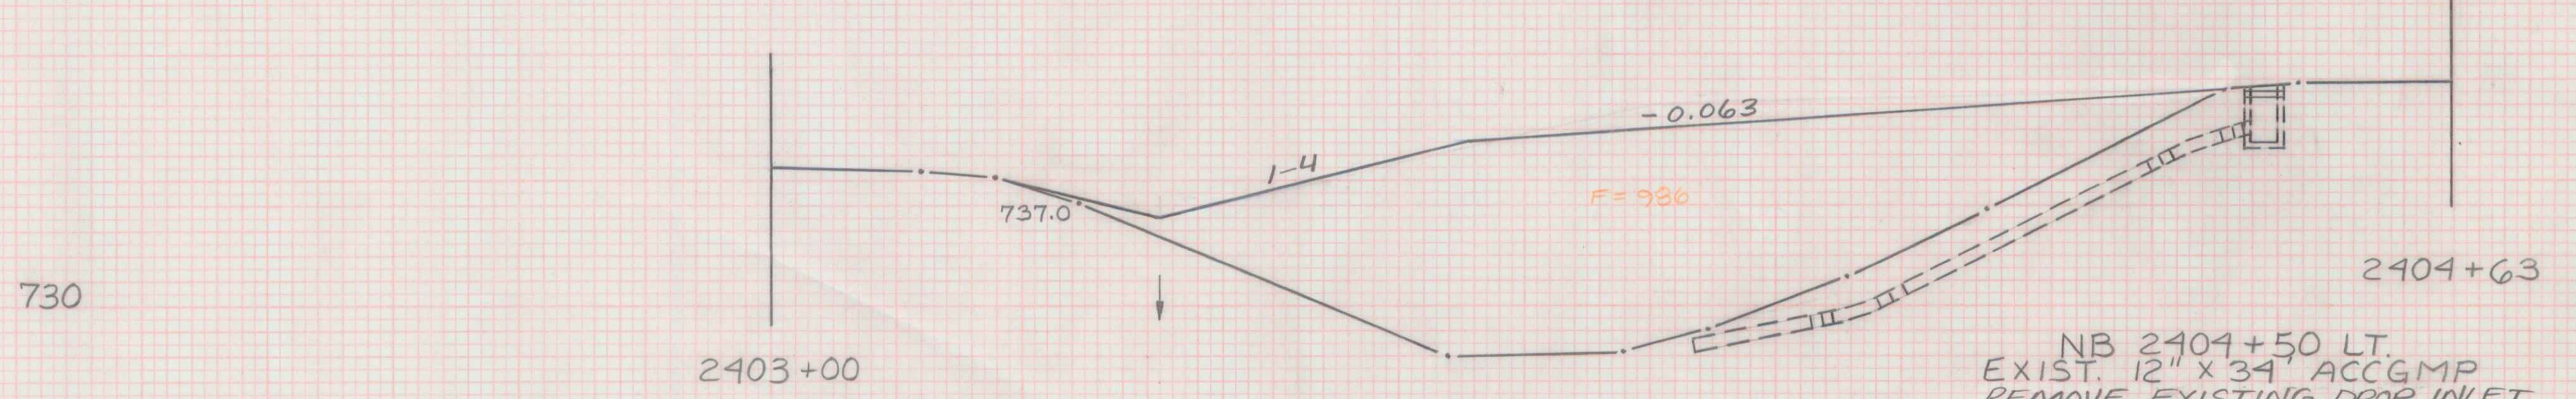
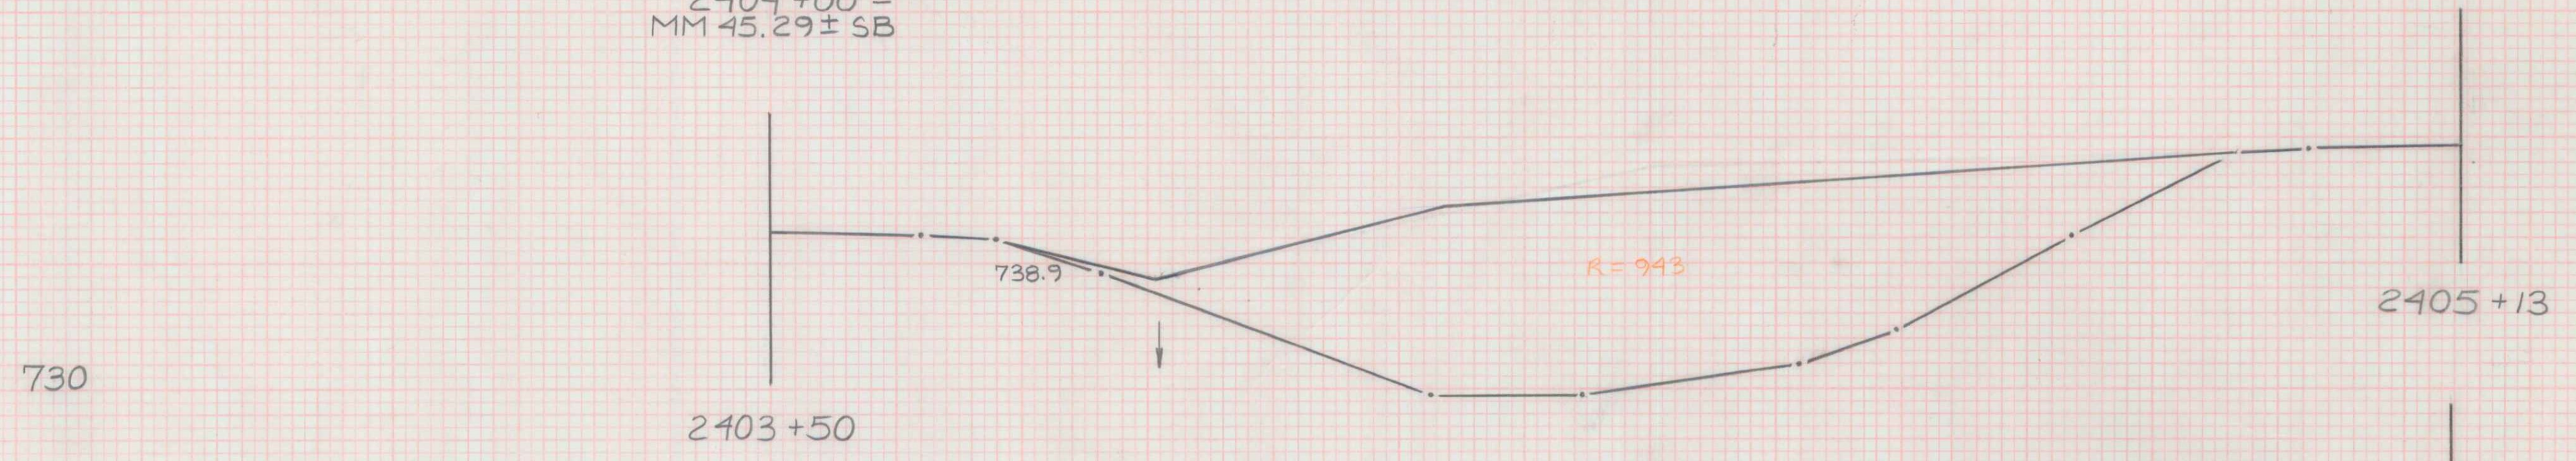
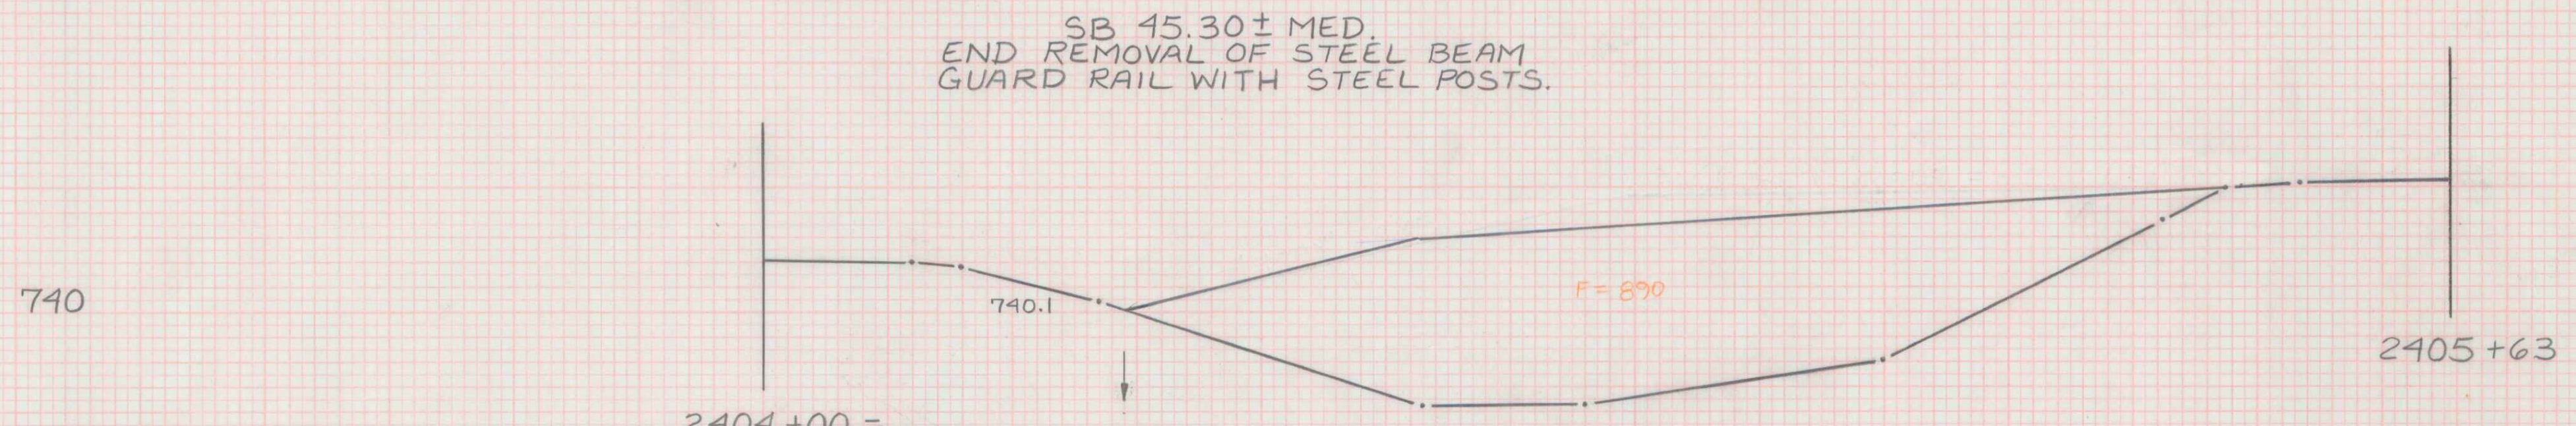
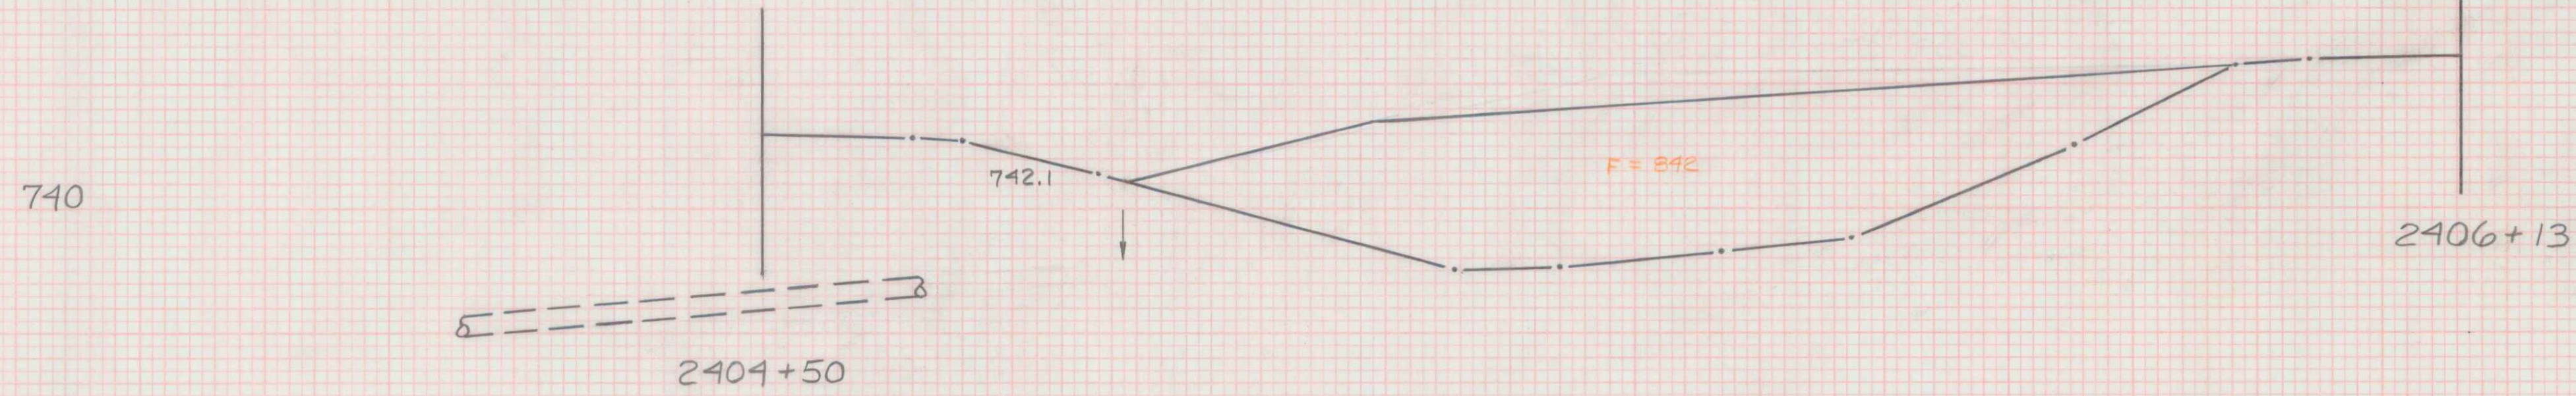


AMENDING	REVISION	DATE

DATE	BY	CHECKED	APPROVED

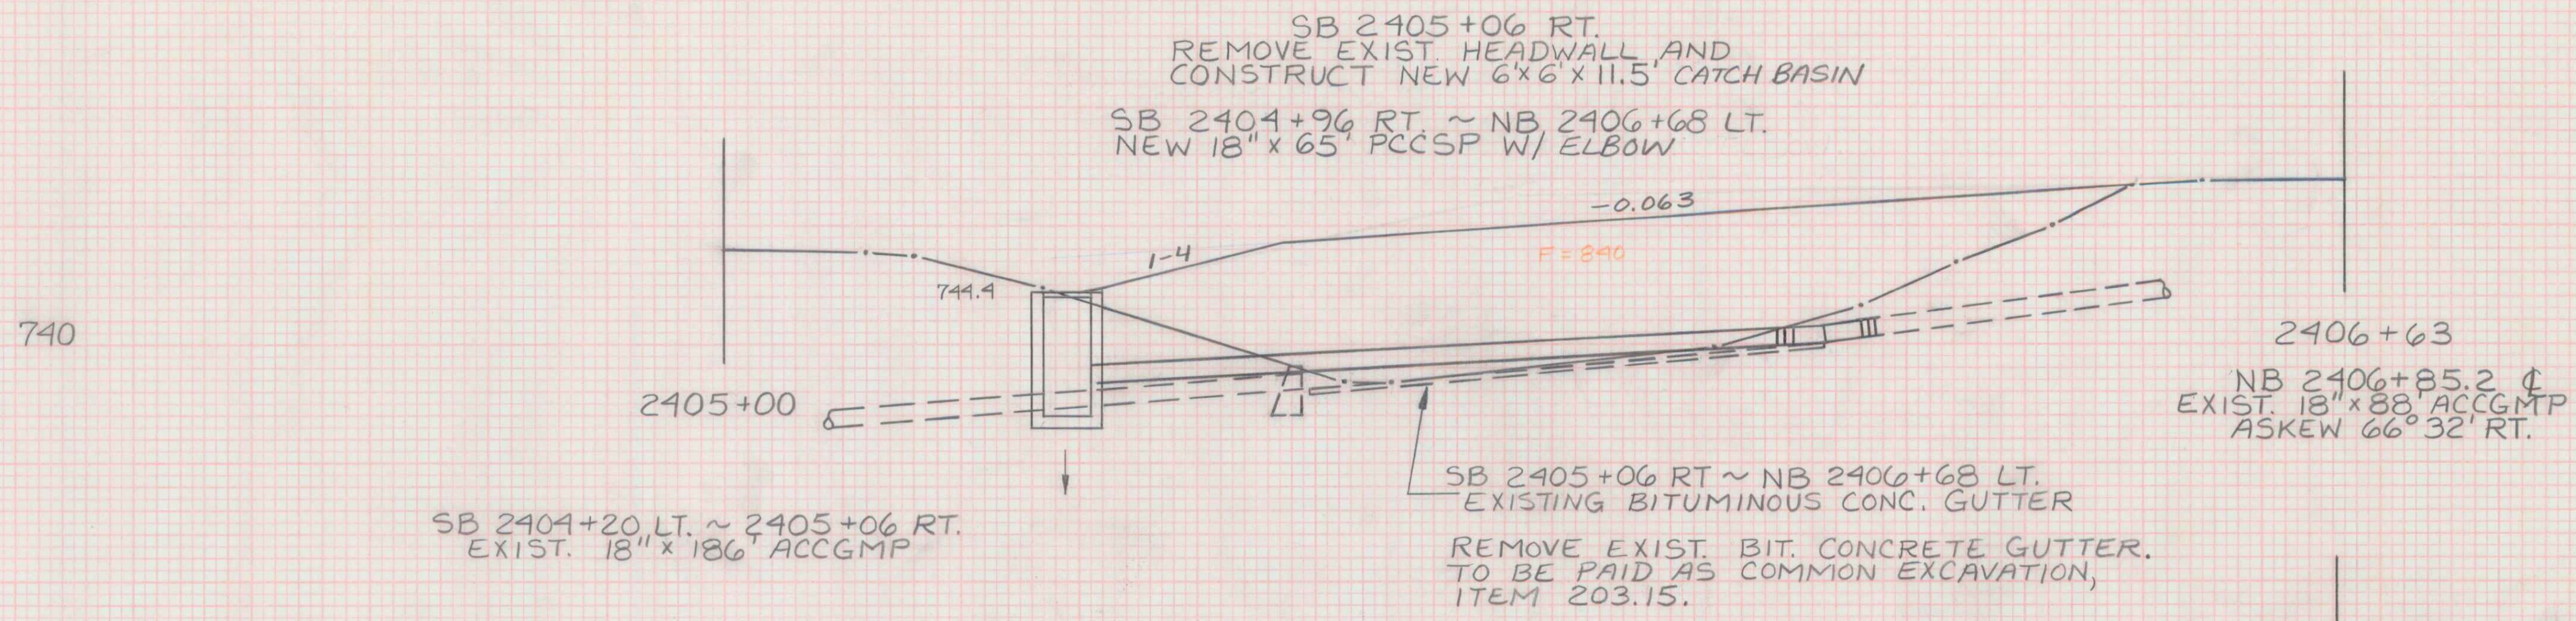

NB 2404+50 LT.
 BEGIN REMOVAL OF EXISTING BITUMINOUS CONCRETE CURB. (ITEM 616.41)

ROCK DISPOSAL AREA
 MM 45.00 MM 45.38
 STA 2403+0 STA 2405+0
 TOWN SPRINGFIELD-HARTFORD
 PROJECT IR 091-K(20)
 HORIZ. & VERT. SCALES
 1"=10'
 DATE: OCT. 4, 1990
 SHEET 100 OF 133 SHEETS