
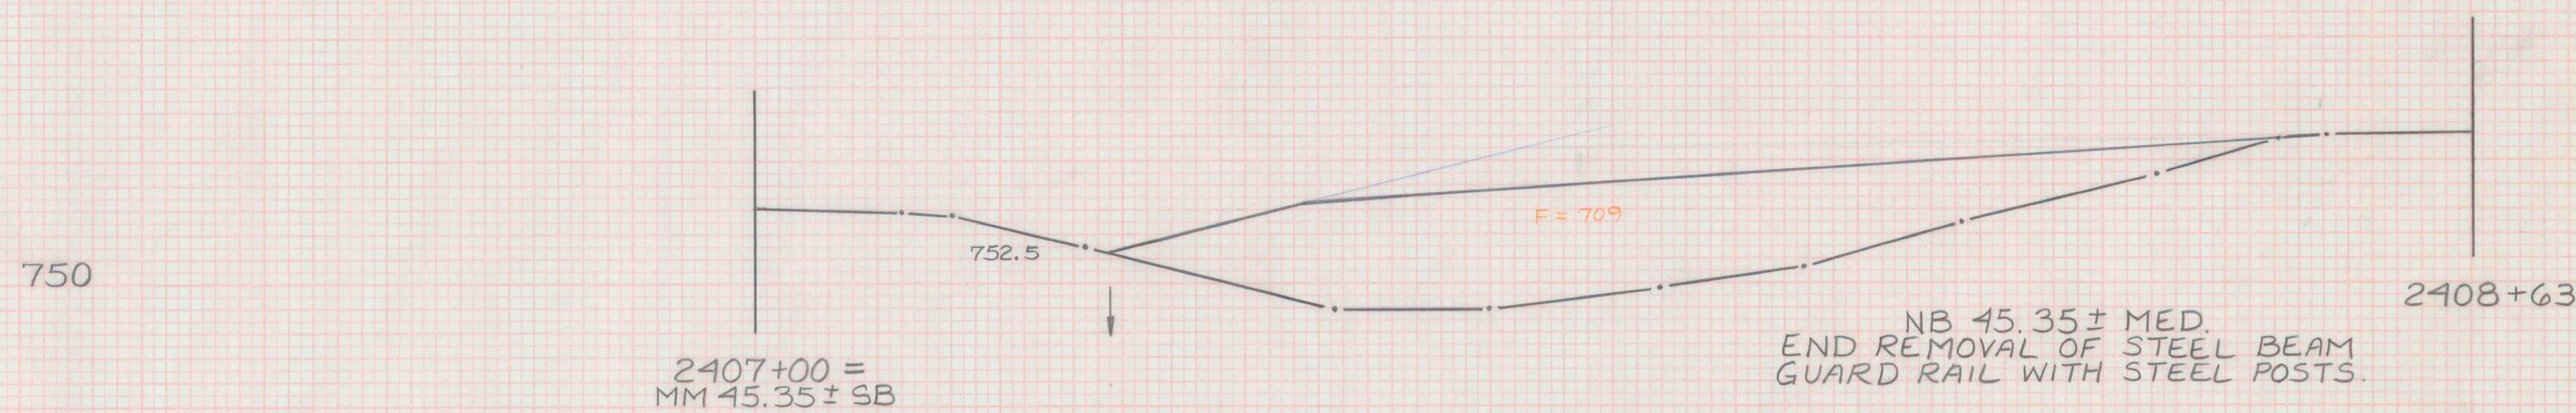





DATE	
BY	
CHECKED	
APPROVED	
DESIGNED	
PLANNED	
CONSTRUCTION	
REVISIONS	

DATE	
BY	
CHECKED	
APPROVED	
DESIGNED	
PLANNED	
CONSTRUCTION	
REVISIONS	

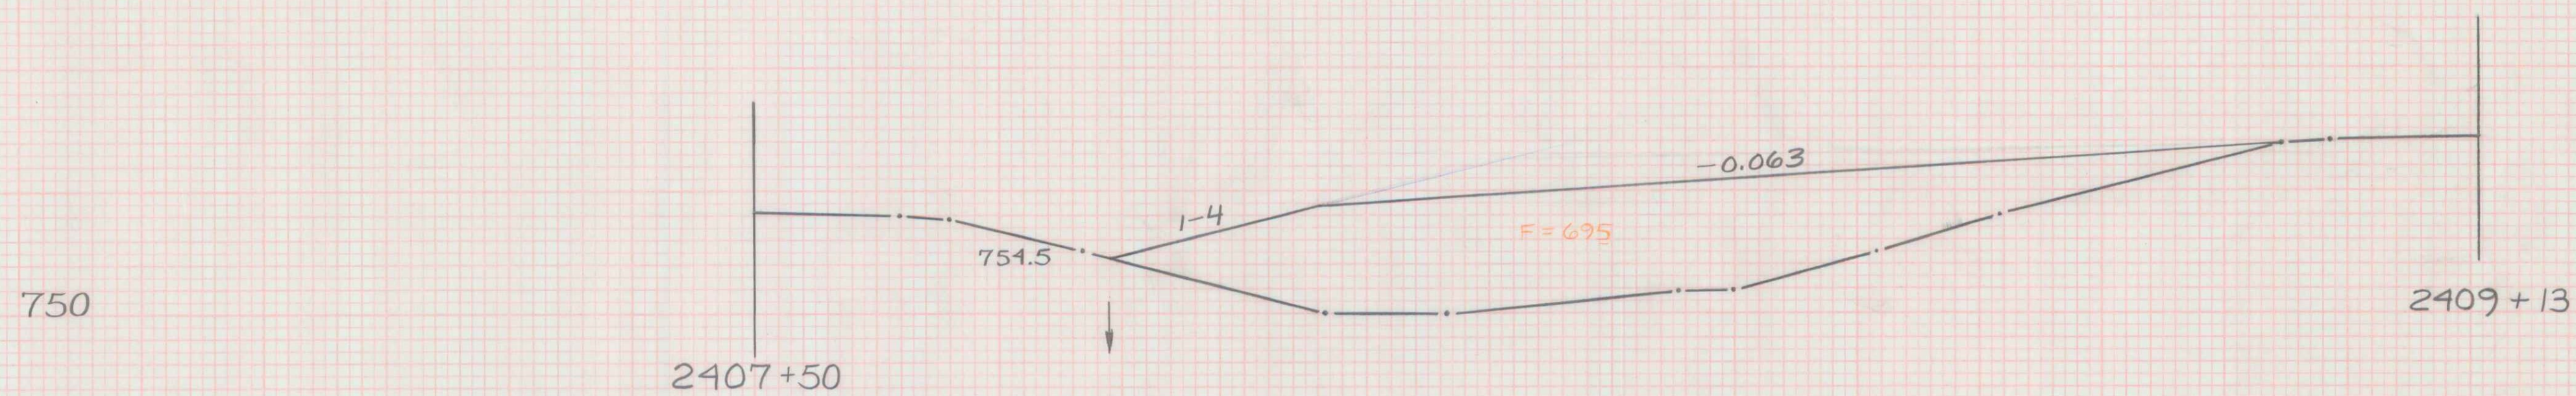

NB 45.35 ± MED.  
END REMOVAL OF STEEL BEAM  
GUARD RAIL WITH STEEL POSTS.

NB 2408+20 LT.  
END REMOVAL OF BITUMINOUS  
CONCRETE CURB.

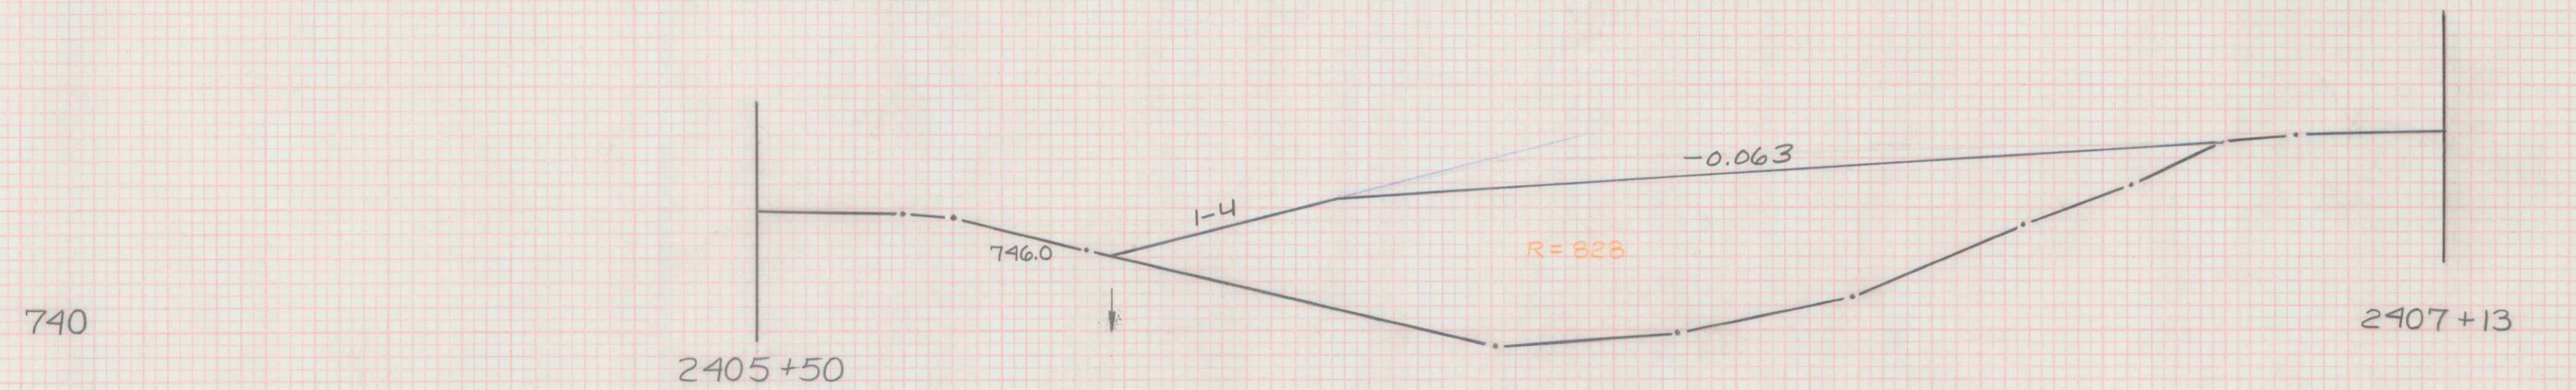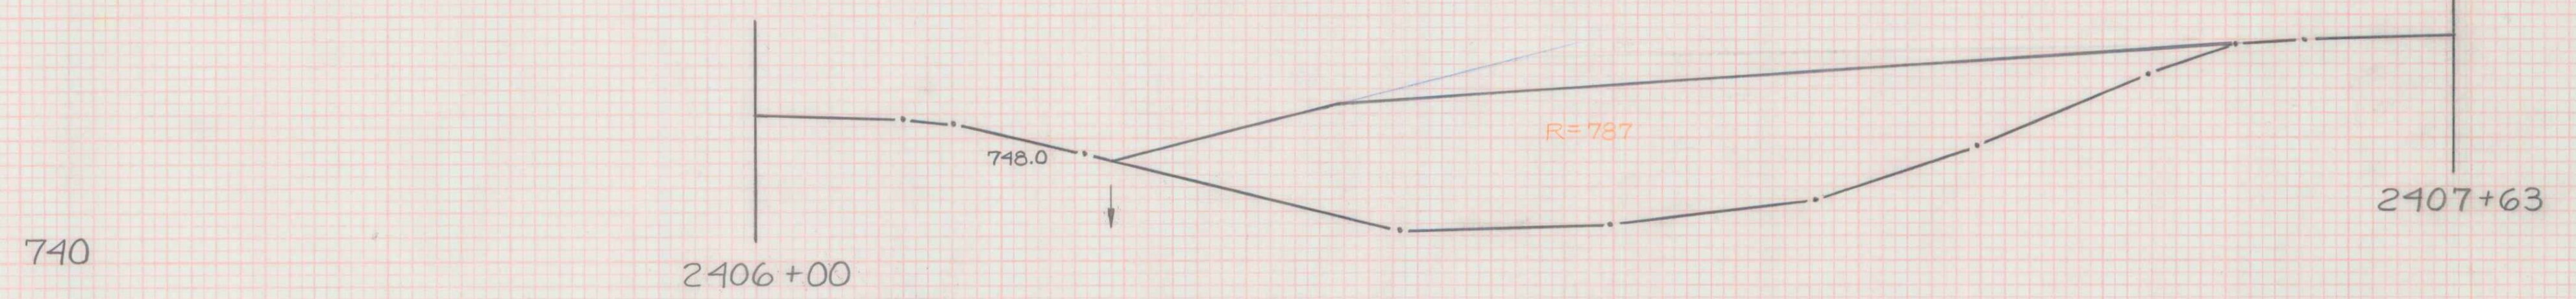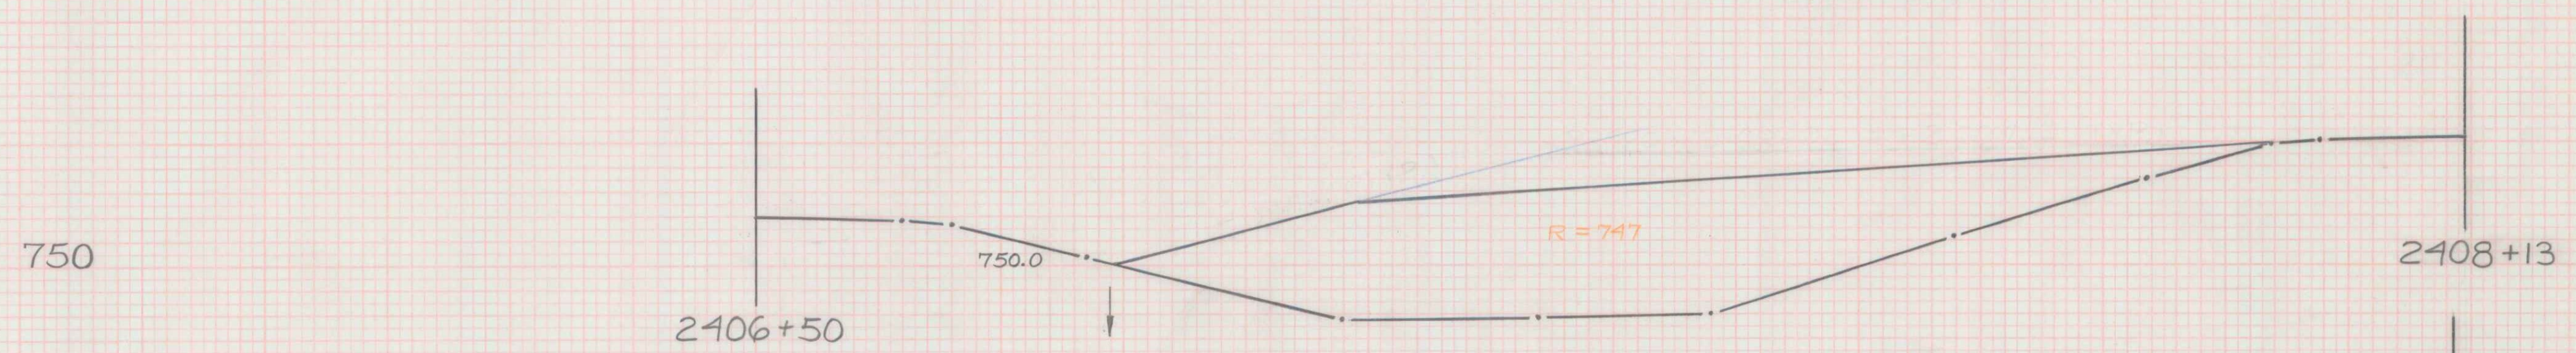

ROCK DISPOSAL AREA  
 MM 45.00 MM 45.38  
 STA 2405+50 STA 2407+50  
 TOWN SPRINGFIELD-HARTFORD  
 PROJECT IR 091-1(20)  
 HORIZ. & VERT. SCALES  
 1"=10'  
 DATE: OCT. 4, 1990  
 SHEET 101 OF 133 SHEETS