


TYPICAL PAVEMENT THICKNESSES

- 2 - 1 1/2" BITUMINOUS CONCRETE PAVEMENT, TYPE III
- 3" BITUMINOUS CONCRETE PAVEMENT, TYPE II
- 2 - 3" BITUMINOUS CONCRETE PAVEMENT, TYPE I

SHOULDERS:

- 2 - 1 1/2" BITUMINOUS CONCRETE PAVEMENT, TYPE III
- 3" BITUMINOUS CONCRETE PAVEMENT, TYPE II

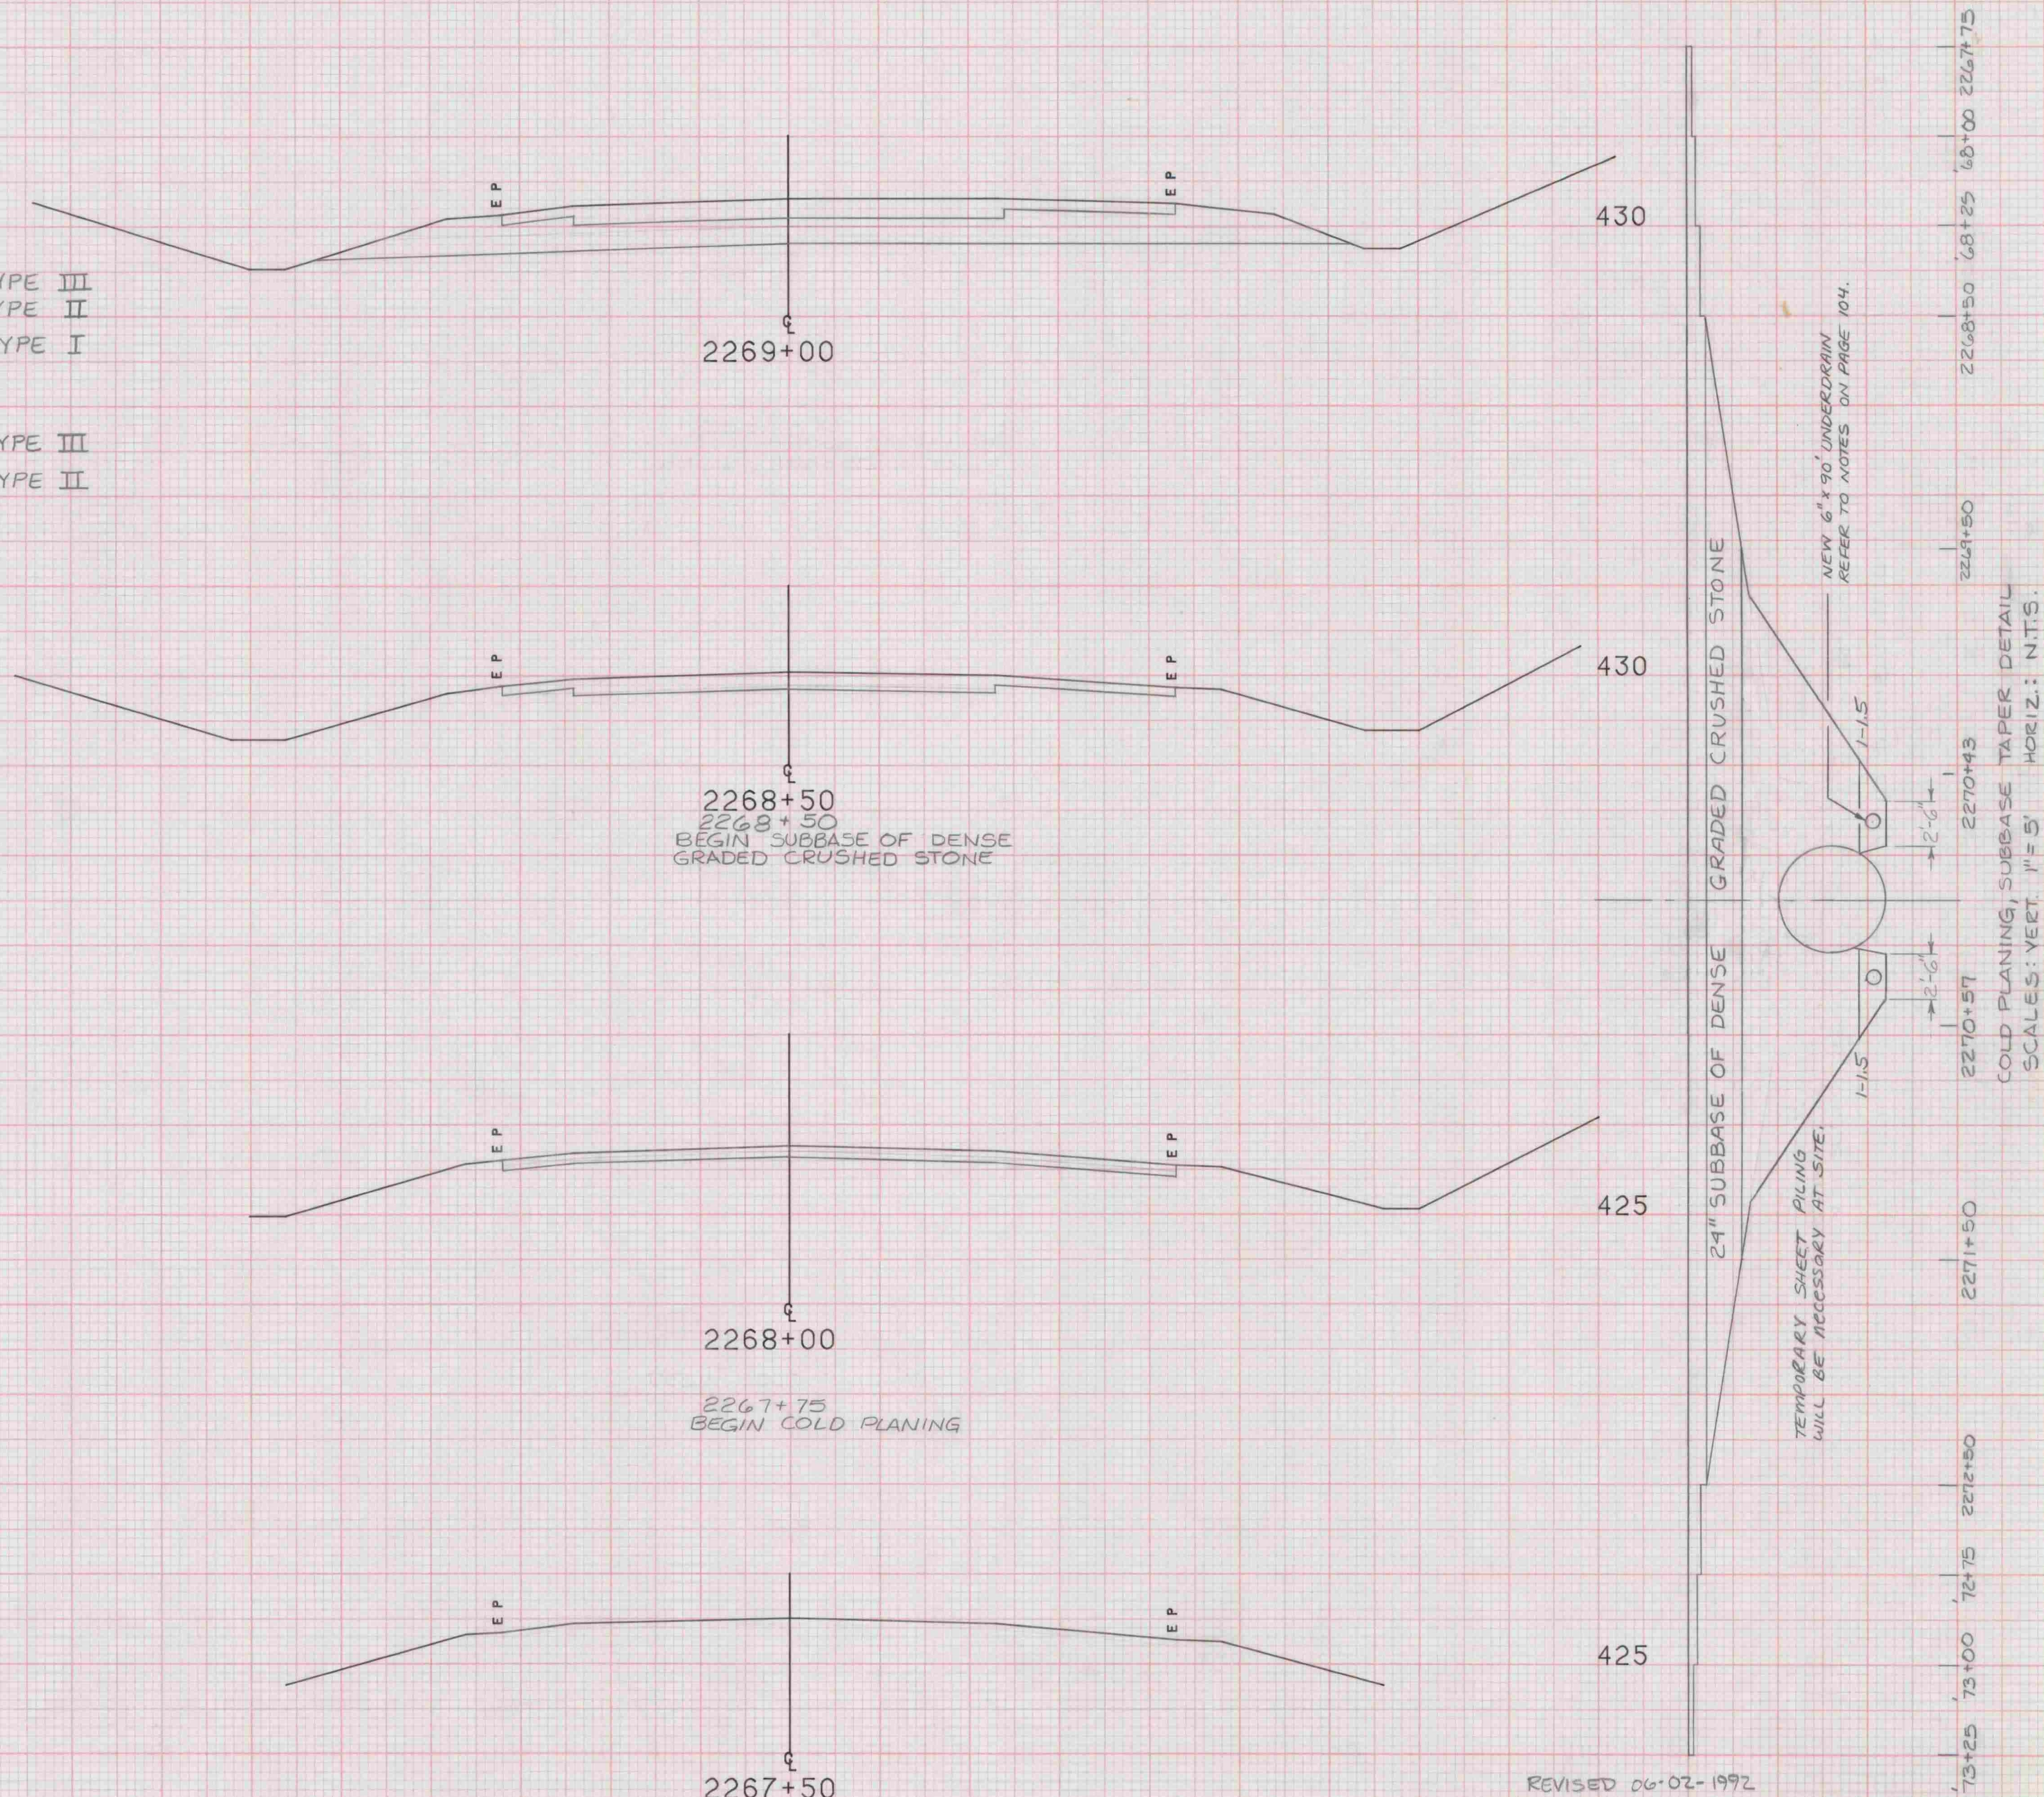

REVISED 06-02-1992
 NORTHBOUND PEDESTRIAN PASS
 FROM STA. 2267+50 TO STA. 2269+00
 PROJECT NAME SPRINGFIELD-HARTFORD MI
 NO. IR091-1 (20) PLOTTED 07/20/90
 SURVEYED BY J. SHERIDAN 06/90 0302
 SHEET 108 OF 133 SHEETS

SCALE 5 FEET

COLD PLANING, SUBBASE TAPER DETAIL
 SCALES: VERT. 1" = 5'
 HORIZ.: N.T.S.