


DATE _____
 BY _____
 PROJECT'S
 PLANTING
 TOPPLATE
 AREA
 SCALE CHECKED
FINAL SURVEY
 NOTE BOOK
 No. _____

DATE _____
 BY _____
 PROJECT'S
 PLANTING
 TOPPLATE
 AREA
 SCALE CHECKED
ORIGINAL SURVEY
 NOTE BOOK
 No. _____

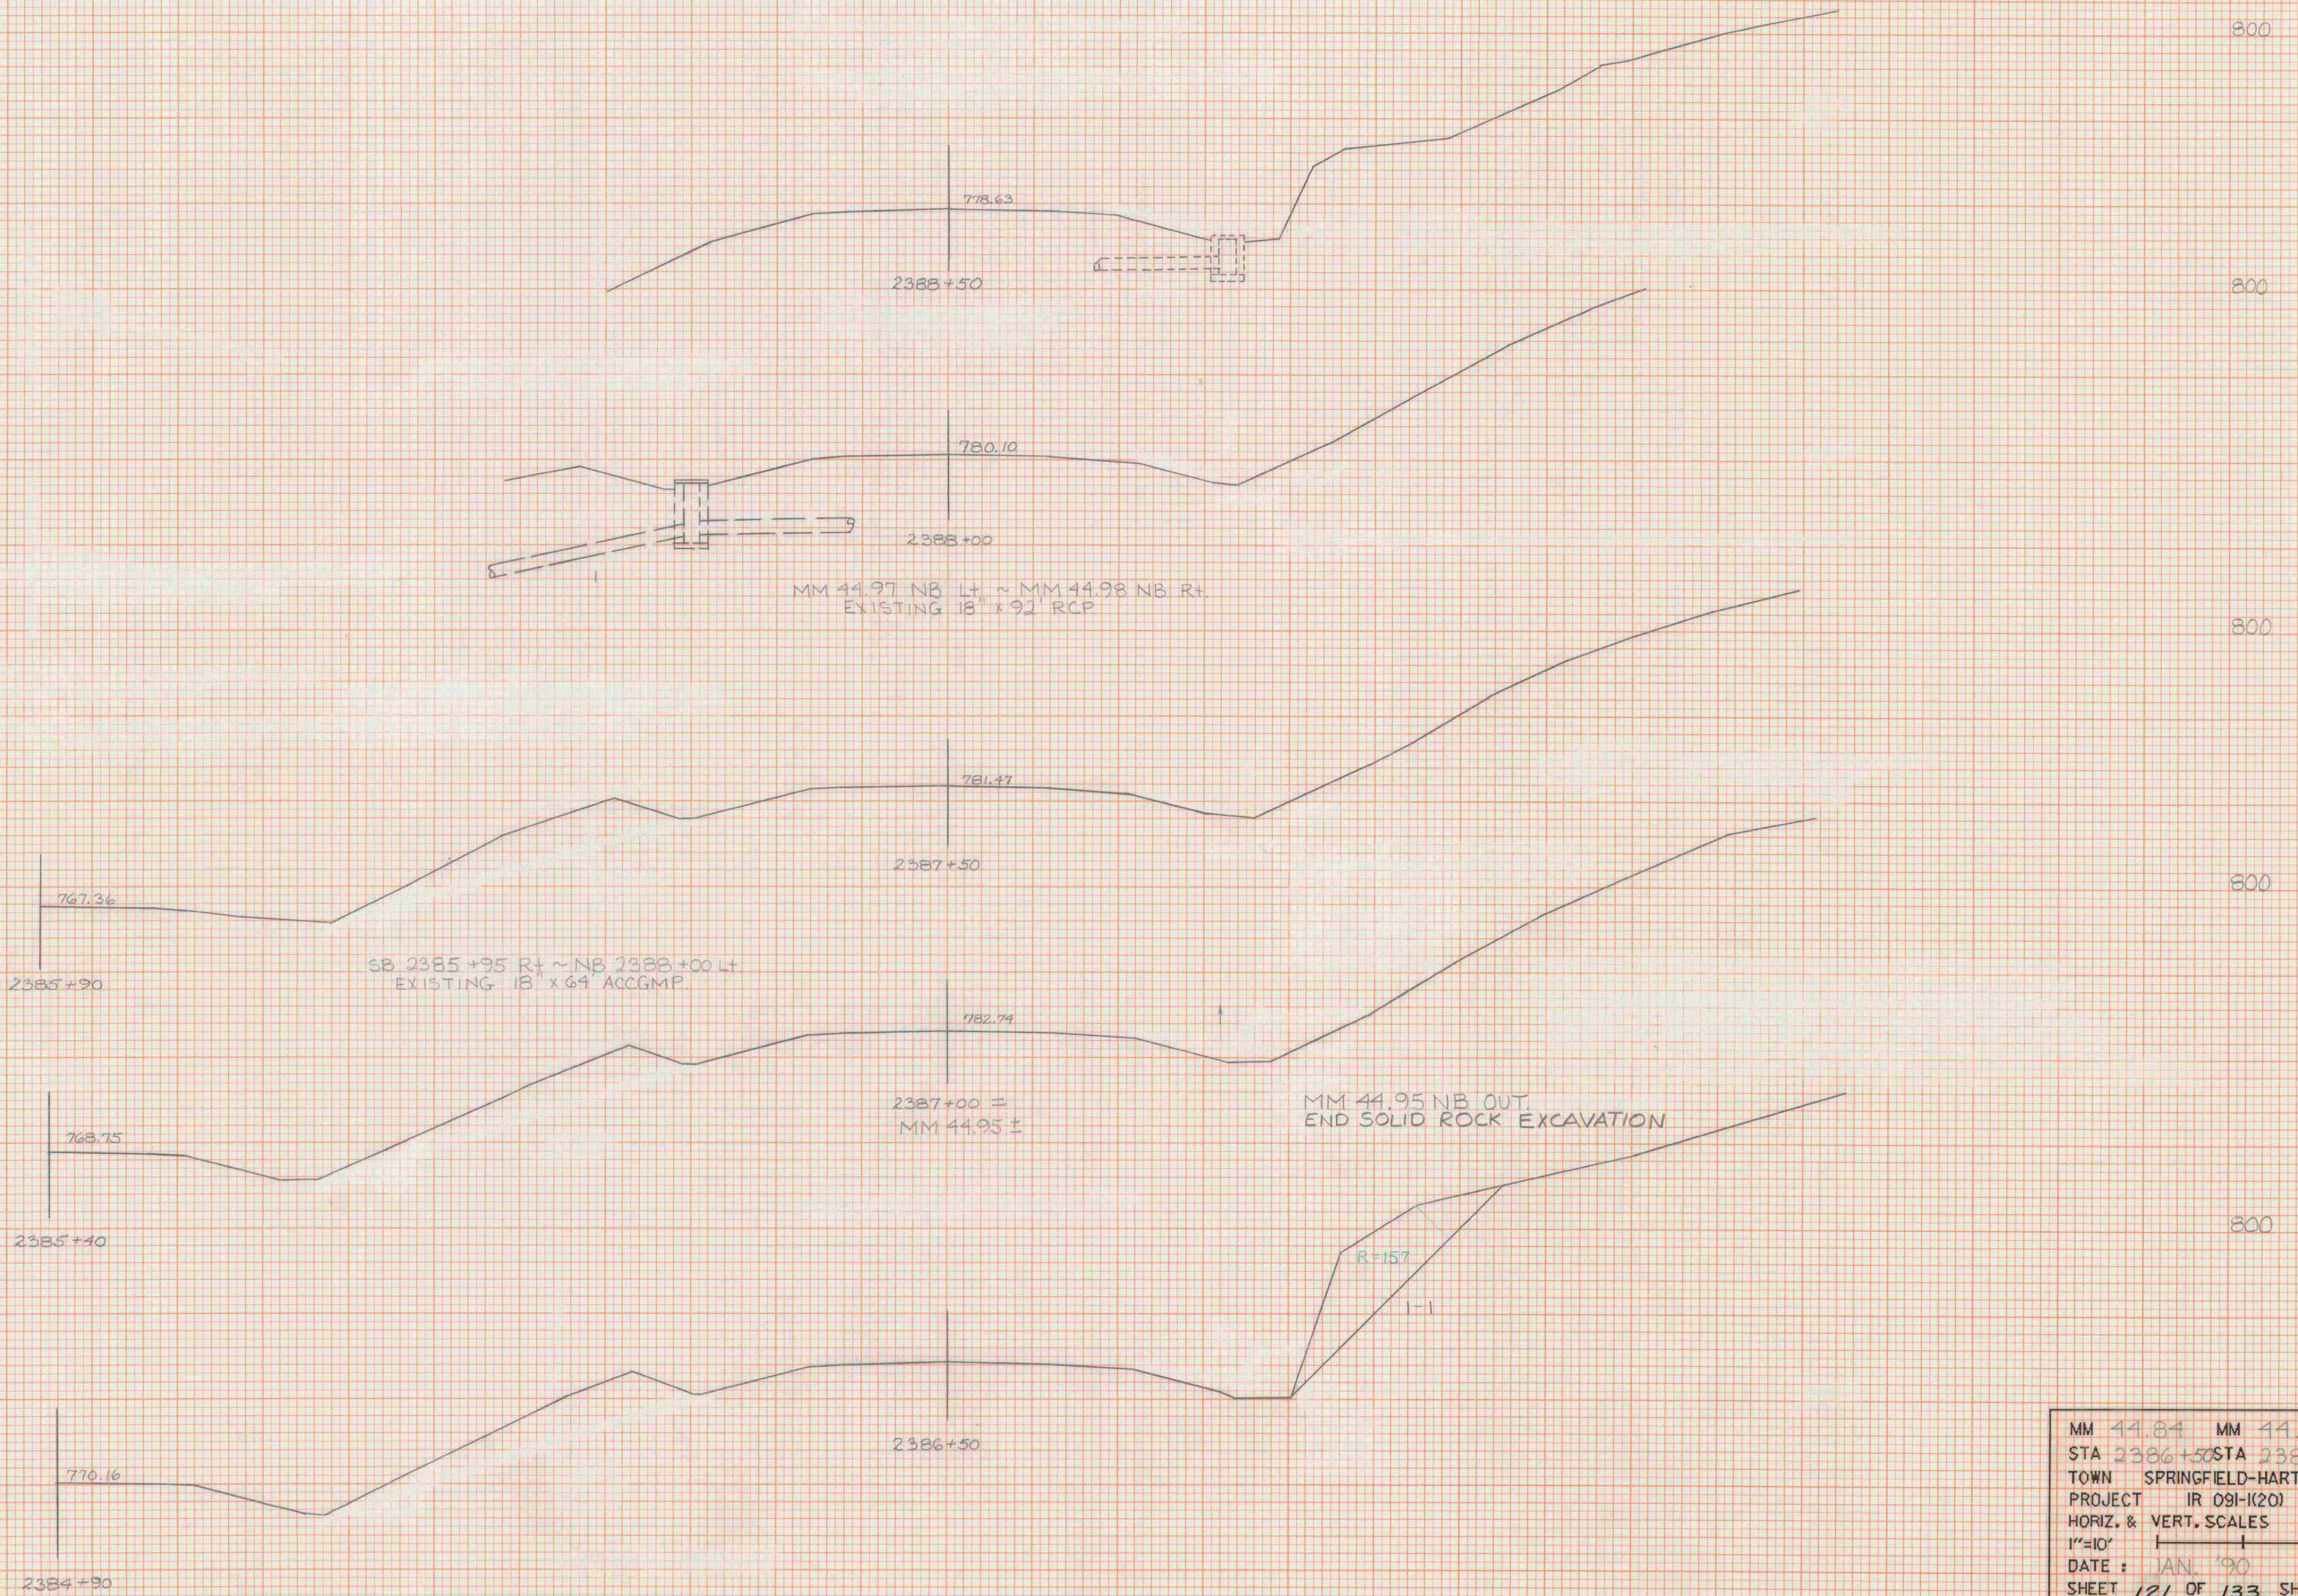

MM 44.84 MM 44.95
 STA 2386+50 STA 2388+50
 TOWN SPRINGFIELD-HARTFORD
 PROJECT IR 091-1(20)
 HORIZ. & VERT. SCALES
 1"=10'
 DATE: JAN. '90
 SHEET 121 OF 133 SHEETS