



DATE	
BY	
REVISIONS	
NO.	
FINAL SURVEY NOTE BOOK No.	

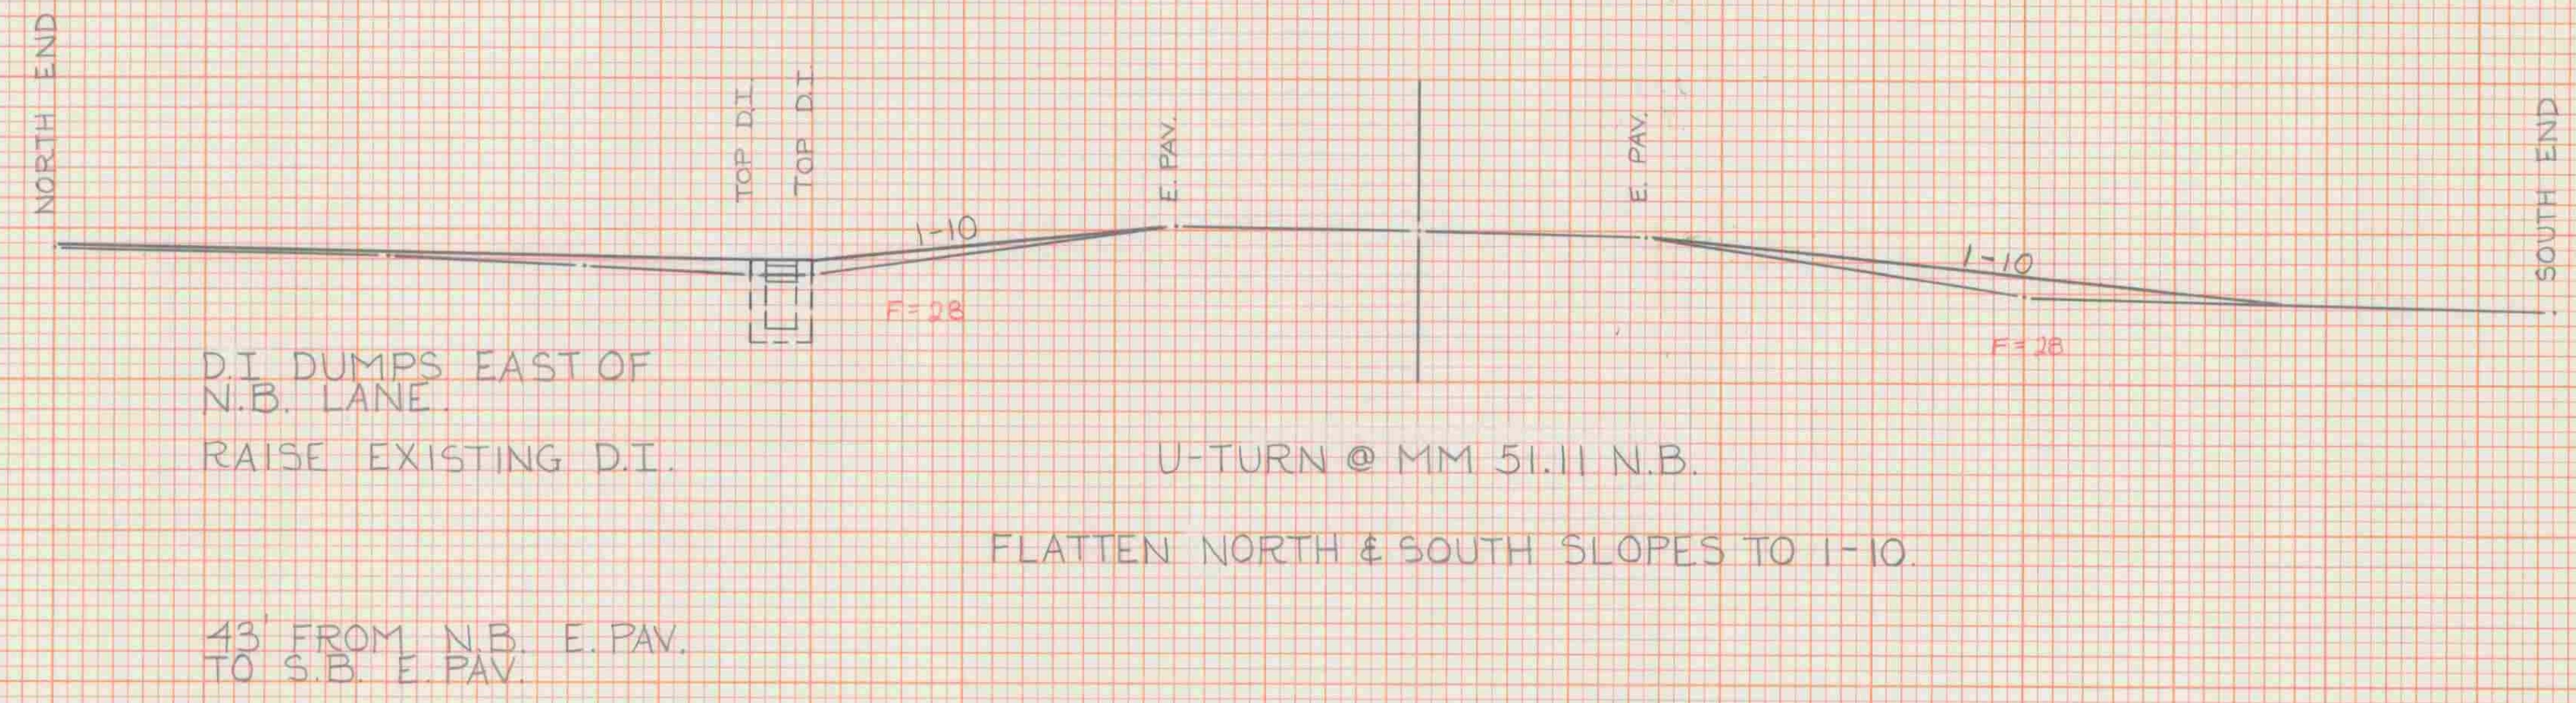

GENERAL NOTE FOR ALL U-TURNS
 THE EXISTING SIGNS ("NO U TURNS")
 MAY NOT HAVE TO BE REMOVED AND
 RESET. THERE SHOULD BE AMPLE ROOM
 FOR THEM TO STAY IN PLACE DURING
 THE REGRADING OF SLOPES

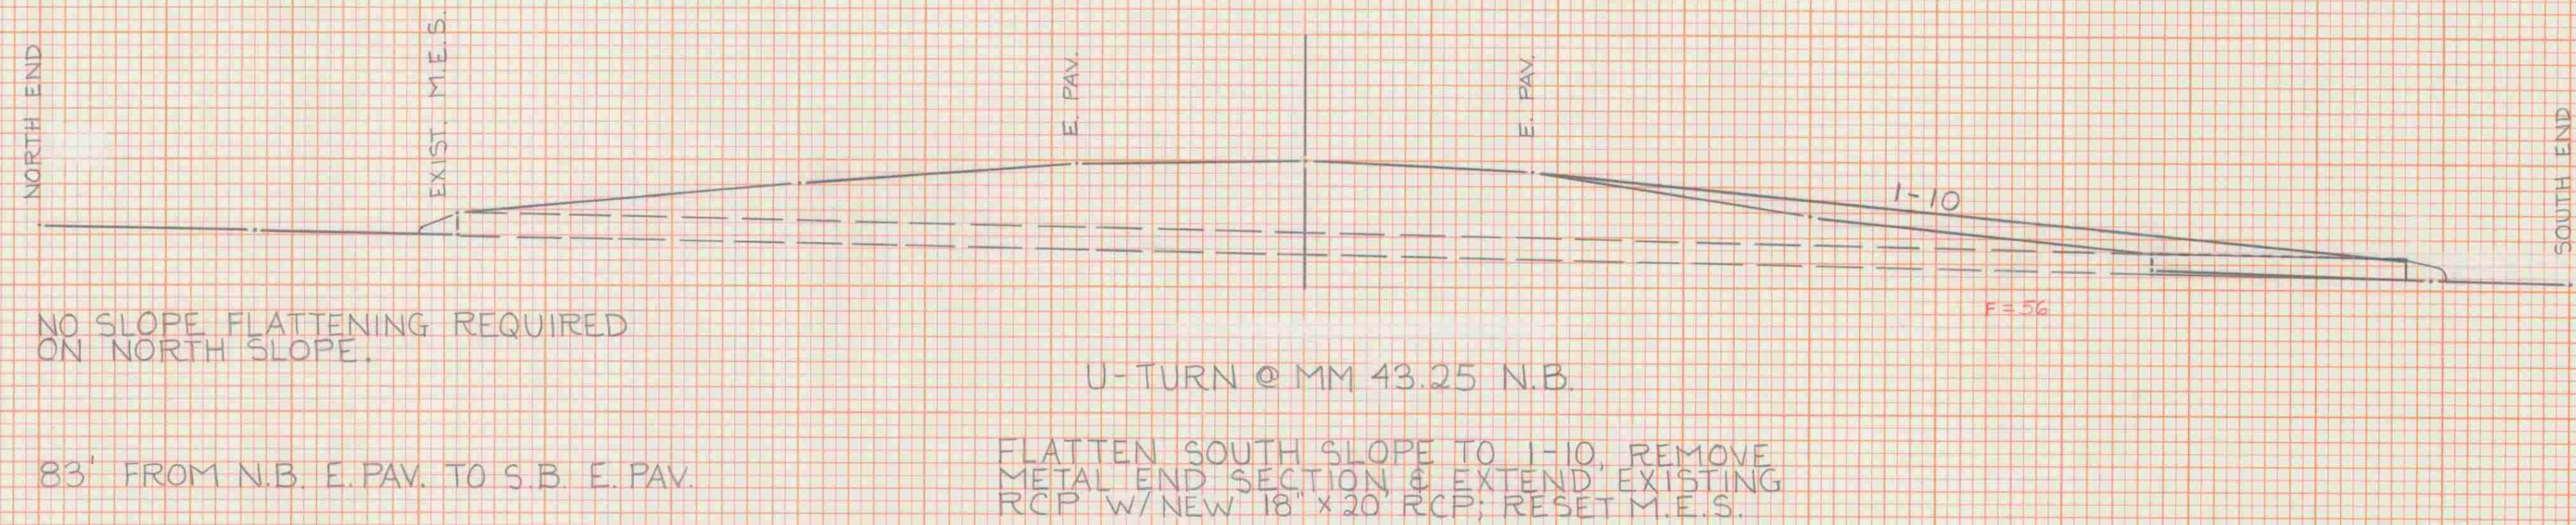

DATE	
BY	
REVISIONS	
NO.	
ORIGINAL SURVEY NOTE BOOK No.	

MM	N/A	MM	N/A
STA	N/A	STA	N/A
TOWN	SPRINGFIELD-HARTFORD		
PROJECT	IR 091-1(20)		
HORIZ. & VERT. SCALES			
1"=10'			
DATE	JAN '90		
SHEET	122	OF	133 SHEETS