


**PROPOSED TRANSVERSE SECTION**

SCALE: 1/2" = 1'-0"

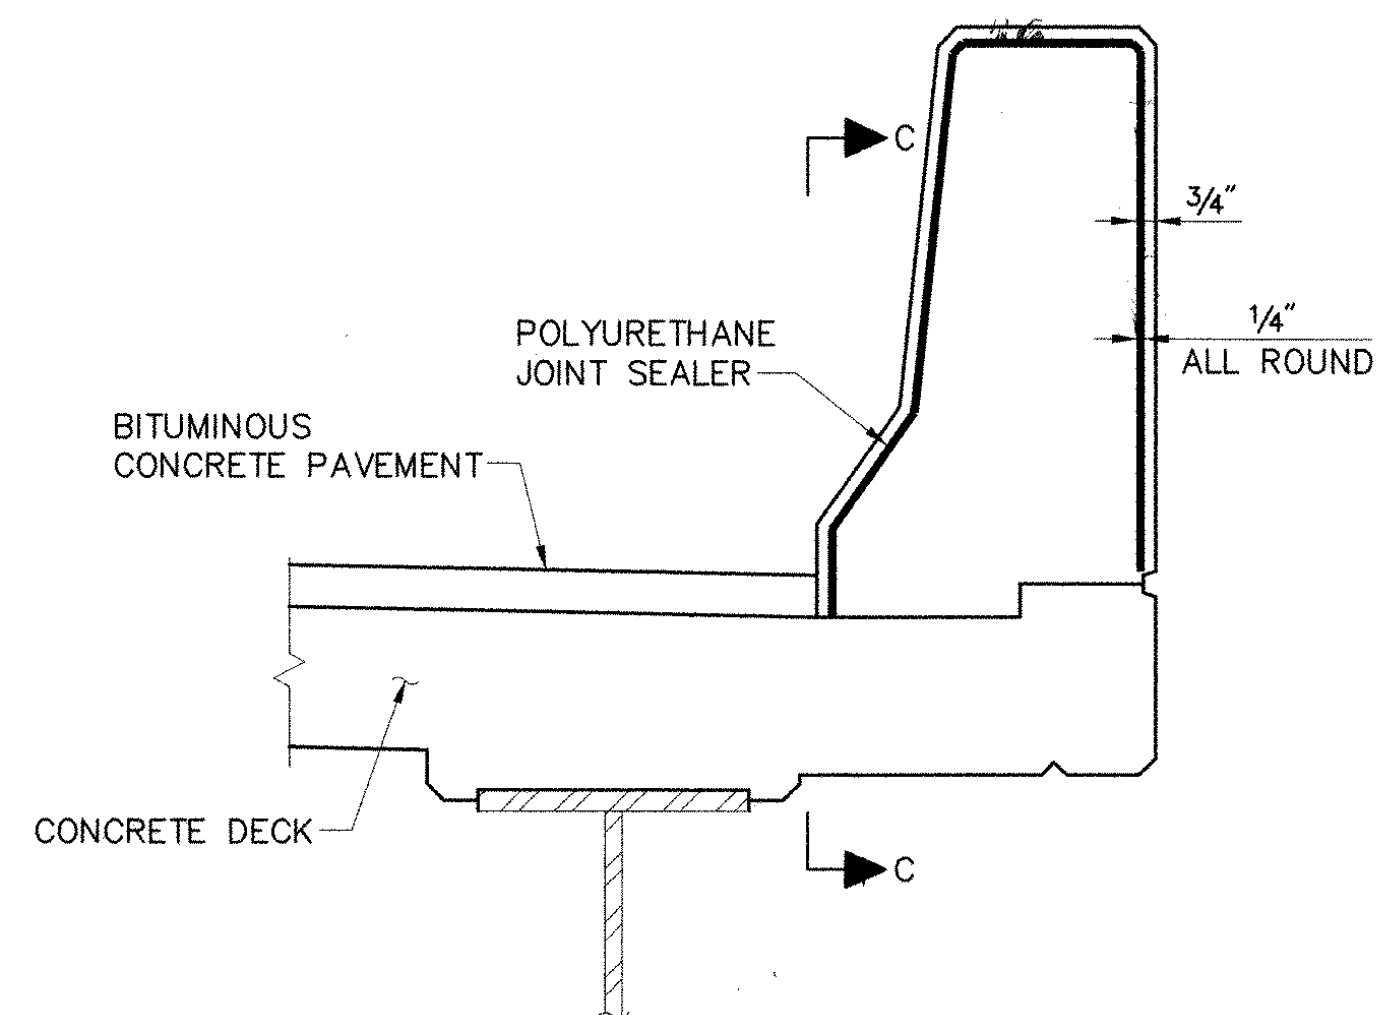


**TYPICAL SECTION THROUGH CONCRETE BRIDGE BARRIER CURB CONSTRUCTION JOINT**

SCALE: 1" = 1'-0"

**BARRIER CURB CONSTRUCTION JOINT NOTES:**


1. CONSTRUCTION JOINTS THROUGH CONCRETE BARRIER CURB SHALL BE SPACED 20'-0" CENTER TO CENTER MAXIMUM. CONCRETE SHALL BE PLACED IN ALTERNATING SECTIONS WITH A MINIMUM OF 48 HOURS BETWEEN ADJACENT POURS.
2. LONGITUDINAL REINFORCING SHALL PASS THROUGH CONCRETE BARRIER CURB CONSTRUCTION JOINTS.

POLYURETHANE JOINT SEALER PER SUBSECTION 524.06C COLOR TO MATCH CONCRETE. COST TO BE INCLUDED IN THE UNIT PRICE BID FOR THE ITEM "CONCRETE, CLASS A (MOD.)".

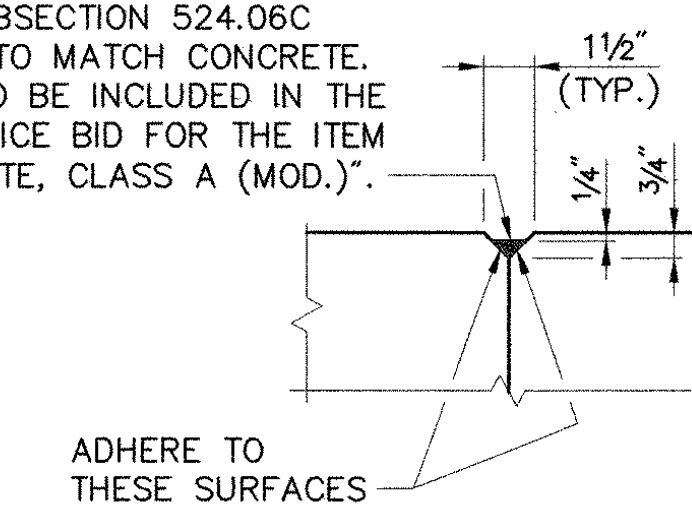

**DETAIL B**

N.T.S.

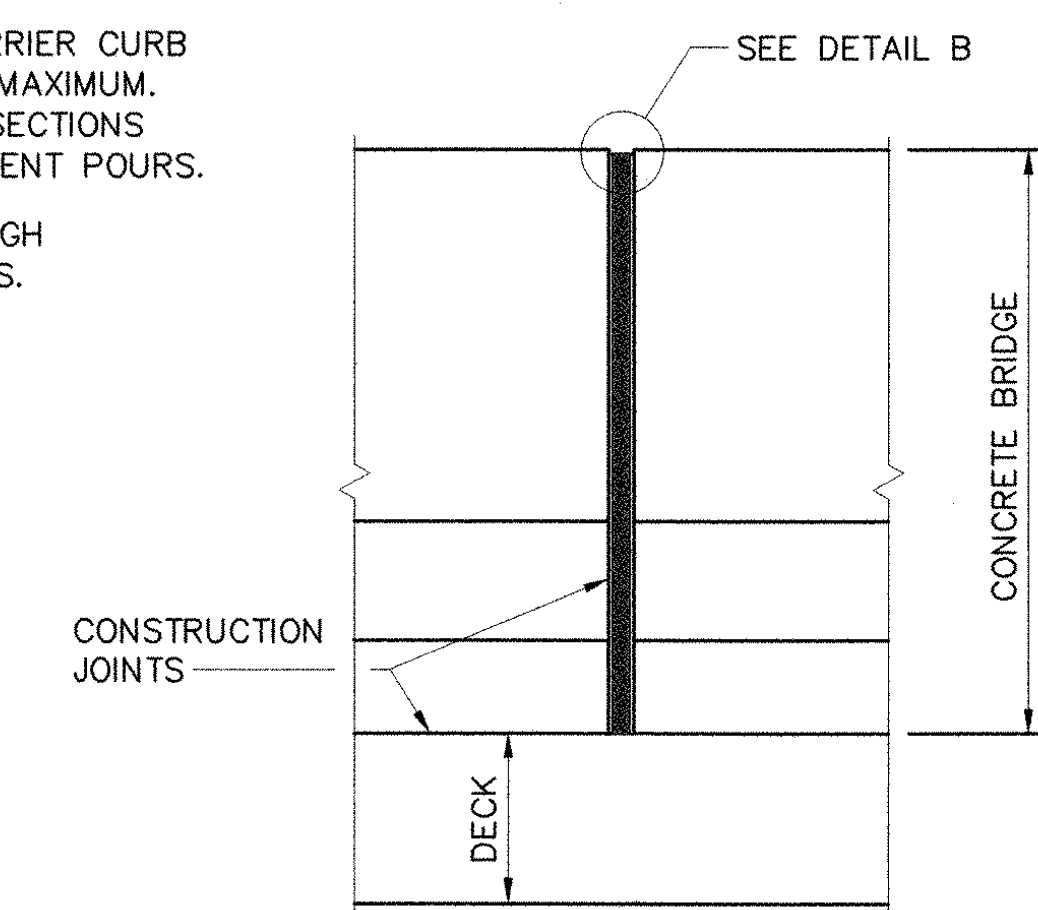


**SECTION C-C**

SCALE: 1" = 1'-0"

LOADING LEVELS (LOAD FACTORS)	TRUCK						
	H	HS	3S2	6 AXLE	3A STR	4A STR	5A SEMI
INVENTORY A=2.17 B=1.00	28	51					
POSTED A=1.55 B=1.40	40	72	114*		124	125	136
OPERATING A=1.30 B=1.67		85	172*	185	147	149	

STRENGTH  $RF = \frac{\phi M_N - 1.3 M_{LL}}{A \times M_{LLH}}$  \*SERVICEABILITY  $RF = B \frac{.95 F_y S_{LLH} - M_{DL} - M_{SL}}{1.67 M_{LLH}}$

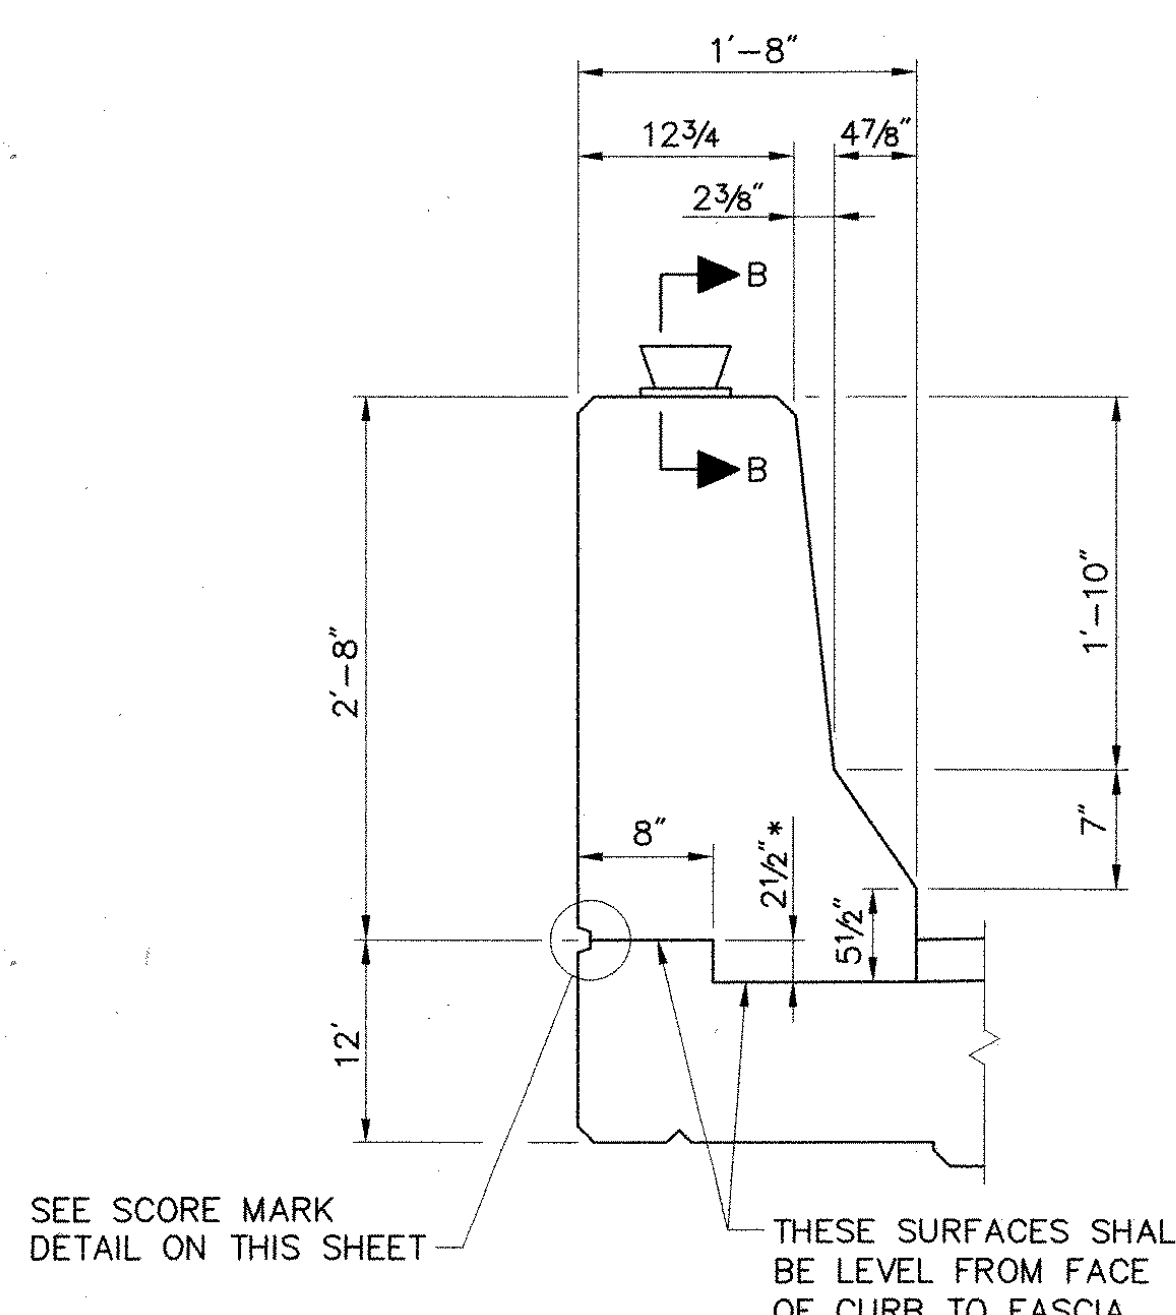


**DETAIL A**

SCALE: 1" = 1'-0"

SEE SCORE MARK DETAIL ON THIS SHEET. THESE SURFACES SHALL BE LEVEL FROM FACE OF CURB TO FASCIA

\* THIS KEY IS 2 1/2" INSTEAD OF THE "STANDARD" 2" TO SIMPLIFY FORM WORK AT ABUTMENT EXPANSION JOINTS.

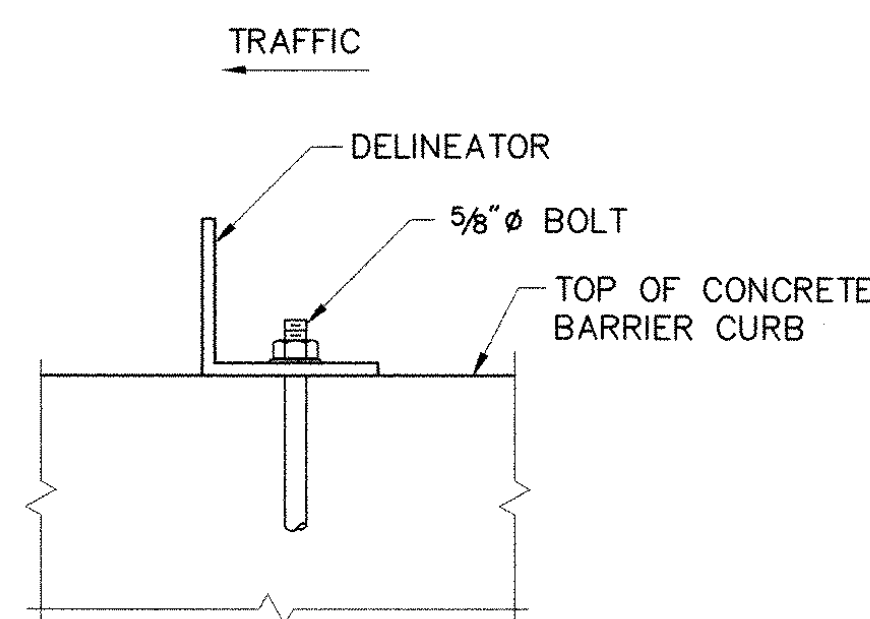


**SECTION B-B**

N.T.S.


**DELINEATOR NOTES:**

1. PAYMENT FOR DELINEATOR SHALL BE SUBSIDIARY TO THE ITEM "CONCRETE, CLASS A (MOD.)".
2. DELINEATORS SHALL BE SPACED AT 30' MAX.
3. DELINEATORS SHALL BE AMBER OR WHITE WITH AMBER ON THE MEDIAN SIDE.
4. SEE STANDARD DRAWING G-1 FOR ADDITIONAL DETAILS OF DELINEATOR.

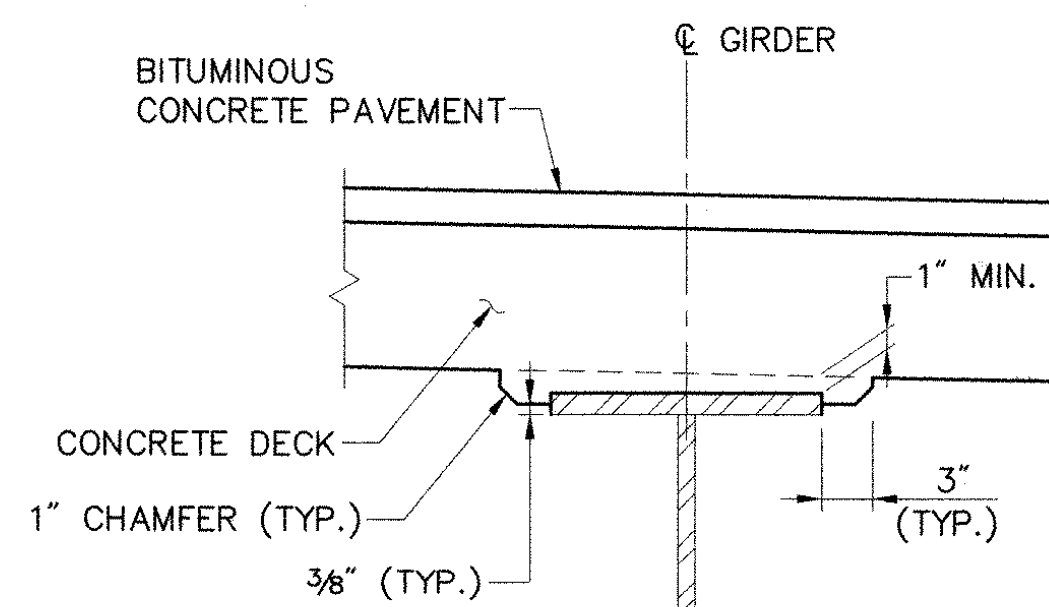

**HAUNCH DETAIL**

SCALE: 1" = 1'-0"

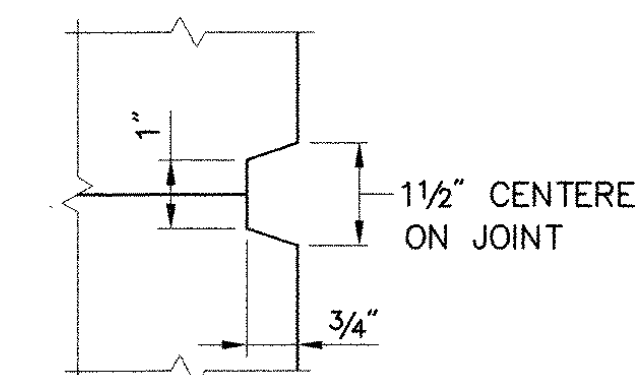

**SCORE MARK DETAIL**

N.T.S.

<b>STATE OF VERMONT AGENCY OF TRANSPORTATION</b>	
Town Of <b>HARTFORD</b>	Bridge No. 11N & 11S
Highway No. <b>I-89 NB &amp; SB</b>	Log Sta.
<b>I-89 NB &amp; SB OVER WHITE RIVER, VT 14 &amp; NECR</b>	
<b>TRANSVERSE SECTION</b>	
Designed By <b>S.M. HODGDON</b>	Drawn By <b>B.J. MASSE</b>
Checked By <b>T.S. BRYANT</b>	Date <b>9/98</b>
<b>C.D. BAKER</b> Date <b>9/98</b>	
PROJECT <b>HARTFORD</b>	PROJECT NO. <b>IR 089-1(13)</b>
VHB Cod Filename <b>50699TRN</b>	
Bridge Sheet No. <b>5</b>	Sheet <b>5</b> of <b>101</b>

VANASSE HANGEN BRUSTLIN, INC.