




ABUTMENTS 3 & 4 MASONRY PLAN*
SCALE: 3/16" = 1'-0"

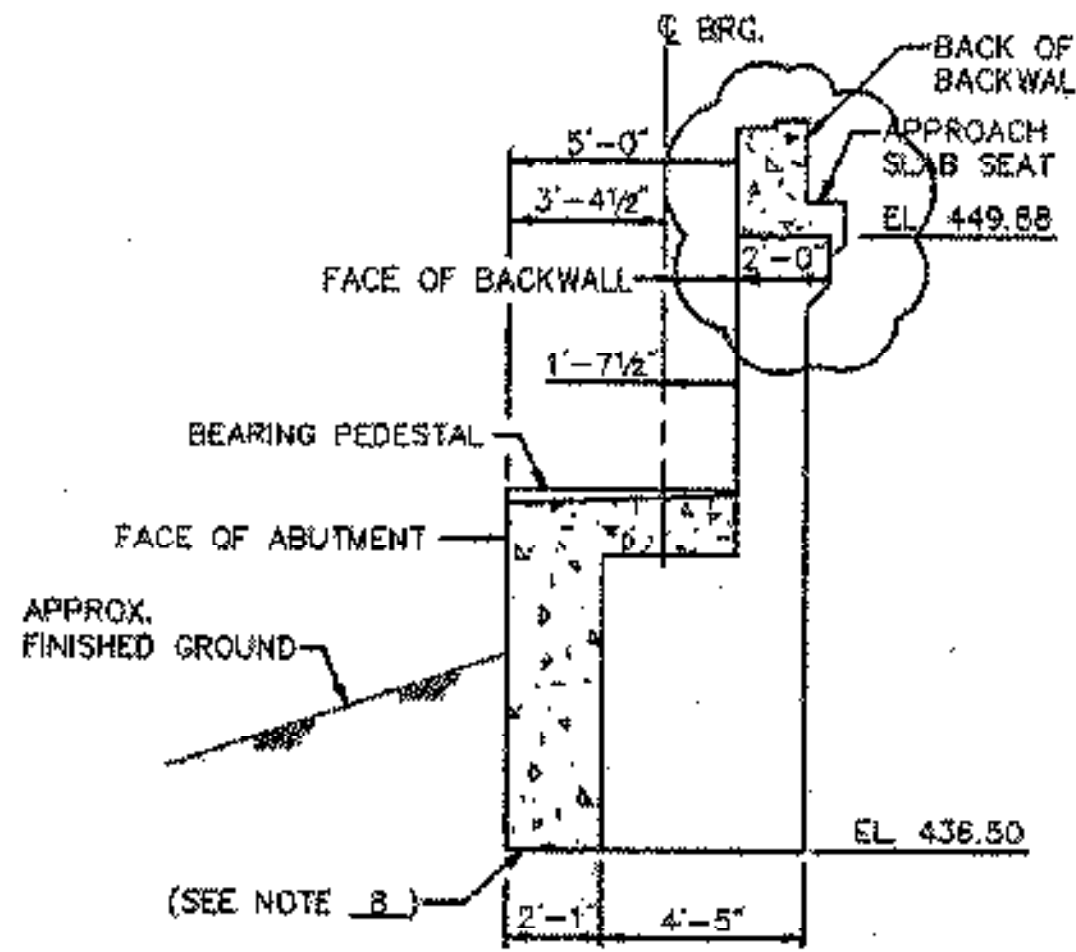


ABUTMENT 3 SECTION A-A
SCALE: 1/4" = 1'-0"

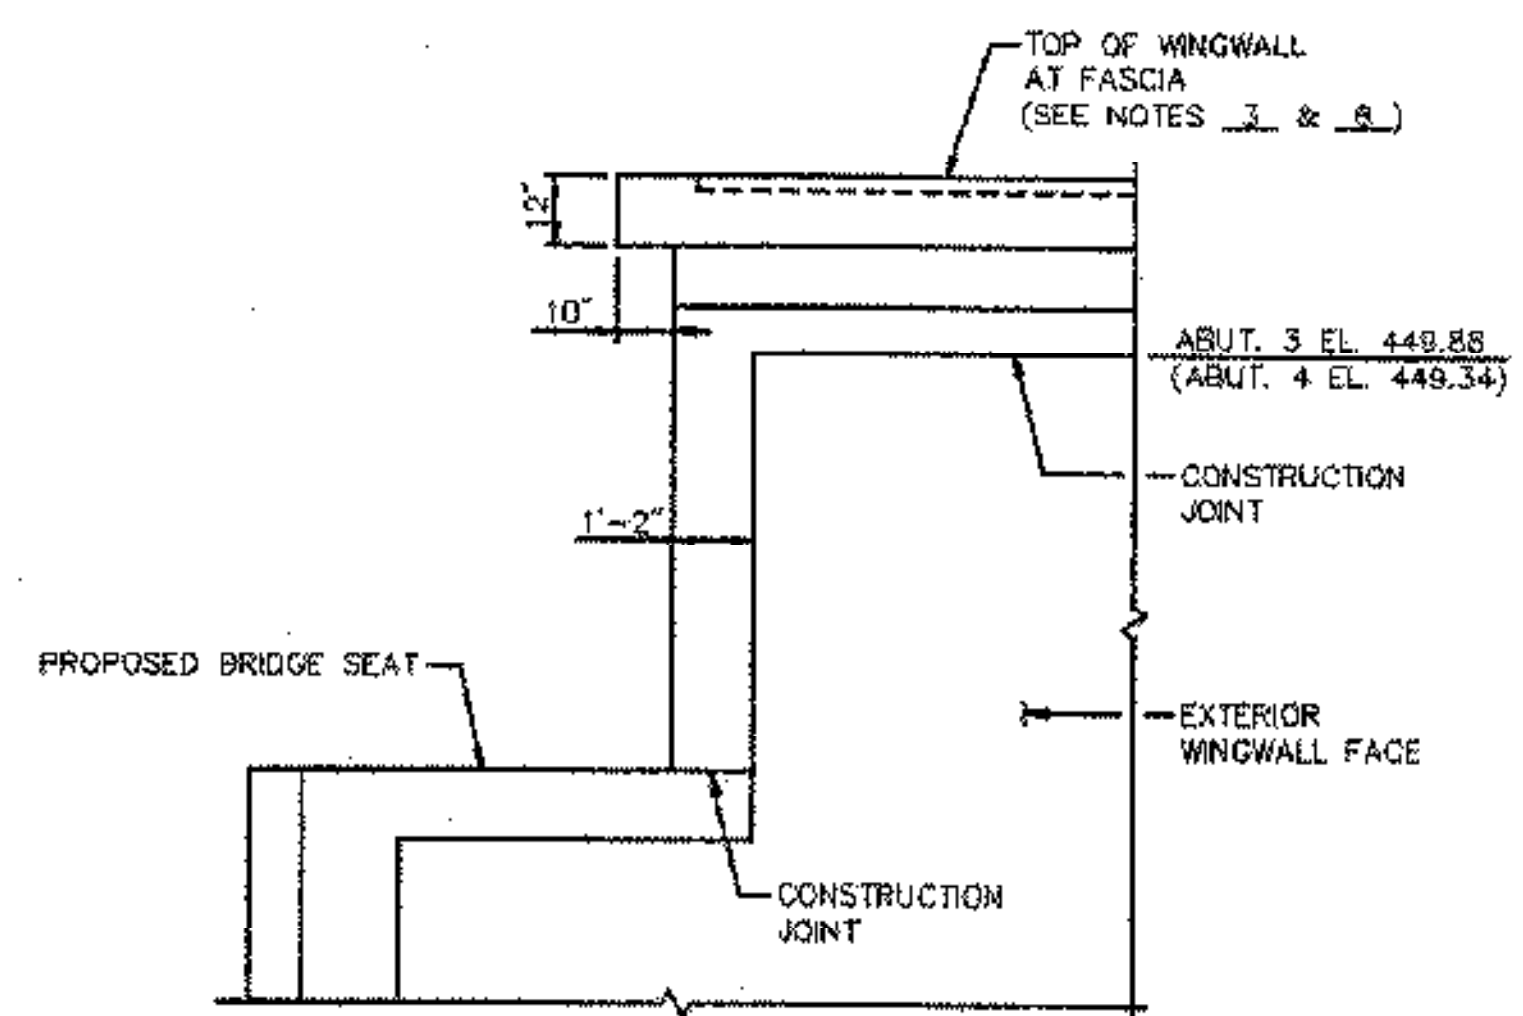

VIEW B-B
SCALE: 3/8" = 1'-0"

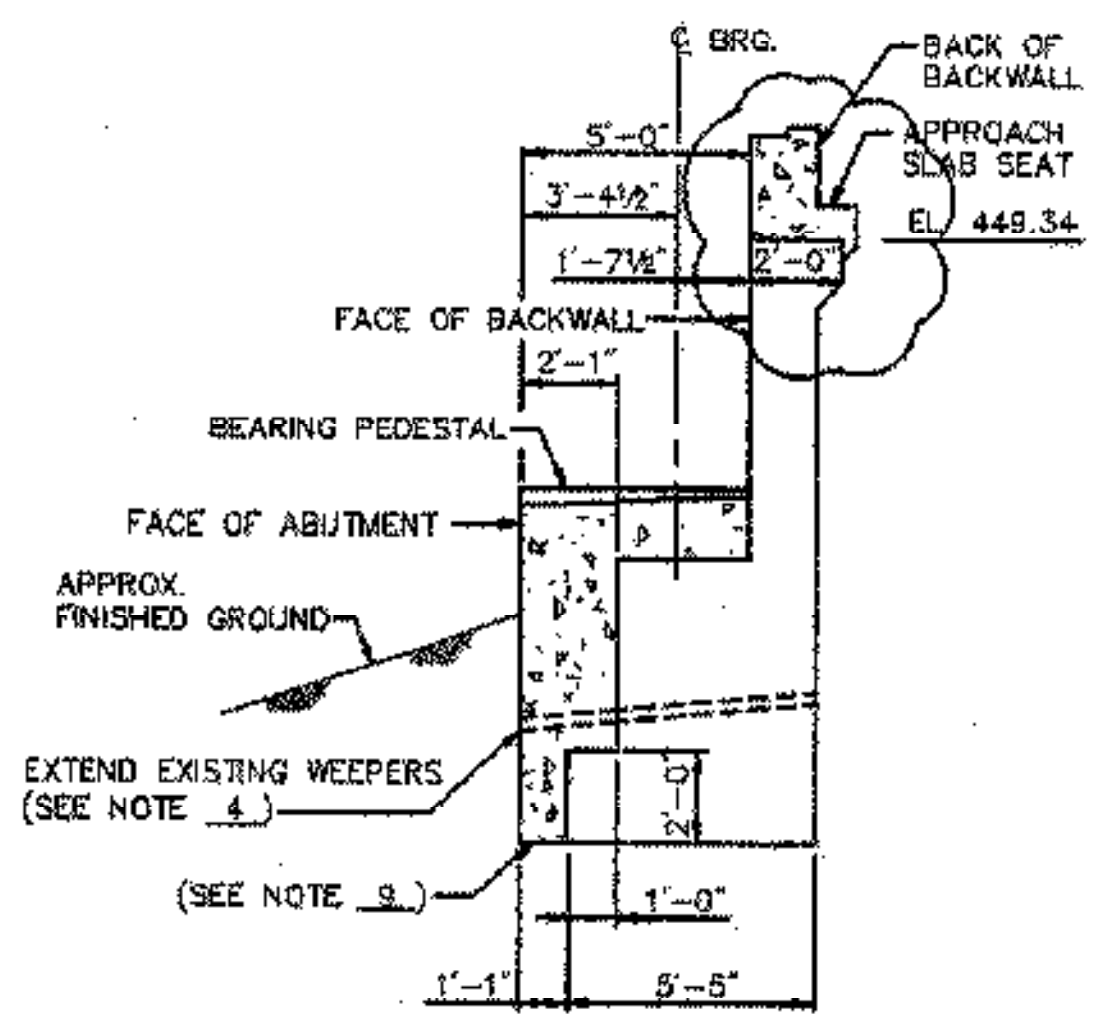


ABUTMENT 4 SECTION A-A
SCALE: 1/4" = 1'-0"

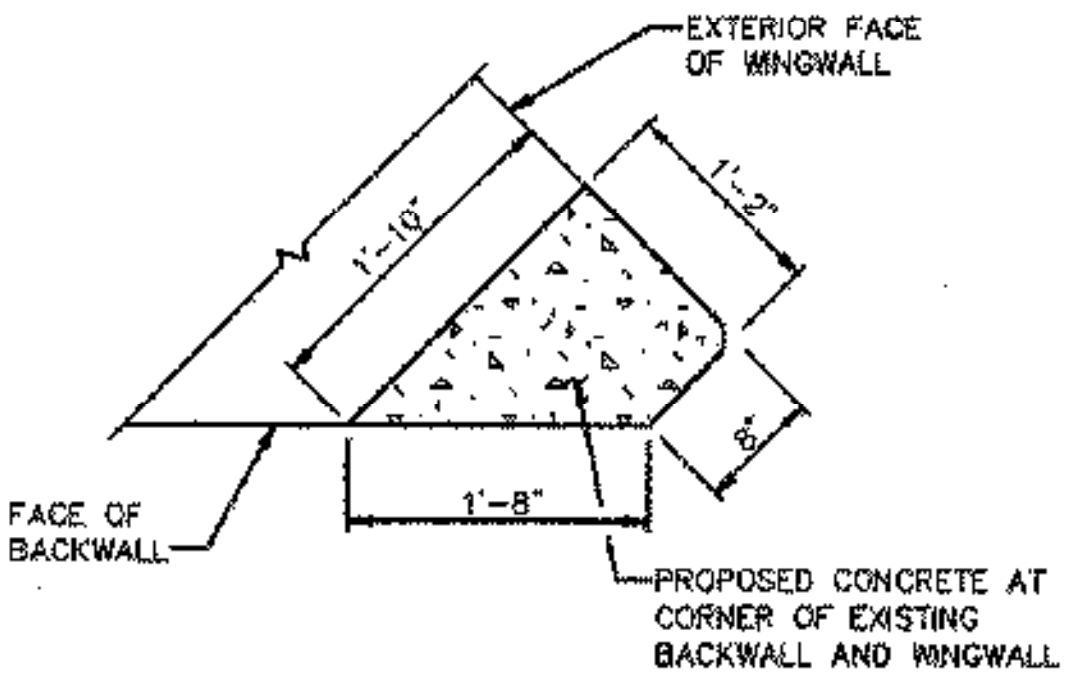


SECTION C-C
SCALE: 1" = 1'-0"

APPROACH SLAB REPLACEMENT REVISIONS 6/99

- NOTES:**
1. PROPOSED BEARING PEDESTAL ELEVATIONS WERE CALCULATED BASED ON THE EXISTING BEARING SEAT ELEVATIONS AND BEARING HEIGHTS SHOWN IN THE ORIGINAL DESIGN PLANS. THE CONTRACTOR SHALL TAKE FIELD MEASUREMENTS AND ADJUST THE PROPOSED PEDESTAL ELEVATIONS AS NECESSARY TO MAINTAIN THE EXISTING BOTTOM OF GIRDER ELEVATIONS.
 2. CONCRETE FOR ABUTMENT MODIFICATIONS SHALL BE PAID UNDER ITEM 501.22, "CONCRETE, CLASS A".
 3. FOR TOP OF WINGWALL ELEVATIONS SEE TABLE ON SHEET 33.
 4. THE CONTRACTOR SHALL PROVIDE A WATERTIGHT, CORROSION RESISTANT EXTENSION OF THE EXISTING WEEPERS THROUGH THE NEW ABUTMENT CONCRETE. PAY PARTICULAR ATTENTION TO ENSURE THAT THE CONNECTION FROM THE EXISTING WEEPERS TO THE PROPOSED WEEPERS IS WATERTIGHT AND PERMANENT. THE CONTRACTOR SHALL PROPOSE THE MATERIALS AND MEANS AND METHODS OF CONSTRUCTION. SUBMIT THE PROPOSED SYSTEM TO THE ENGINEER FOR APPROVAL. COST FOR EXTENDING WEEPERS SHALL BE INCLUDED IN ITEM 501.22, "CONCRETE, CLASS A".
 5. SEE SHEETS 15 & 16 FOR DETAILS OF FINGER PLATES AT EXPANSION JOINT.
 6. CONCRETE BRIDGE BARRIER CURB ON WINGWALLS NOT SHOWN. SEE SHEETS 32 & 33 AND 40-42 FOR DETAILS OF BARRIER CURB ON WINGWALLS.
 7. EXCAVATION AND BACKFILLING OF EXISTING GROUND REQUIRED TO CONSTRUCT THE ABUTMENT MODIFICATIONS SHALL BE INCLUDED IN ITEM 529.20.
 8. A MINIMUM OF 2 FEET OF ITEM 301.35, "SUBBASE OF DENSE GRADED CRUSHED STONE" SHALL BE PLACED BELOW THE BOTTOM OF THE ABUTMENT 3 SEAT EXTENSION.
 9. THE BOTTOM OF THE ABUTMENT 4 SEAT EXTENSION SHALL BE FOUNDED ON LEDGE.
 10. SEE SHEET 27 FOR DETAIL A AND DETAIL B.

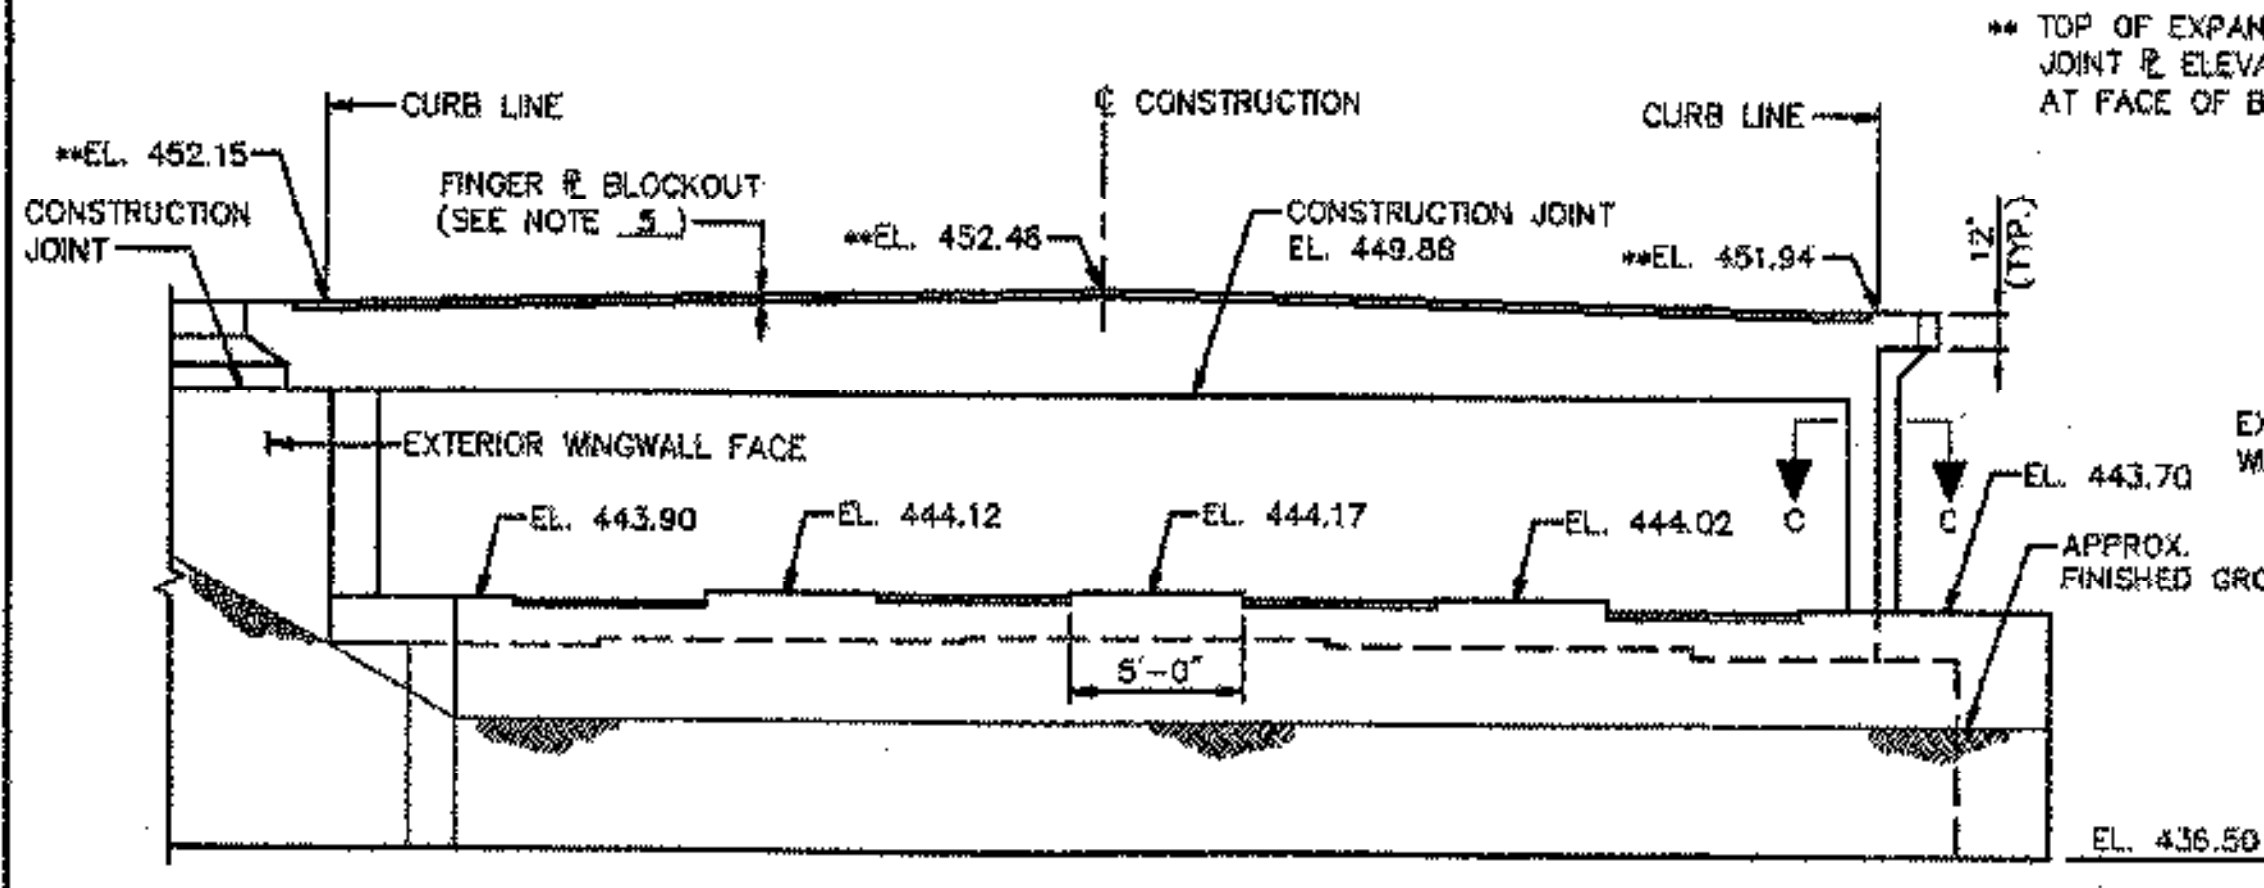

ABUTMENT 3 ELEVATION (NORMAL TO BACKWALL)*
SCALE: 3/16" = 1'-0"

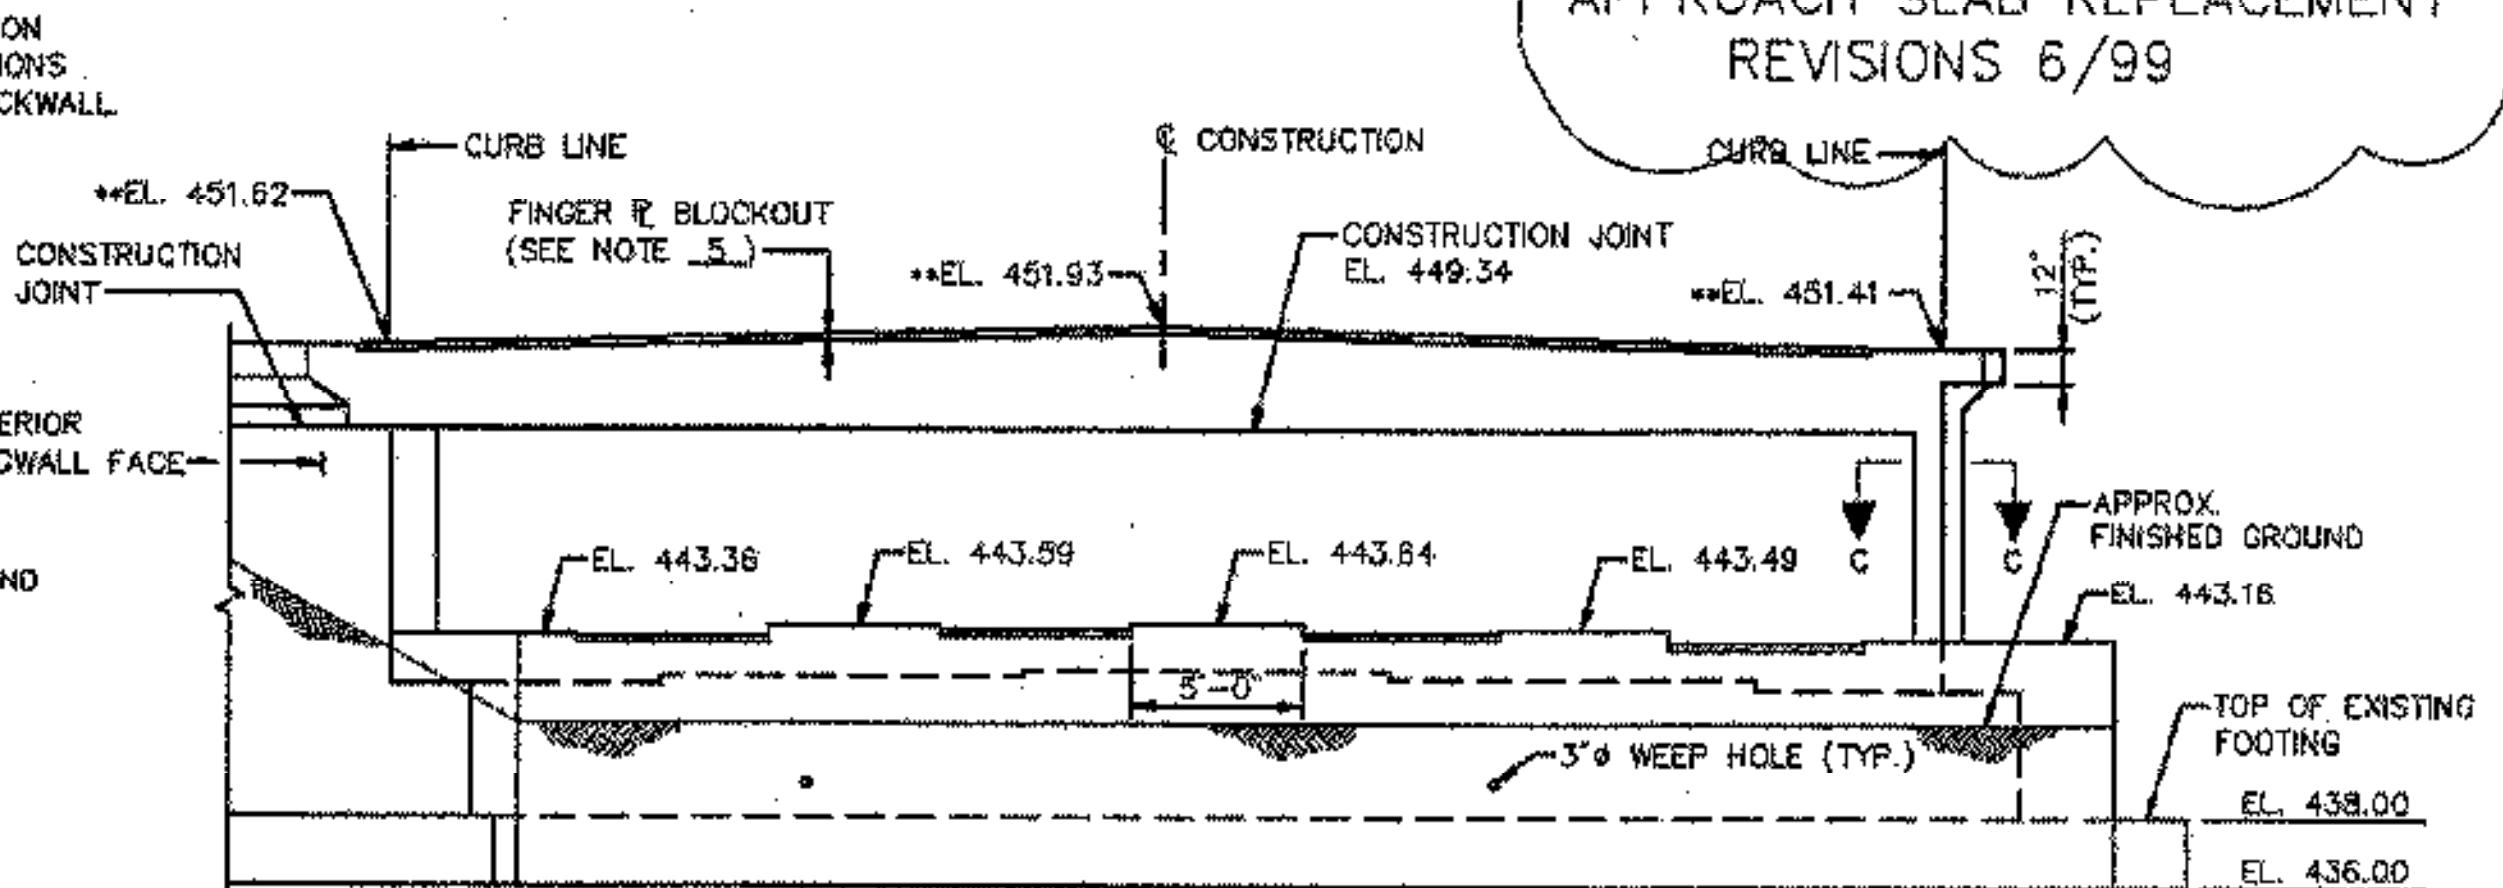

ABUTMENT 4 ELEVATION (NORMAL TO BACKWALL)
SCALE: 3/16" = 1'-0"

* COLUMNS AND FOOTINGS NOT SHOWN FOR CLARITY

STATE OF VERMONT AGENCY OF TRANSPORTATION	
Town Of HARTFORD	Bridge No. 11N & 11S
Highway No. 1-89 NB & SB	Log Sta. Surv. Sta.
1-89 NB & SB OVER WHITE RIVER, VT 14 & NECR	
ABUTMENT 3 & 4 MODIFICATIONS	
Designed By S.M. HODGDON	Drawn By B.J. MASSE
Checked By T.S. BRYANT	Date 9/98
C.D. BAKER Date 6/99	
PROJECT HARTFORD	PROJECT NO. IR 089-1(13)
VHB Cad Filename 50699A3MREV	
Bridge Sheet No. 28R	Sheet 28R of 101

VANASSE HANGEN BRUSTLIN, INC.