



PLAN
SCALE: 1/8" = 1'-0"

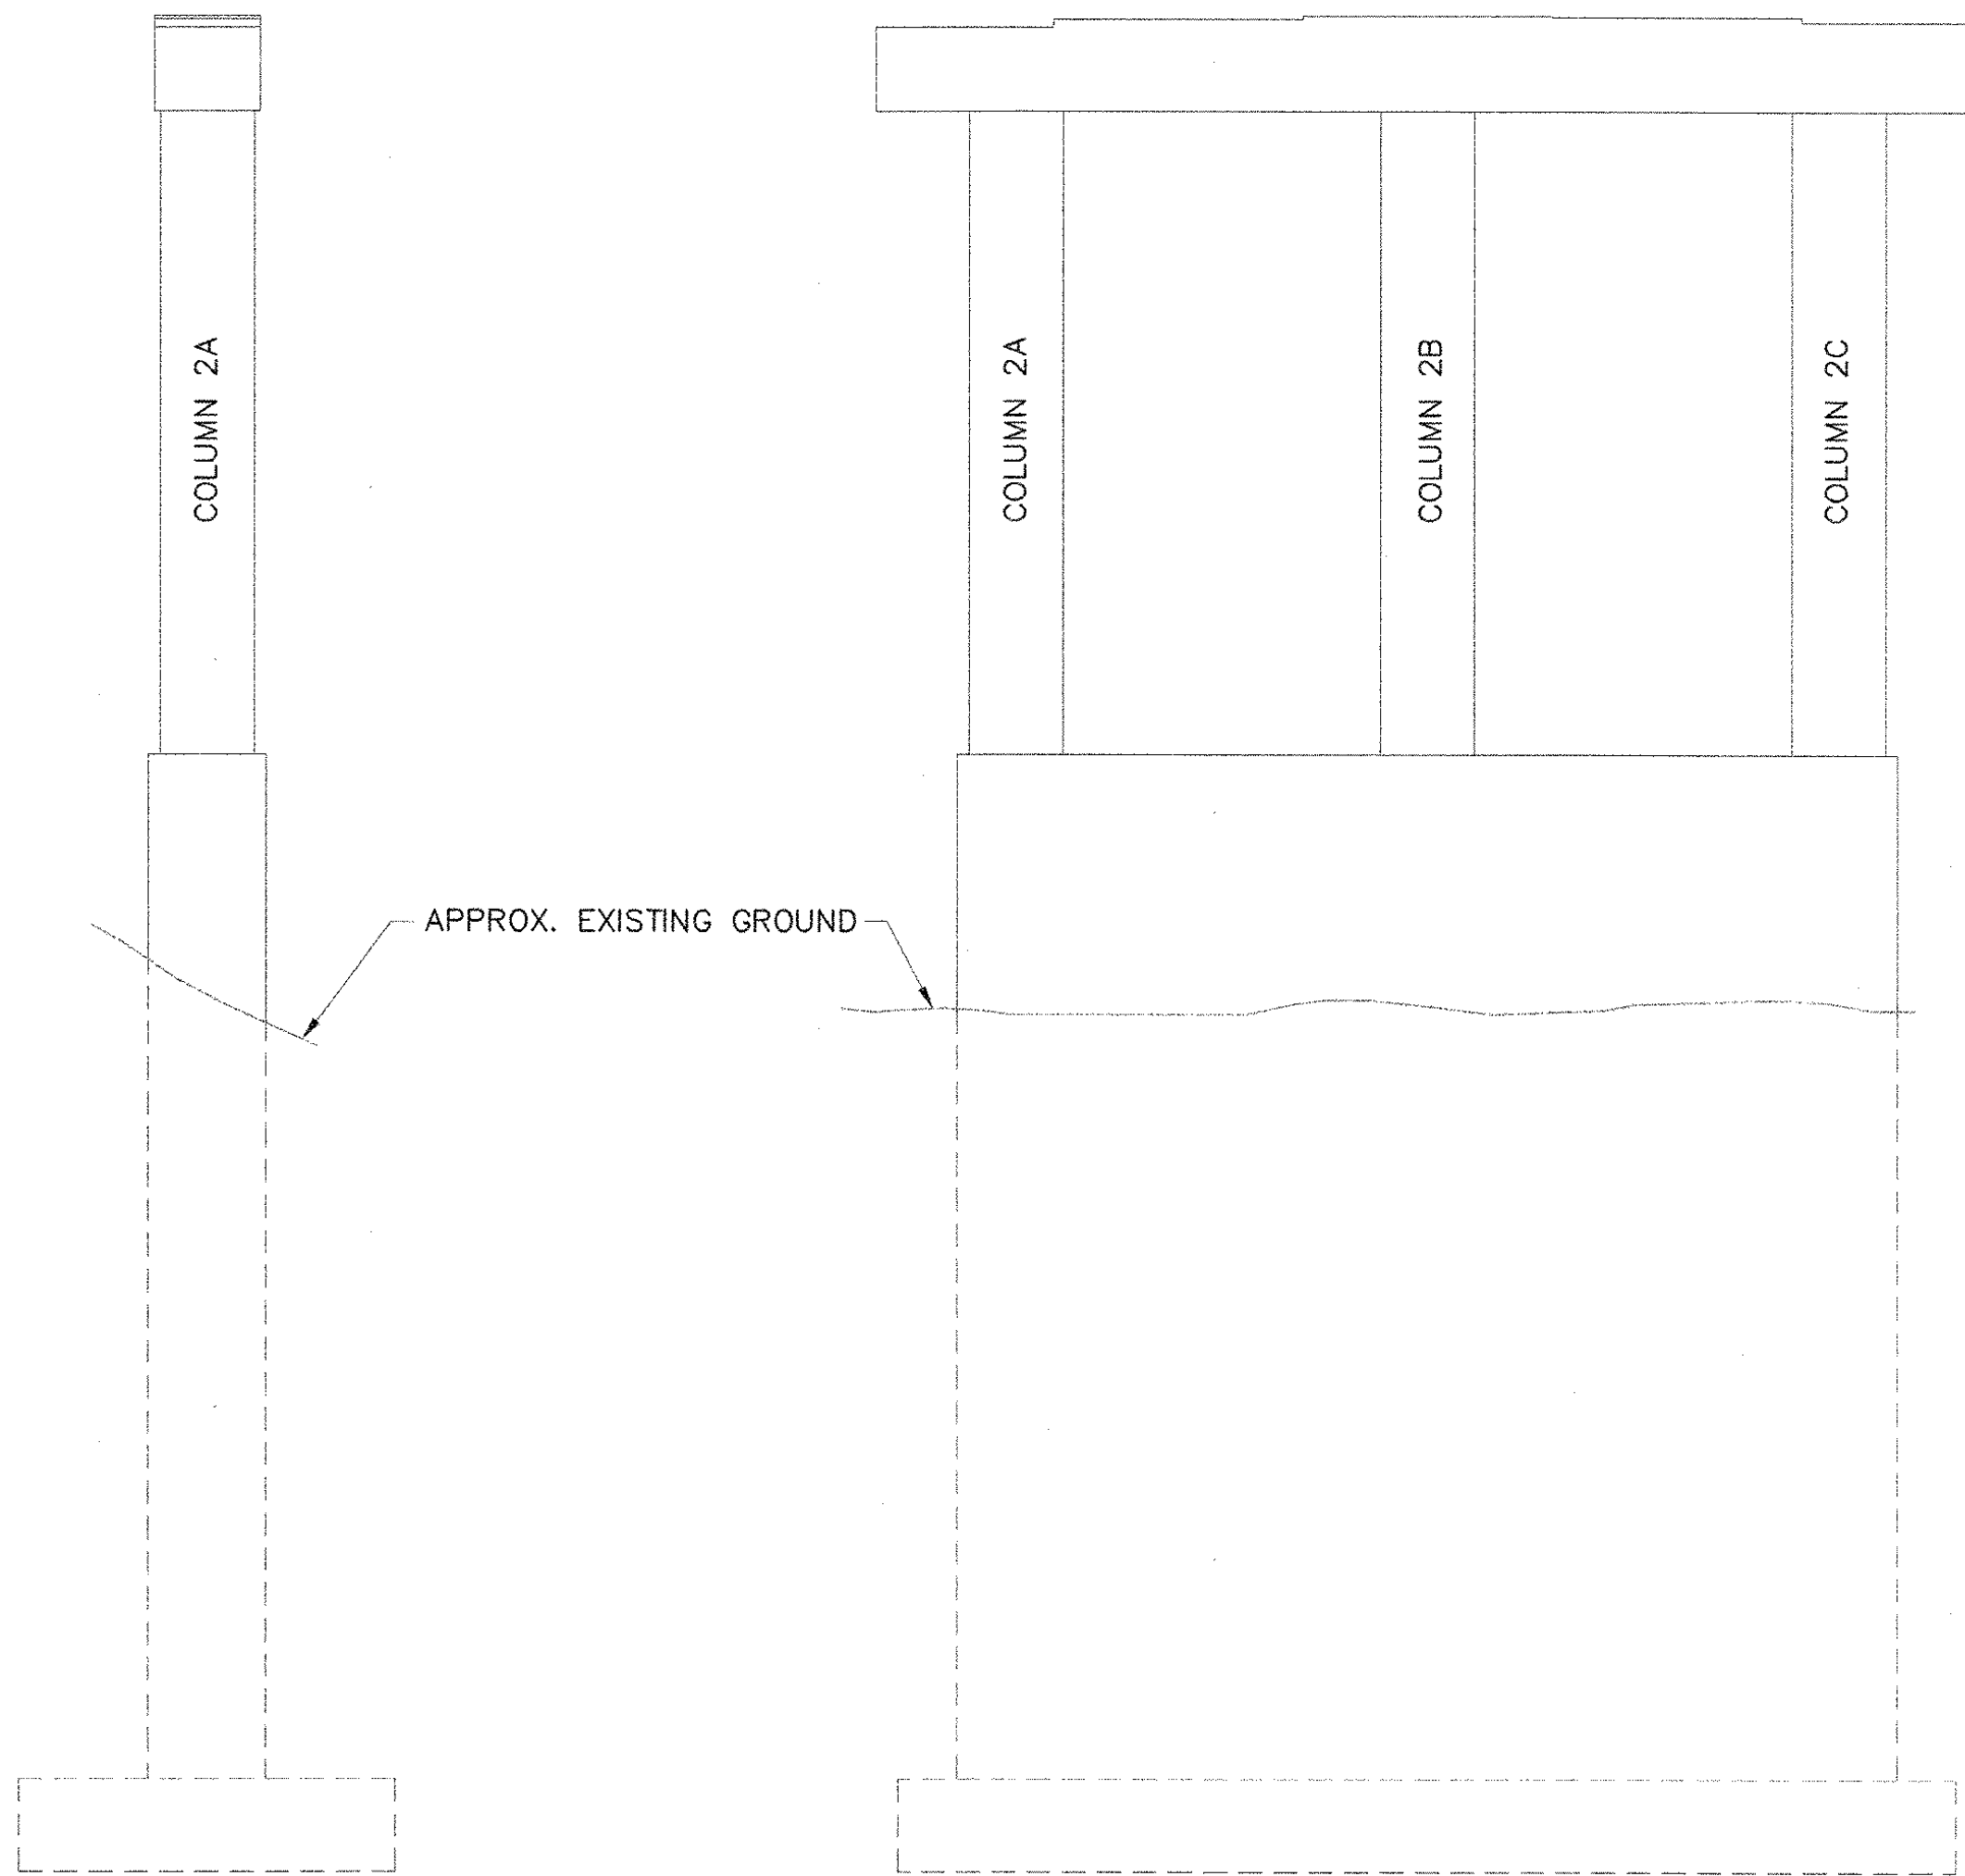

EAST END VIEW
SCALE: 1/8" = 1'-0"

NORTH ELEVATION
SCALE: 1/8" = 1'-0"

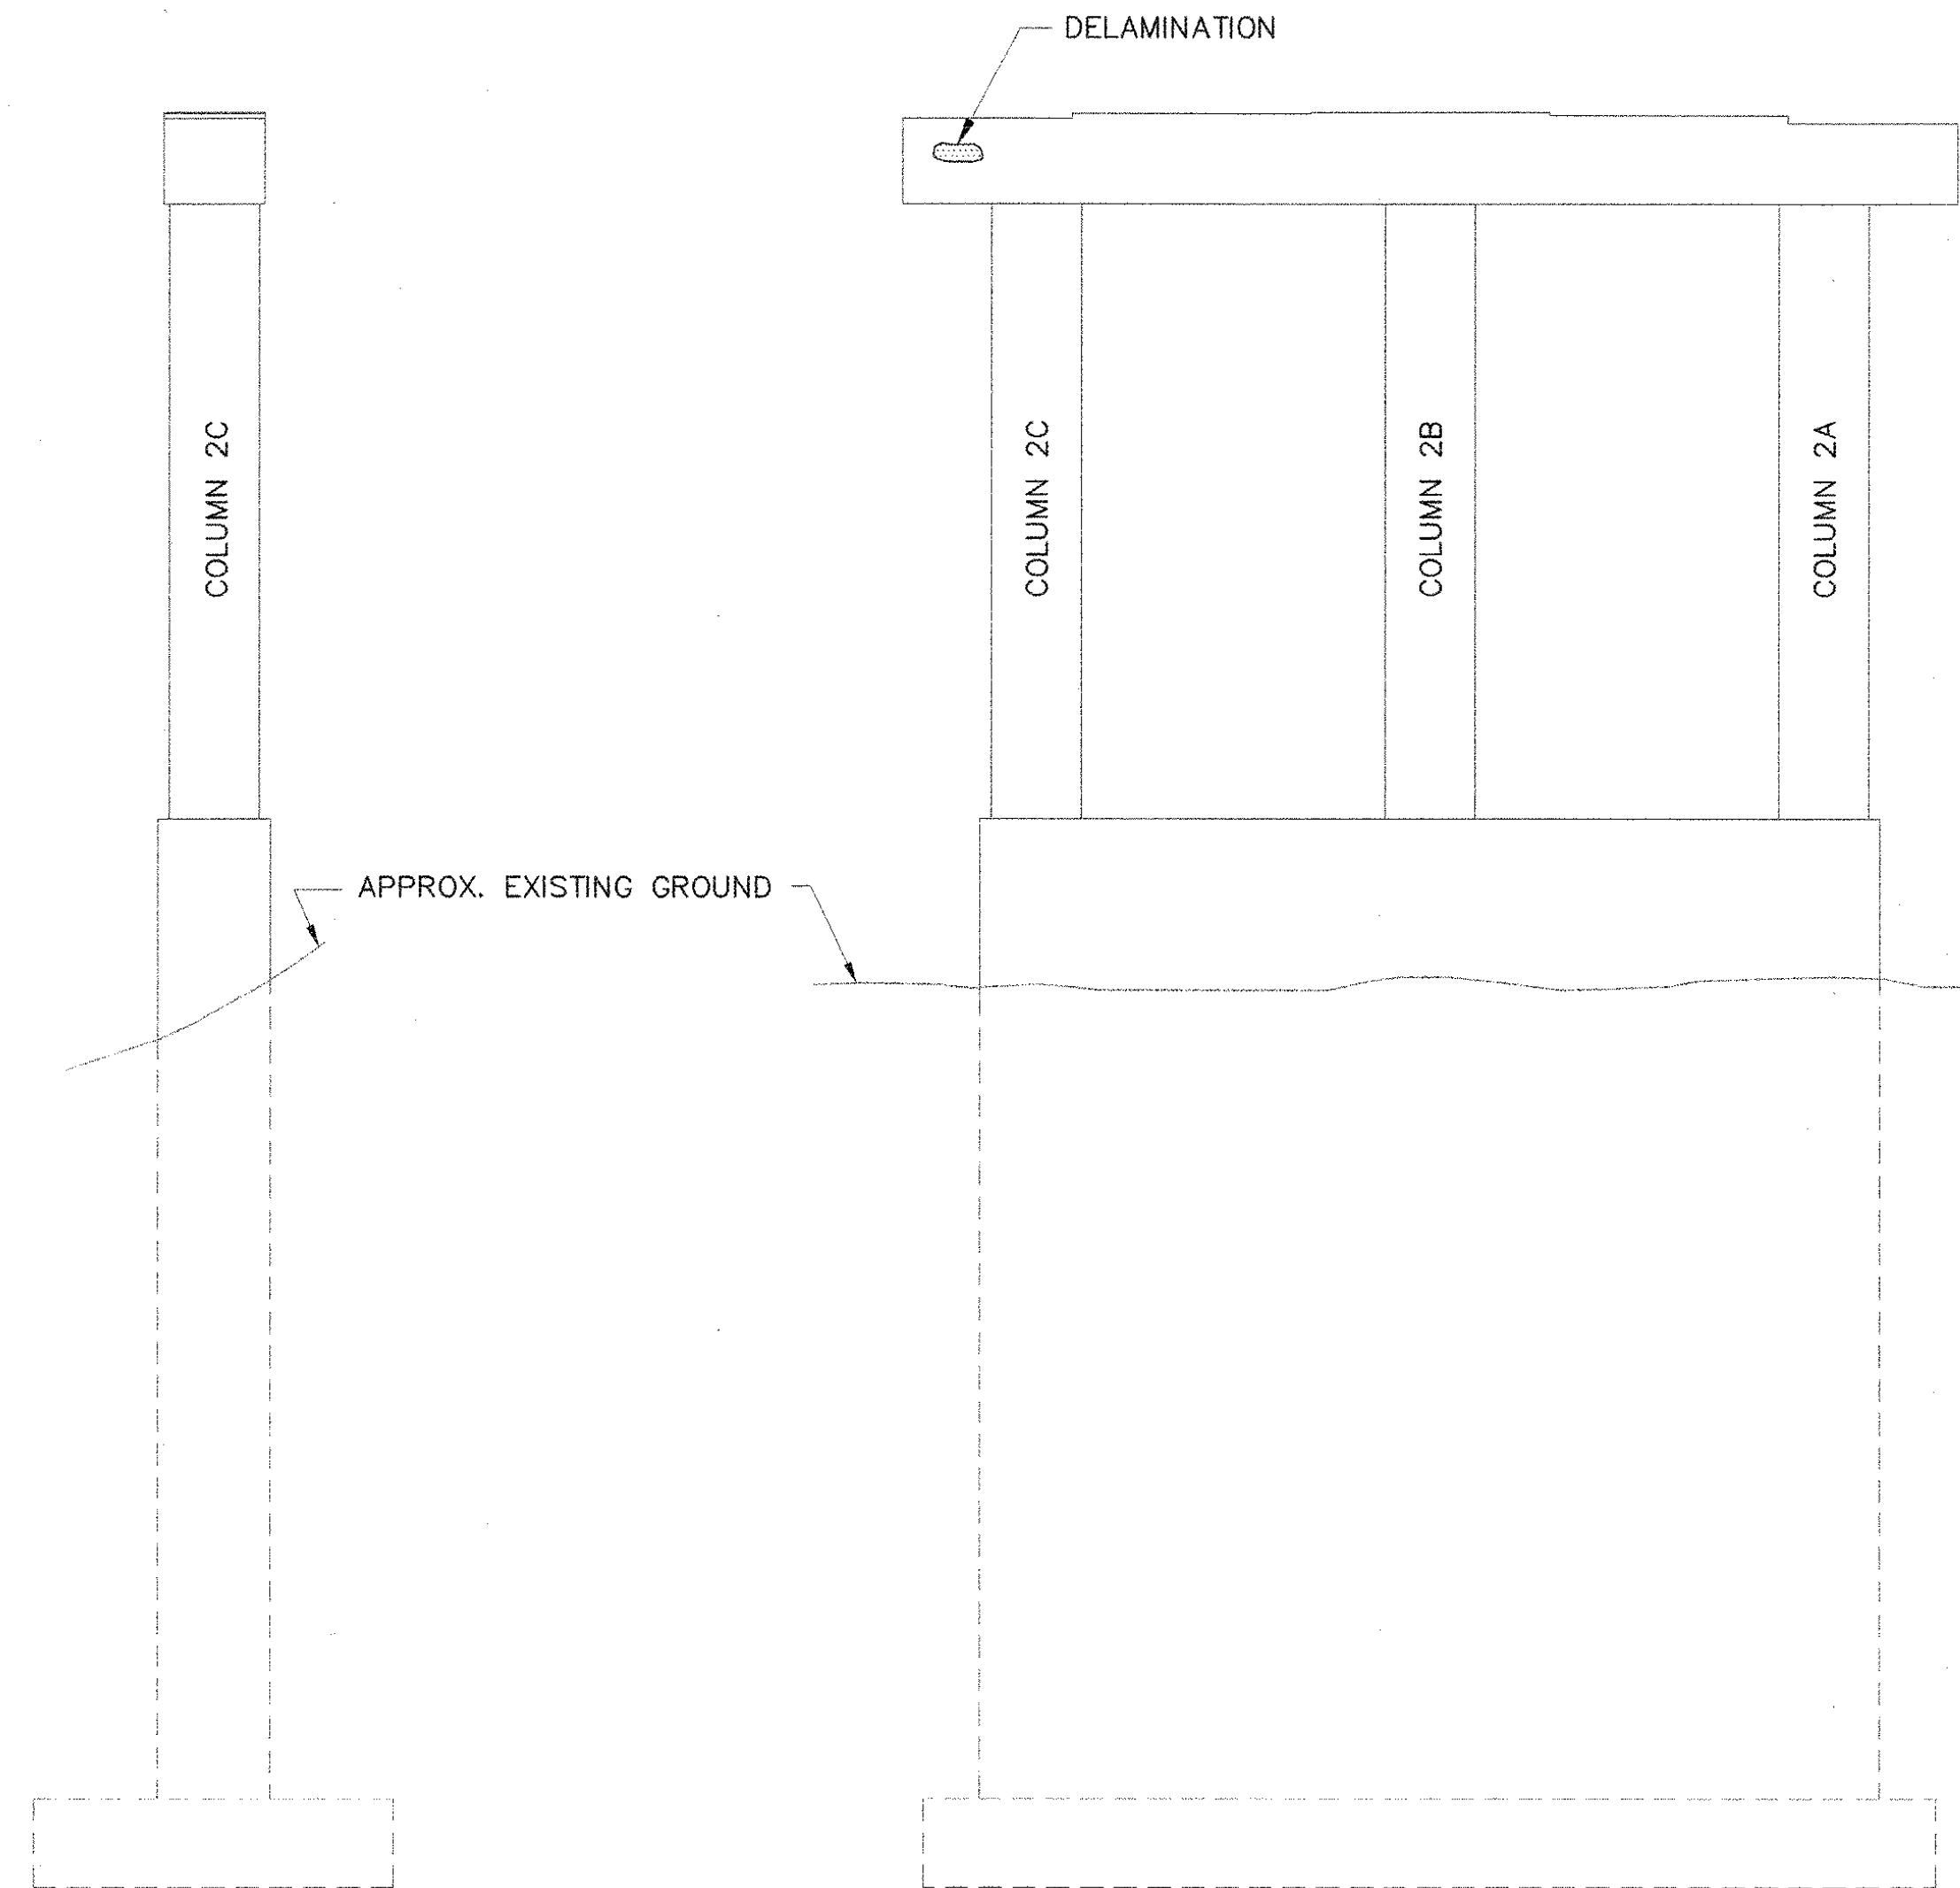

WEST END VIEW
SCALE: 1/8" = 1'-0"

SOUTH ELEVATION
SCALE: 1/8" = 1'-0"

- KEY:**
- DELAMINATED AREAS
 - SPALLED AREAS

- NOTES:**
1. ONLY PIERS WITH DEFICIENCIES NOTED DURING THE INSPECTION ARE SHOWN.
 2. SEE SHEET 22 FOR SUBSTRUCTURE CONCRETE REPAIR DETAILS.

VANASSE HANGEN BRUSTLIN, INC.

STATE OF VERMONT AGENCY OF TRANSPORTATION			
Town Of	HARTFORD	Bridge No.	11N
Highway No.	1-89 NB	Log Sta.	
		Surv. Sta.	
1-89 NB OVER WHITE RIVER, VT 14 & NECR			
PIER 2 REPAIR AREAS			
Designed By	T.S. BRYANT	Drawn By	B.J. MASSE
Checked By	S.M. HODGDON	Date	9/98
		Bridge Design Supervisor	C.D. BAKER Date 9/98
PROJECT	HARTFORD	PROJECT NO.	IR 089-1(13)
VHB Cad Filename	50699P2	Bridge Sheet No.	35
		Sheet	35 of 101