


APPROACH SLAB REPLACEMENT REVISIONS 6/99

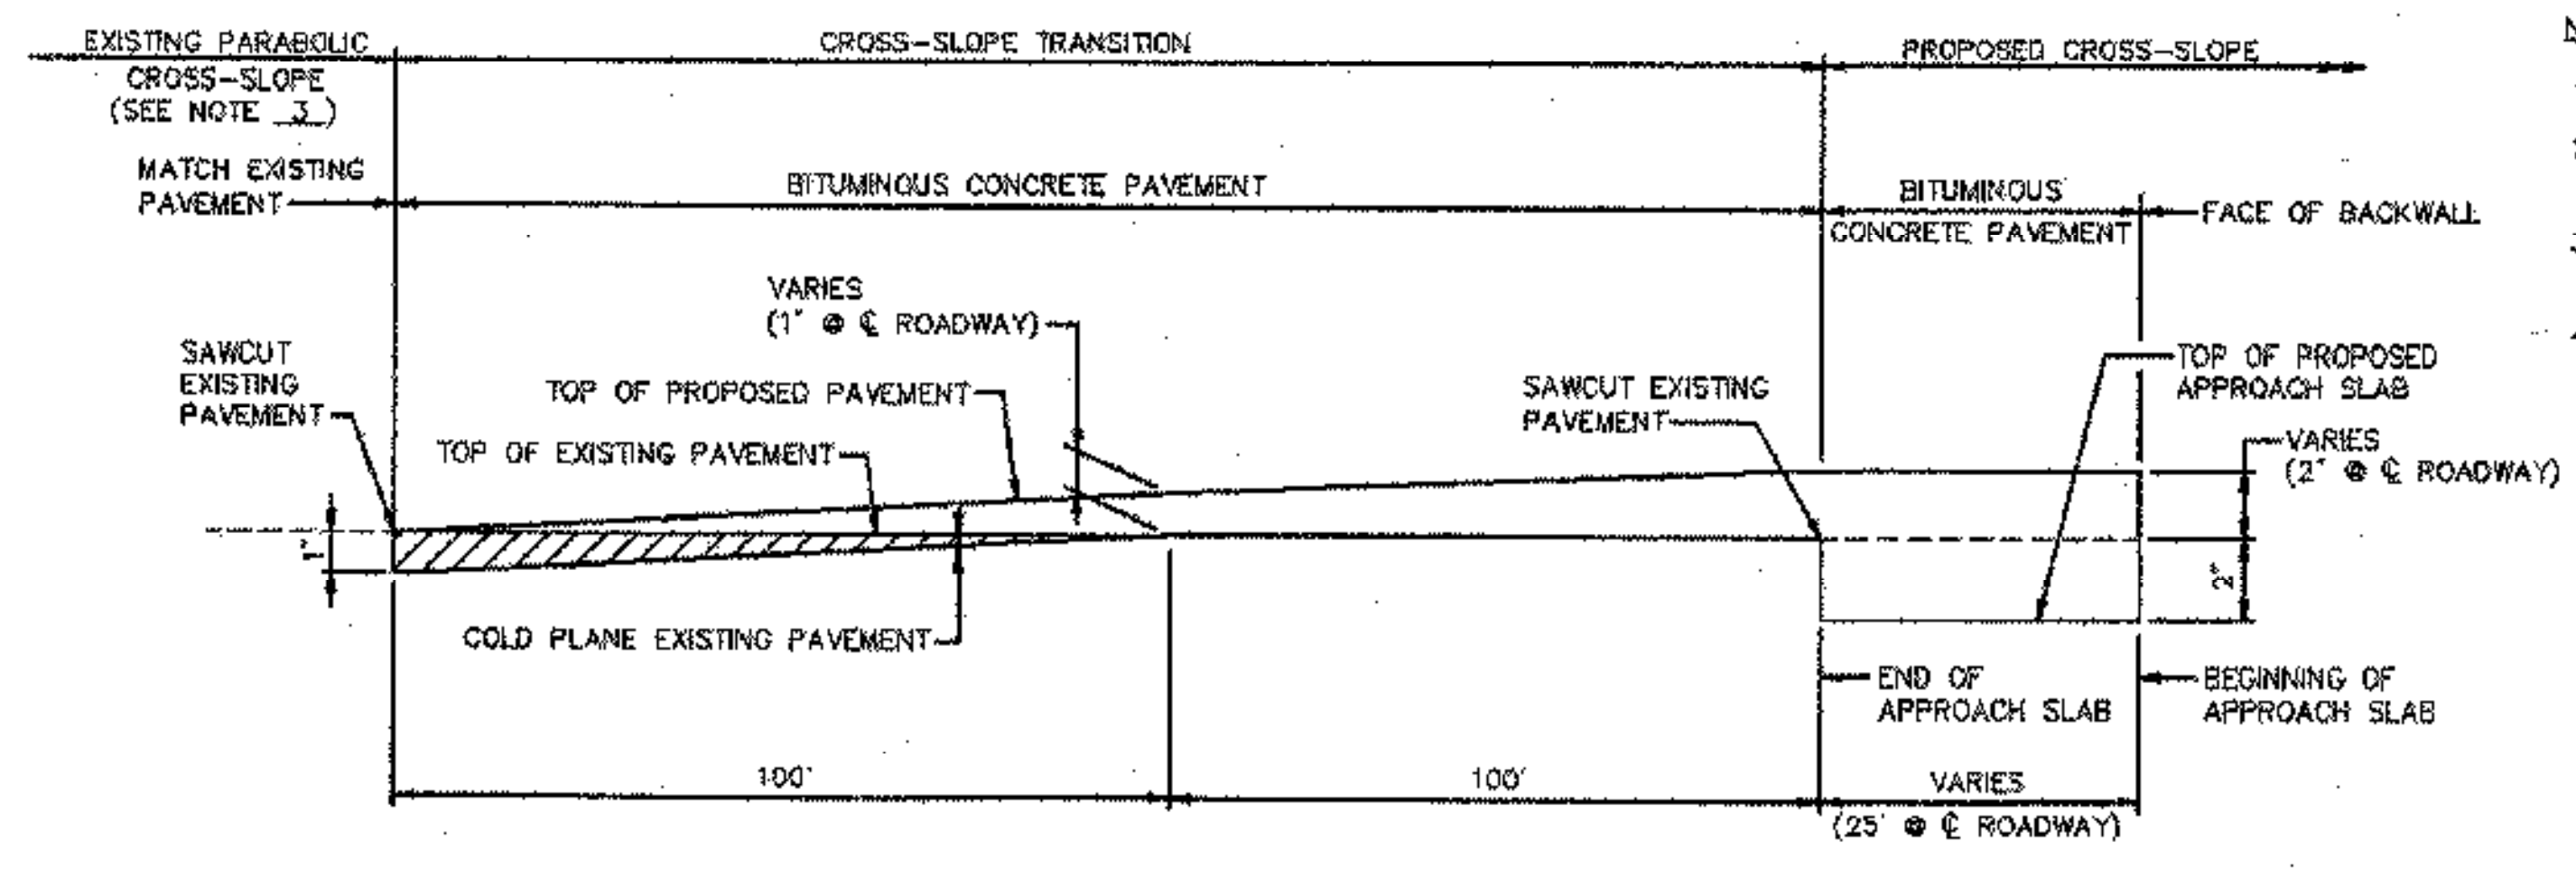

- NOTES:**
- SEE SHEET 32 FOR DETAILS OF APPROACH SLAB REMOVAL.
 - SEE SHEET 32 FOR DETAILS OF APPROACH SLAB RECONSTRUCTION.
 - BASED ON EXISTING BRIDGE PLANS, THE ROADWAY APPROACH SECTIONS ARE ASSUMED TO HAVE A PARABOLIC CROSS SLOPE.
 - BOTH APPROACH SLABS ON BRIDGE 11N AND BRIDGE 11S SHALL BE REPLACED ACCORDING TO THE NOTES AND DETAILS ON THIS SHEET.

STATE OF VERMONT AGENCY OF TRANSPORTATION	
Town Of HARTFORD	Bridge No. 11N & S
Highway No. I-89 NB & SB	Log Sta.
I-89 NB & SB OVER WHITE RIVER, VT 14 & NECR	
APP. SLAB PLANS & PVMT. TRANSITION DETAILS	
Designed By T.S. BRYANT	Drawn By B.J. MASSE
Checked By S.M. HODGDON	Date 9/98
C.D. BAKER Date 6/99	
PROJECT HARTFORD	PROJECT NO. IR 089-1(13)
VHB Cad Filename 5089ASDRrev	
Bridge Sheet No. 39R	Sheet 39R of 101

VANASSE HANGEN BRUSTLIN, INC.